


TOMHICKEN COLLIERY

N^o 31 SECTION.

LOOKING EAST.

SCALE 1"=100'

600' West of East Land Line.

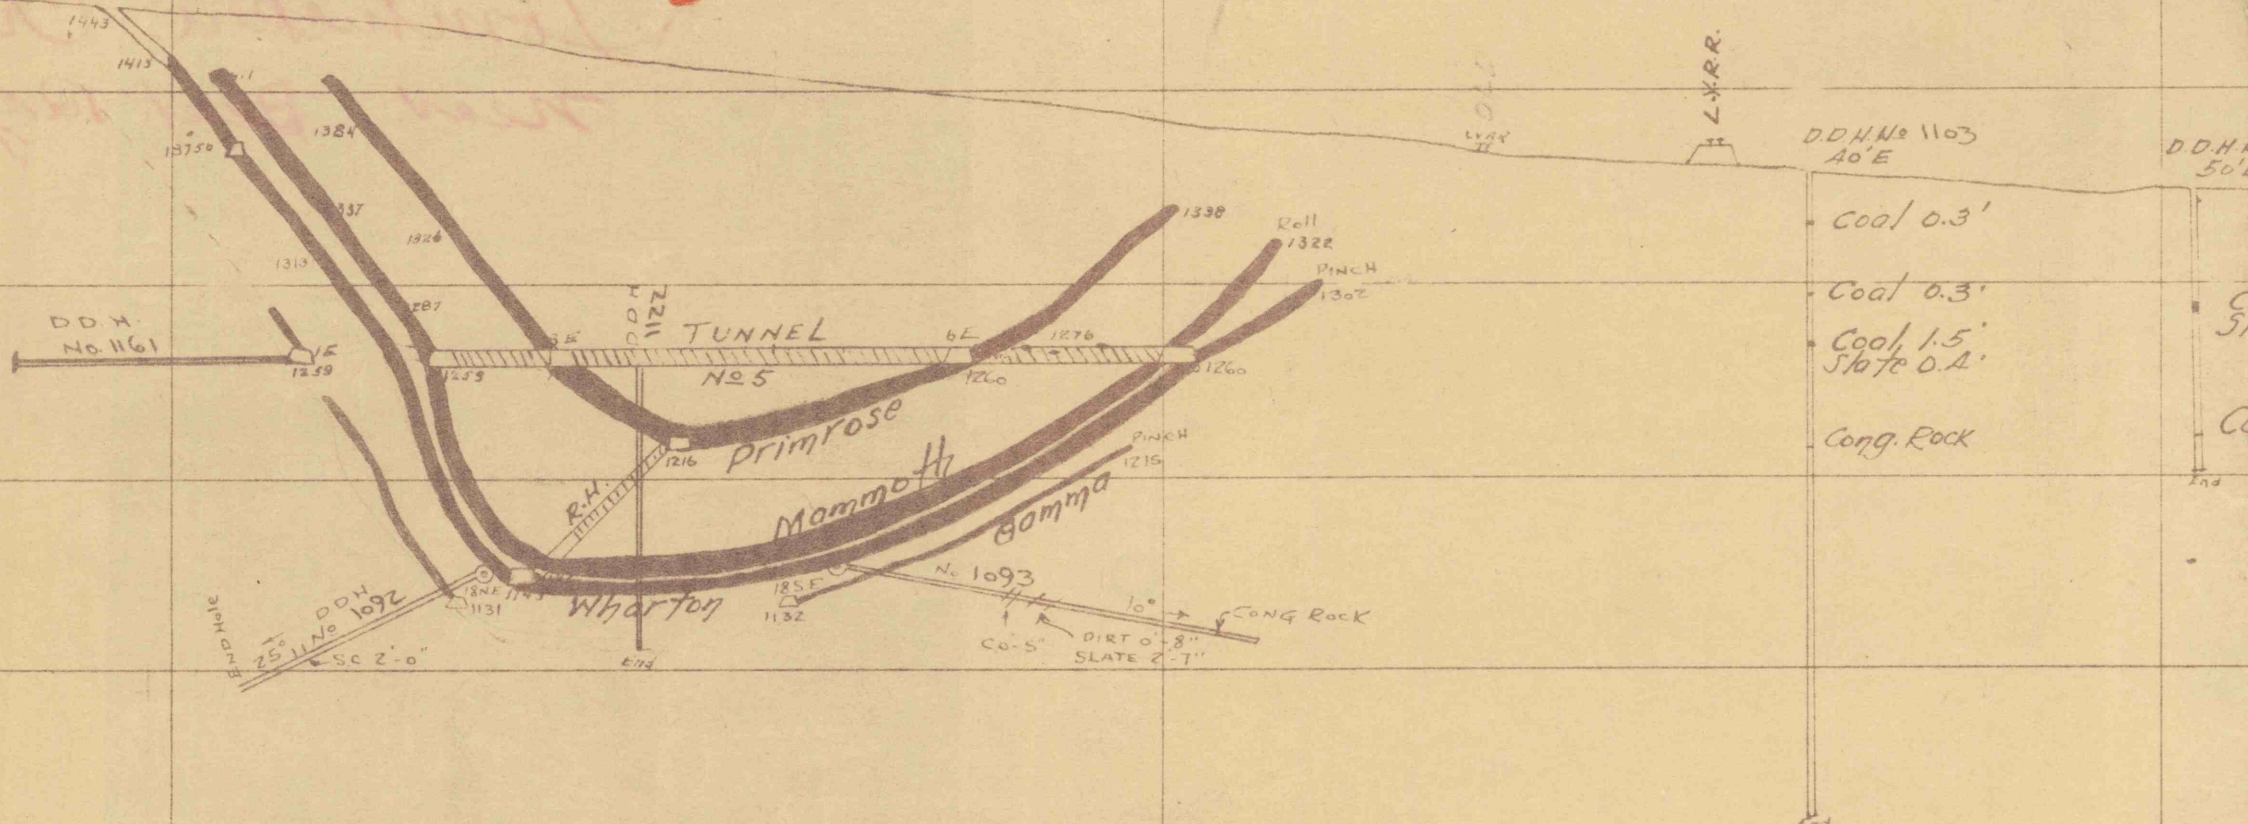

EASTERN MIDDLE Field..

Tomhicken Colliery.

N^o 32 SECTION.


LOOKING EAST.

100' West of East Land Line

SUGAR LOAF TWP.,

LUZERNE County PA.,

7. BLACK CREEK DISTRICT. NEAR BLACK RIDGE BARRIER.

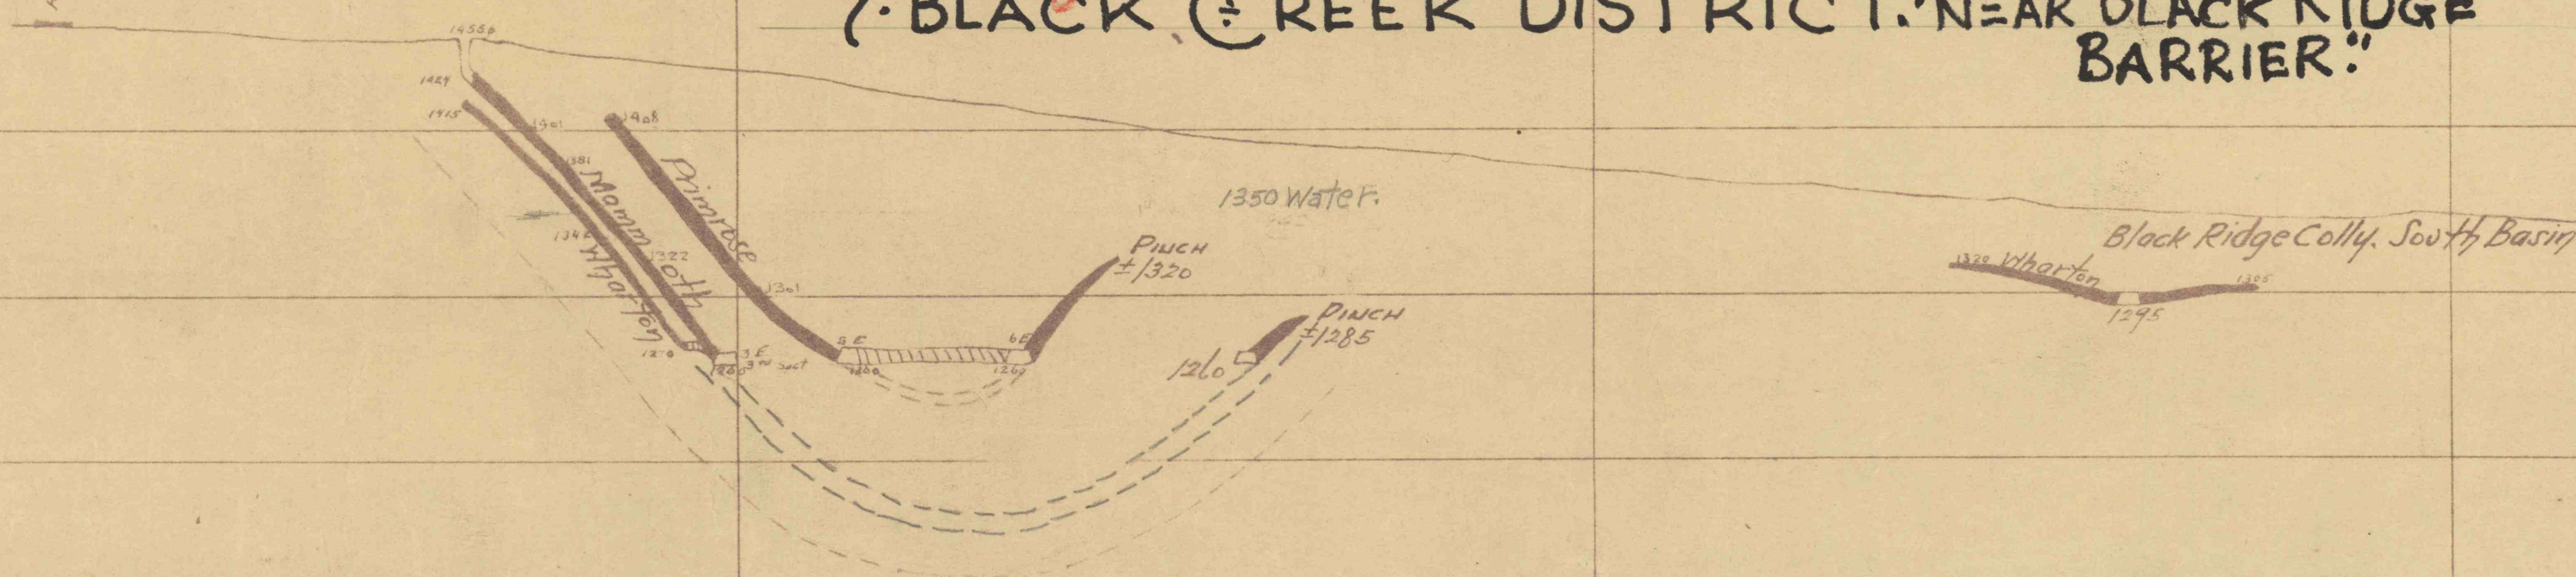

1-OF-2. SHEET.

Scale 1"=100'