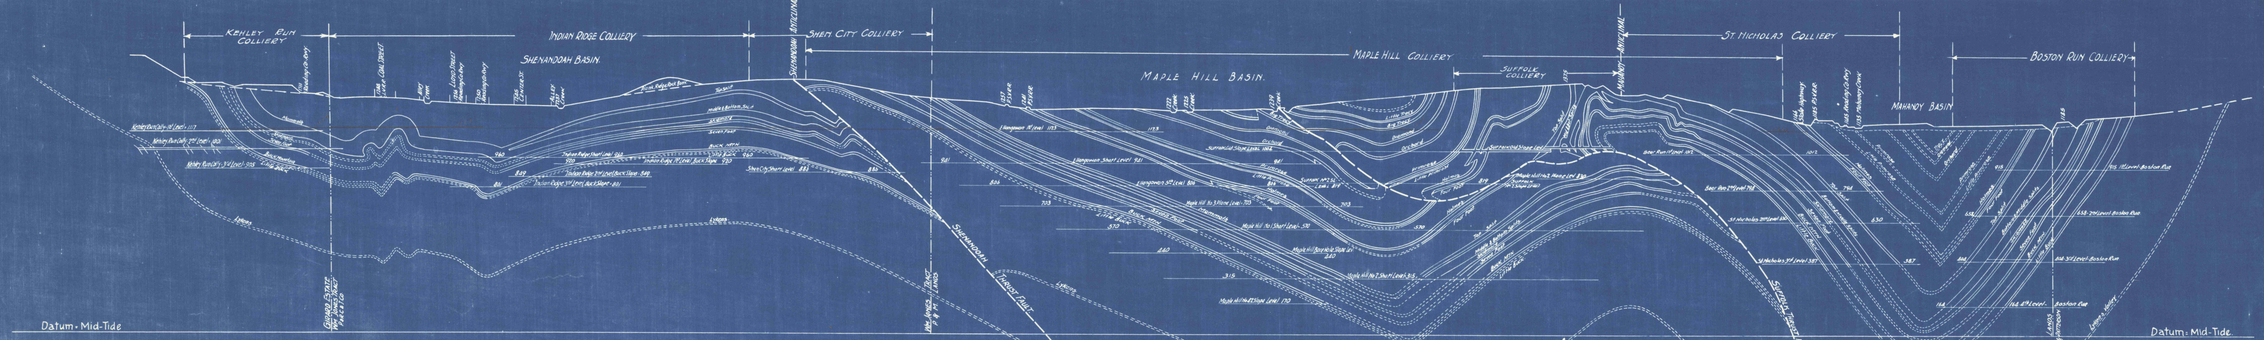

North

CROSS-SECTION
THROUGH
SHENANDOAH & MAHANOY BASINS
500 ft EAST OF KEHLEY RUN HOISTING SLOPE,
1000 ft WEST OF INDIAN RIDGE,
840 ft EAST OF SHENANDOAH CITY SHAFT,
4200 ft WEST OF MAPLE HILL SHAFT.
1000 ft EAST OF BOSTON RUN HOISTING SLOPE
Scale: 1" = 300'

∴ Western Middle Field ∴
West Mahanoy Twp. Schuylkill County, Pa.,
11-West. Mah. District. P. R. C. & I. Co.,

∴ SHEET: 3 of 3 ∴
SECTION ∴ C ∴