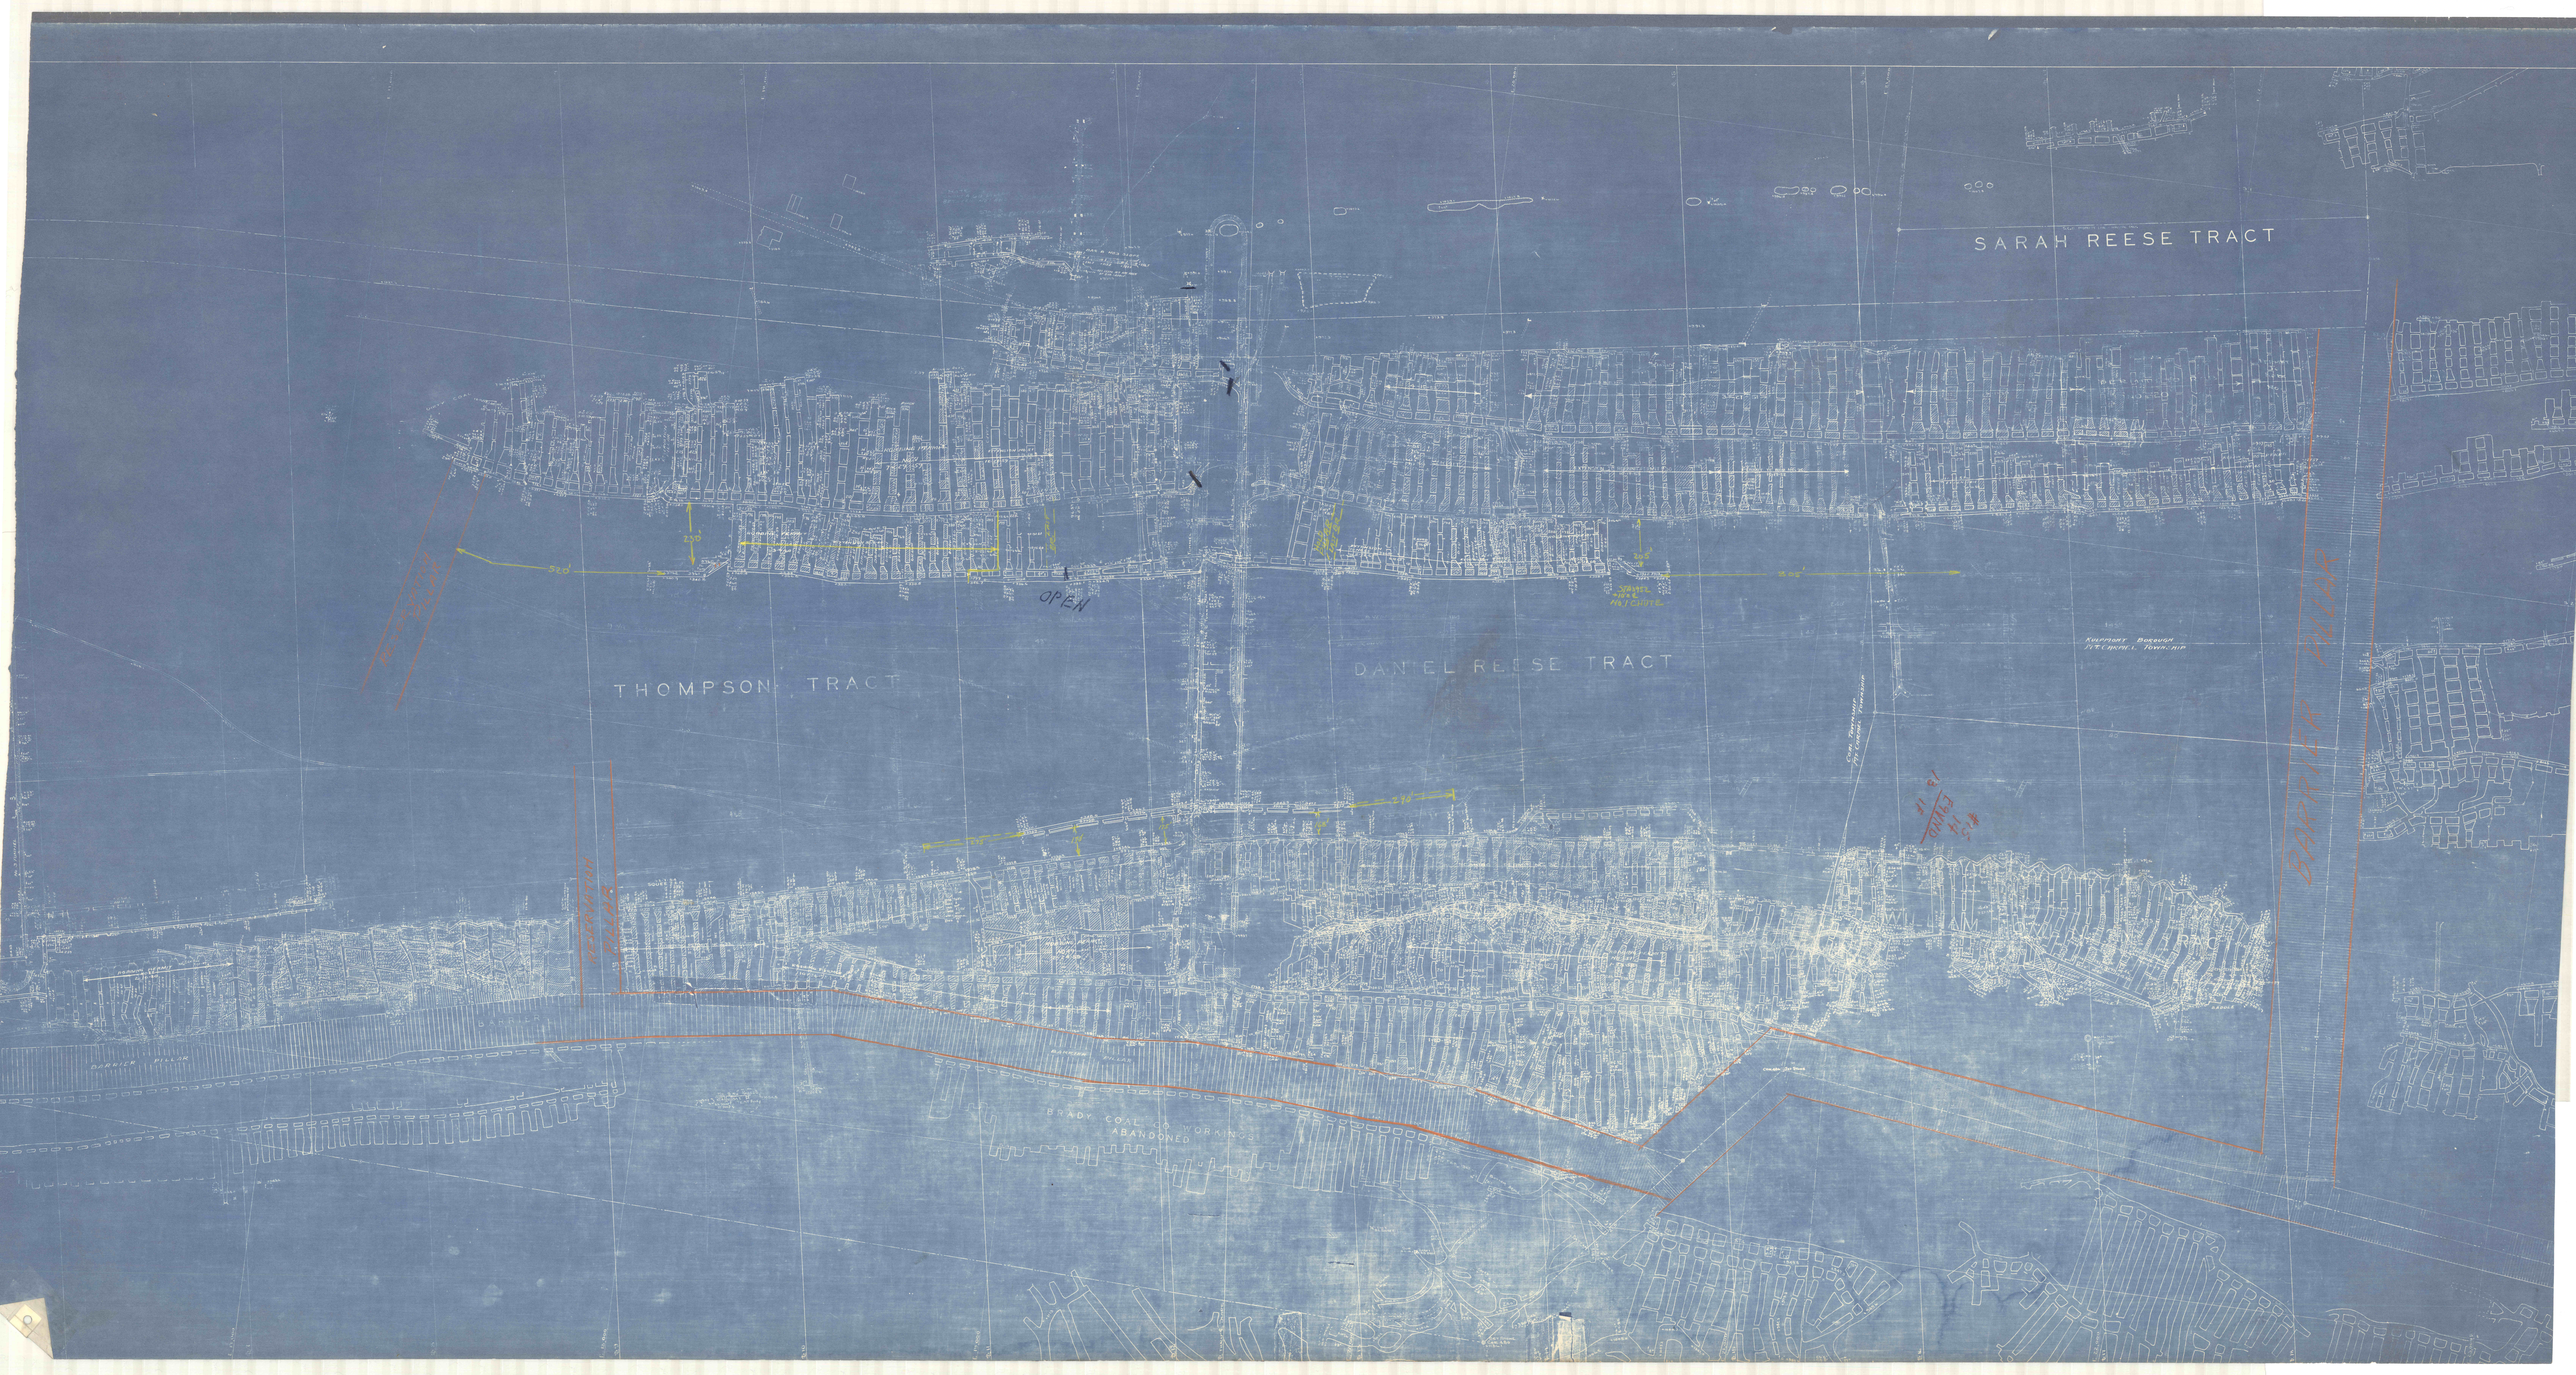
SARAH REESE TRACT
THOMPSON TRACT
DANIEL REESE TRACT
OPEN
KEARSARGE
KEARSARGE
BRADY COAL CO WORKINGS ABANDONED
KEARSARGE
KEARSARGE
KEARSARGE