


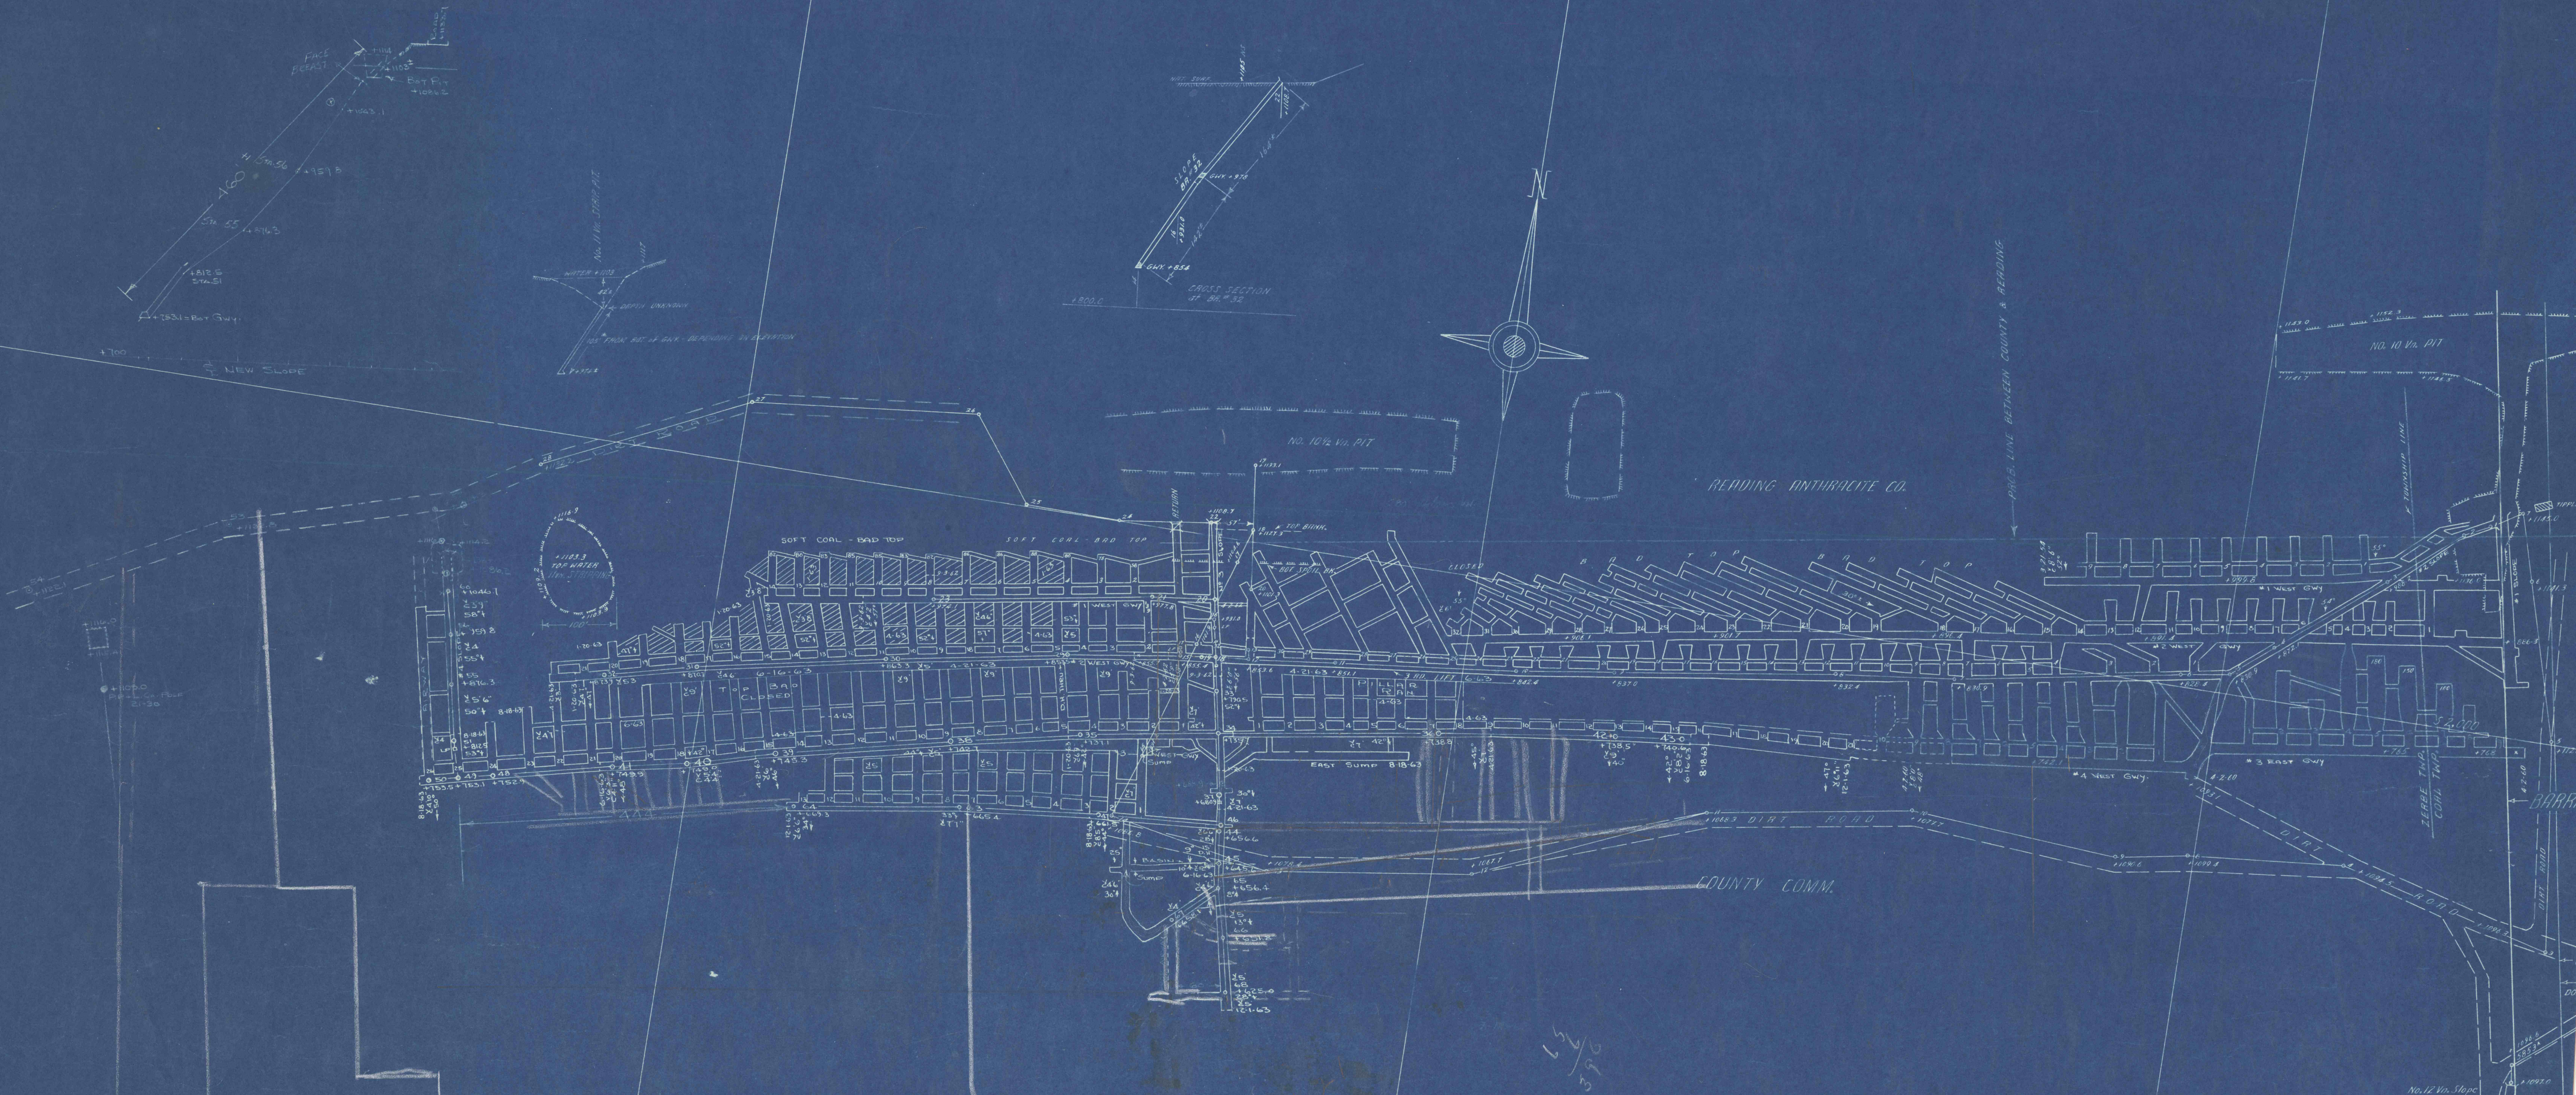

MAP SHOWING MINING OPERATION ZERKO COAL CO.
NO. 11 VEIN - ZERBE TWP.
SCALE 1"=100'

