


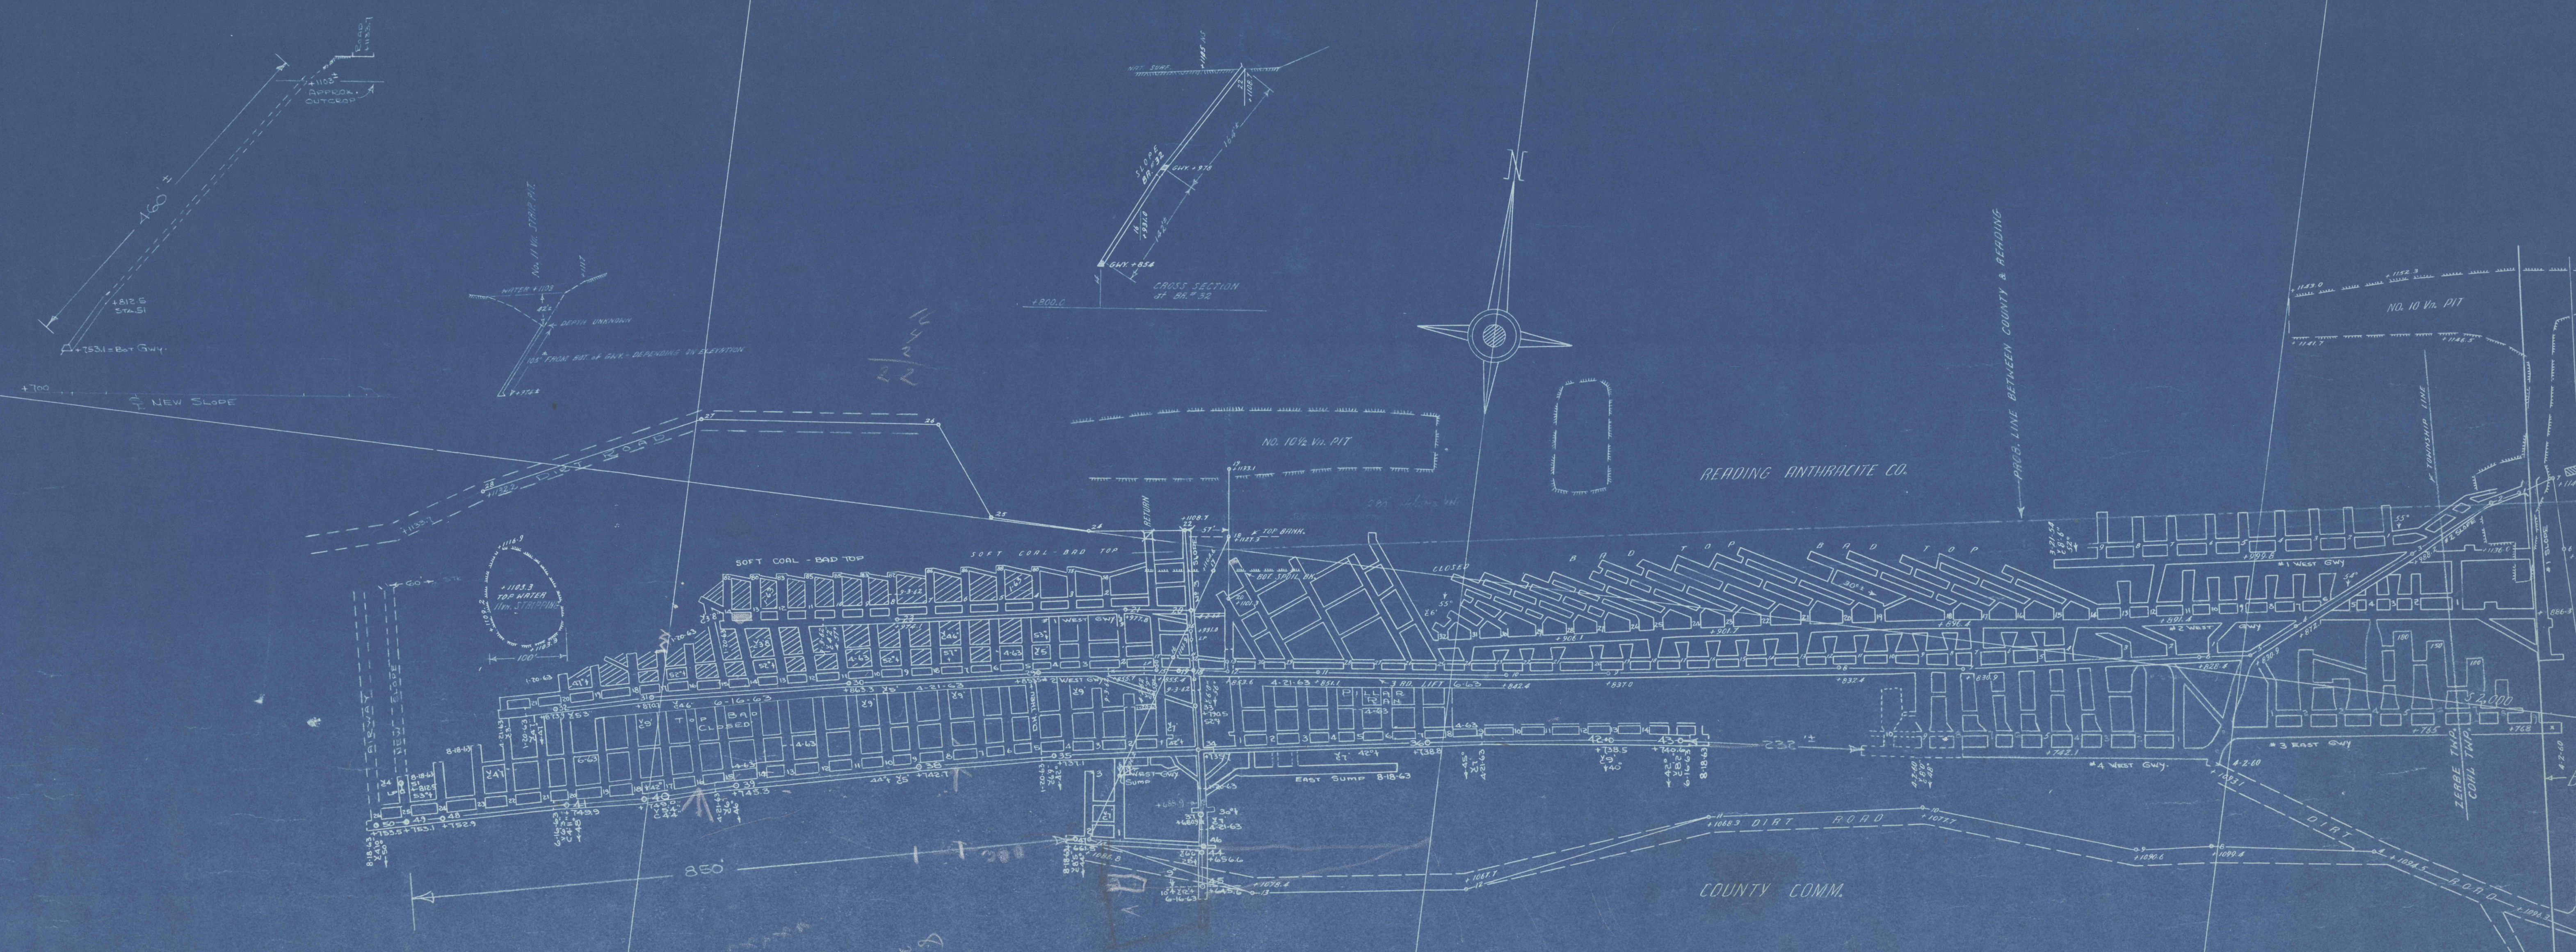

MAP SHOWING MINING OPERATION of the ZERBE COAL CO.,
in the No. 11 Vm - Zerbe Township.
SCALE 1" = 100' 8-18-63

