


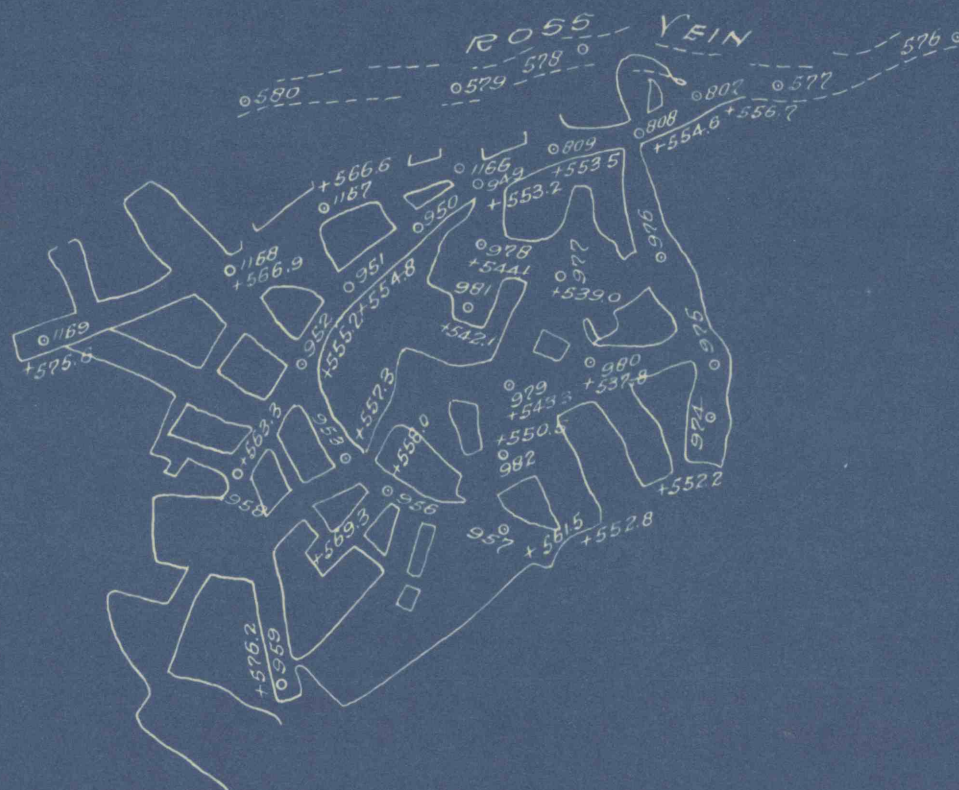

NORTHERN FIELD..
 - TOP ROSS VEIN - E.S. STACKHOUSE (NO SCALE)
 - July 1920 -
 COAL CO. COLL'Y.
 SALEM TWP., LUZERNE COUNTY,
 SHICKSHINNY, PA.,

ME
 ME NOV 20 1974

SHEET: 3-OF-4