


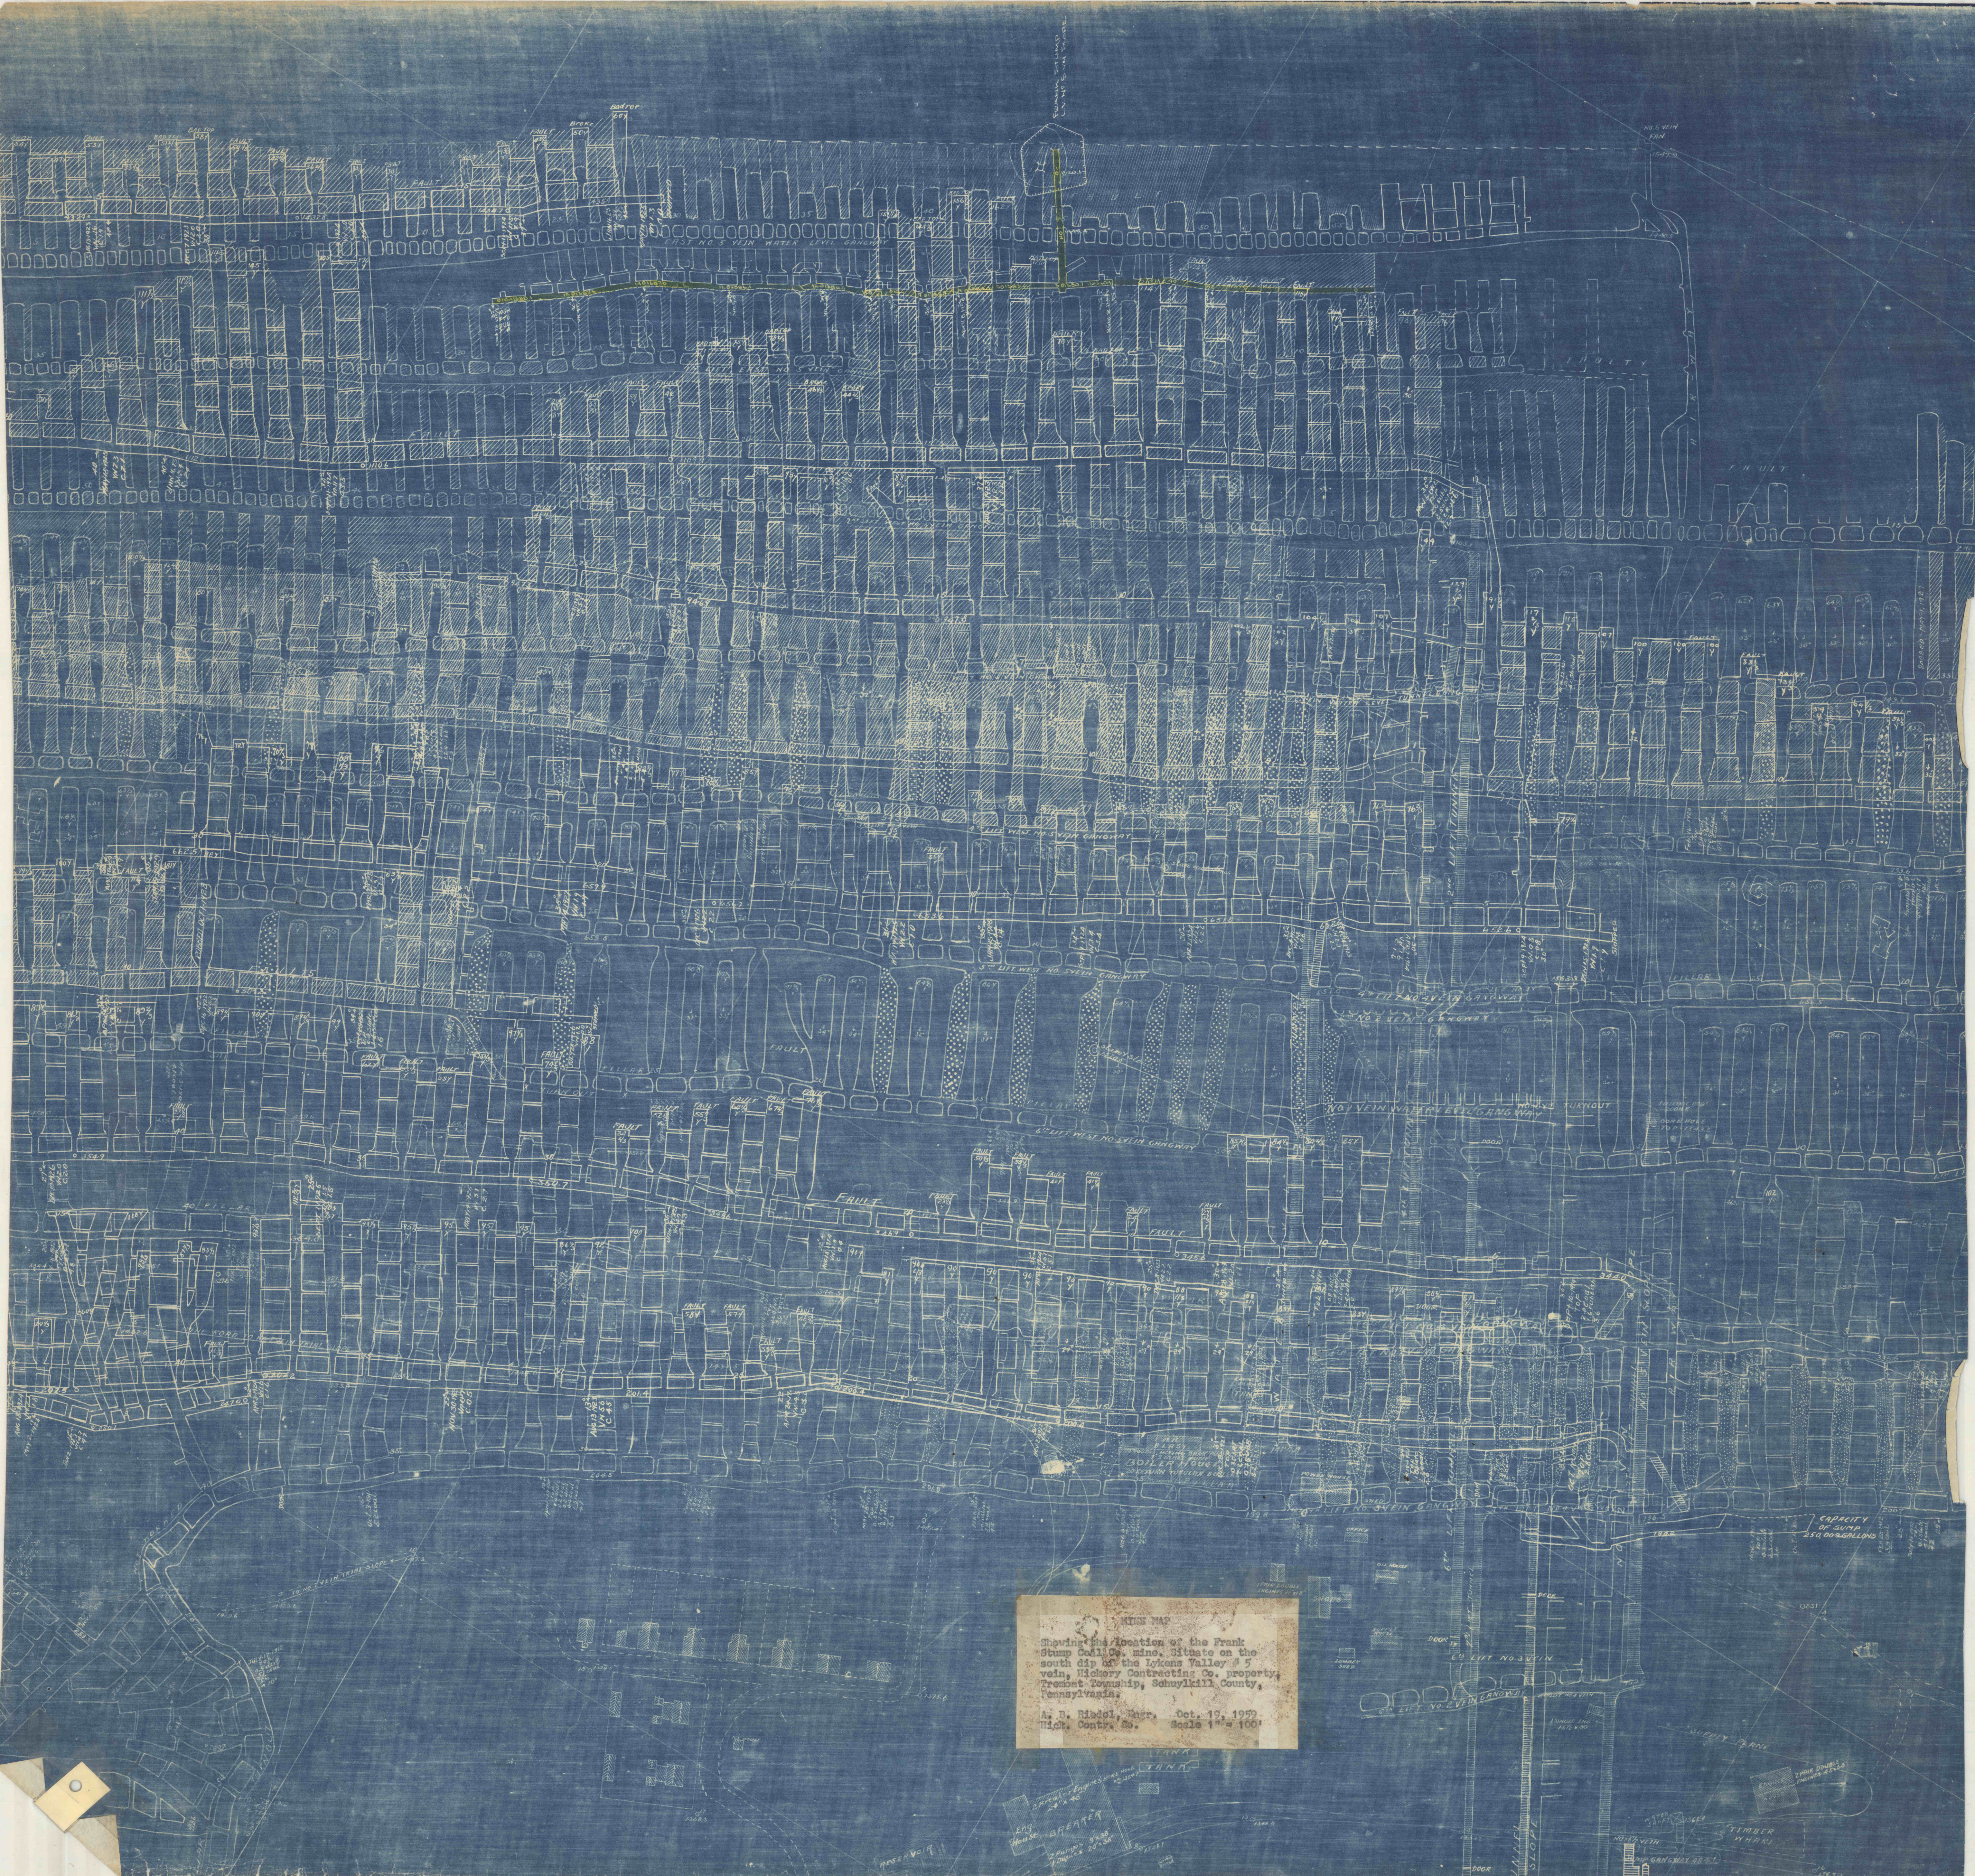

MINES MAP
Showing the location of the Frank
Stump Coal Co. mine, situated on the
south dip of the Lykens Valley # 5
vein, Hickory Contracting Co. property,
Tremont Township, Schuylkill County,
Pennsylvania.
A. D. Madol, Eng. Oct. 19, 1909
Hick. Contr. Co. Scale 1" = 100'