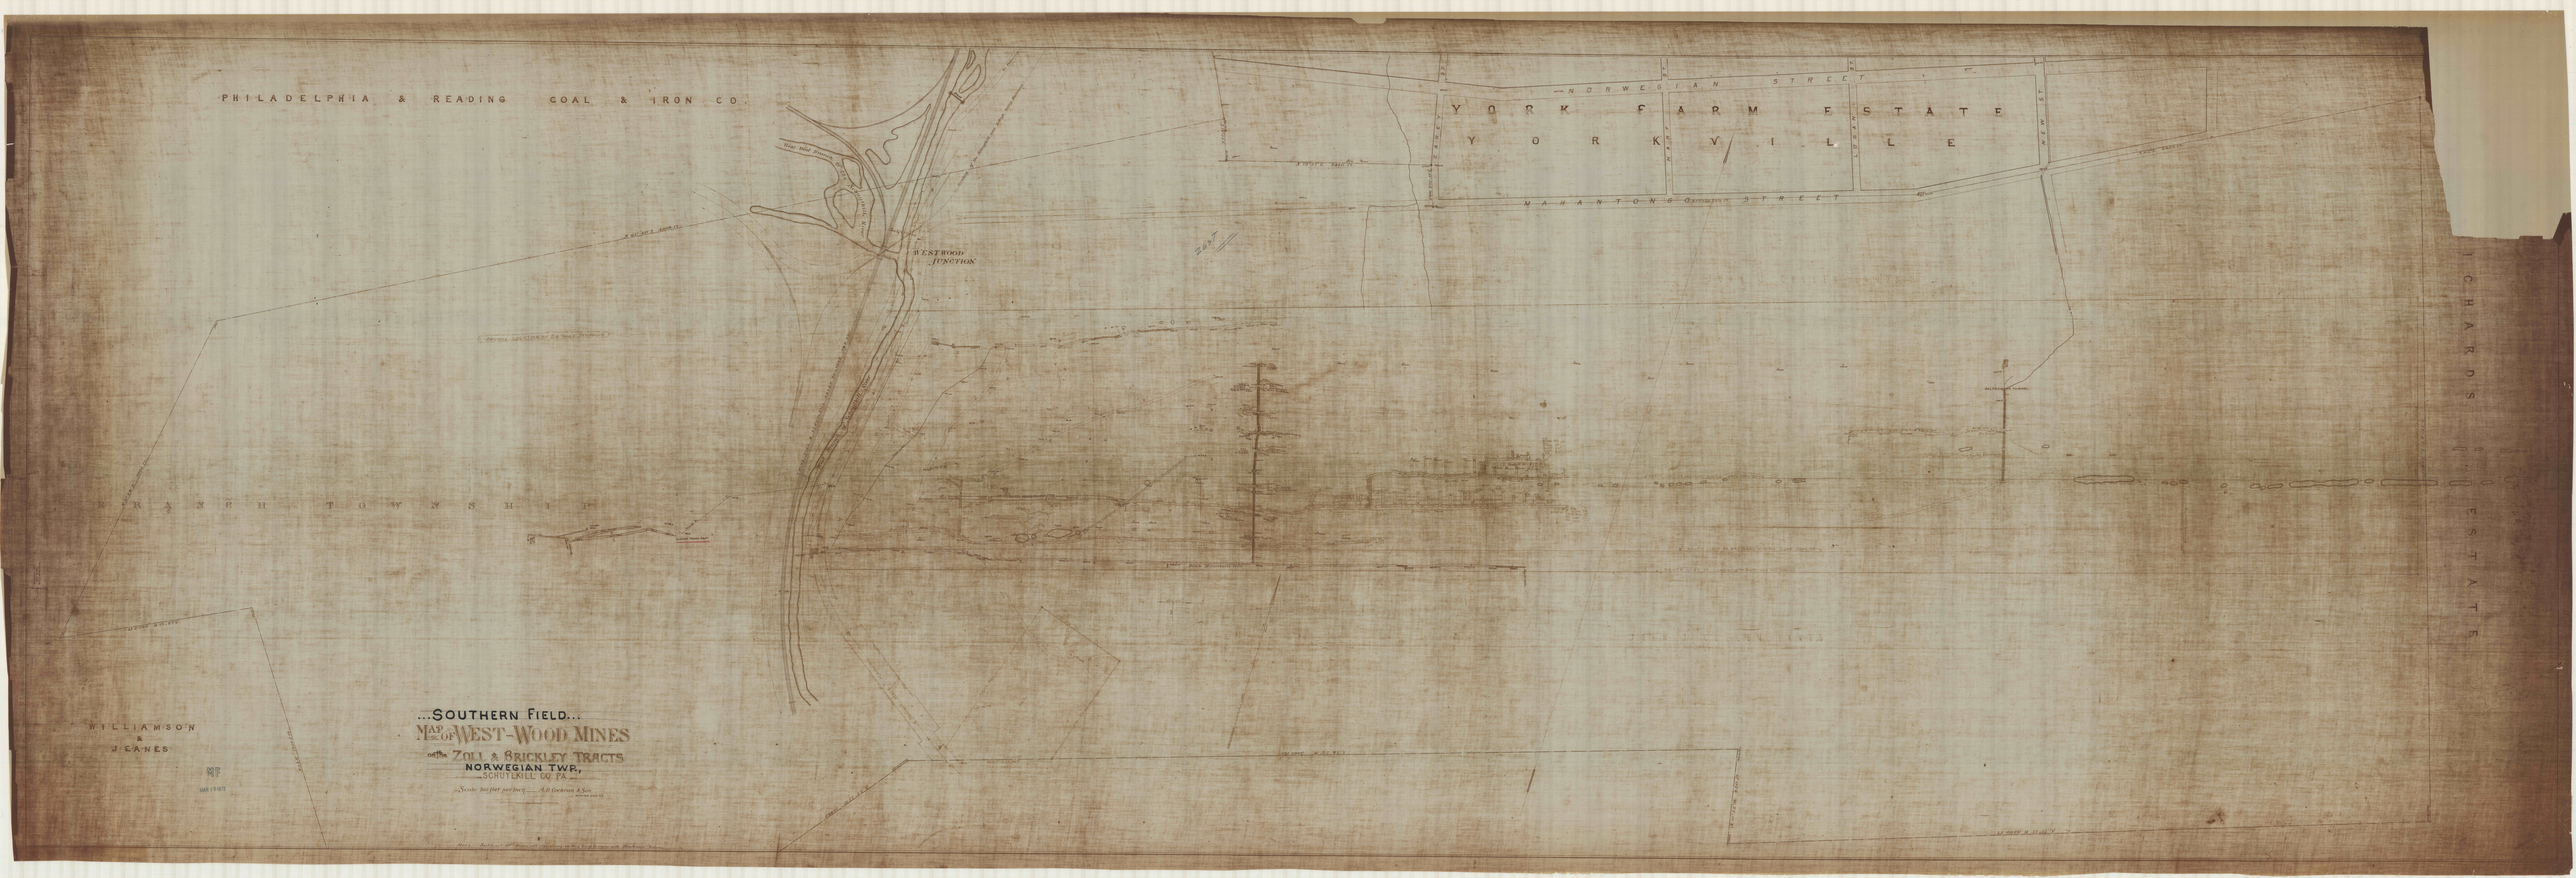

PHILADELPHIA & READING COAL & IRON CO.
WEST WOOD JUNCTION
NORWEGIAN STREET
YORK FARM ESTATE
YORKVILLE
MAHANTONGO STREET
BRANCH TOWNSHIP
WILLIAMSON & JEANES
...SOUTHERN FIELD...
MAP OF WEST-WOOD MINES
of the ZOLL & BRICKLEY TRACTS
NORWEGIAN TWP.
SCHUYLKILL CO. PA.
RICHARDS ESTATE