


MAY 7 1975

MF

200
301 TUNNELS NESQ.

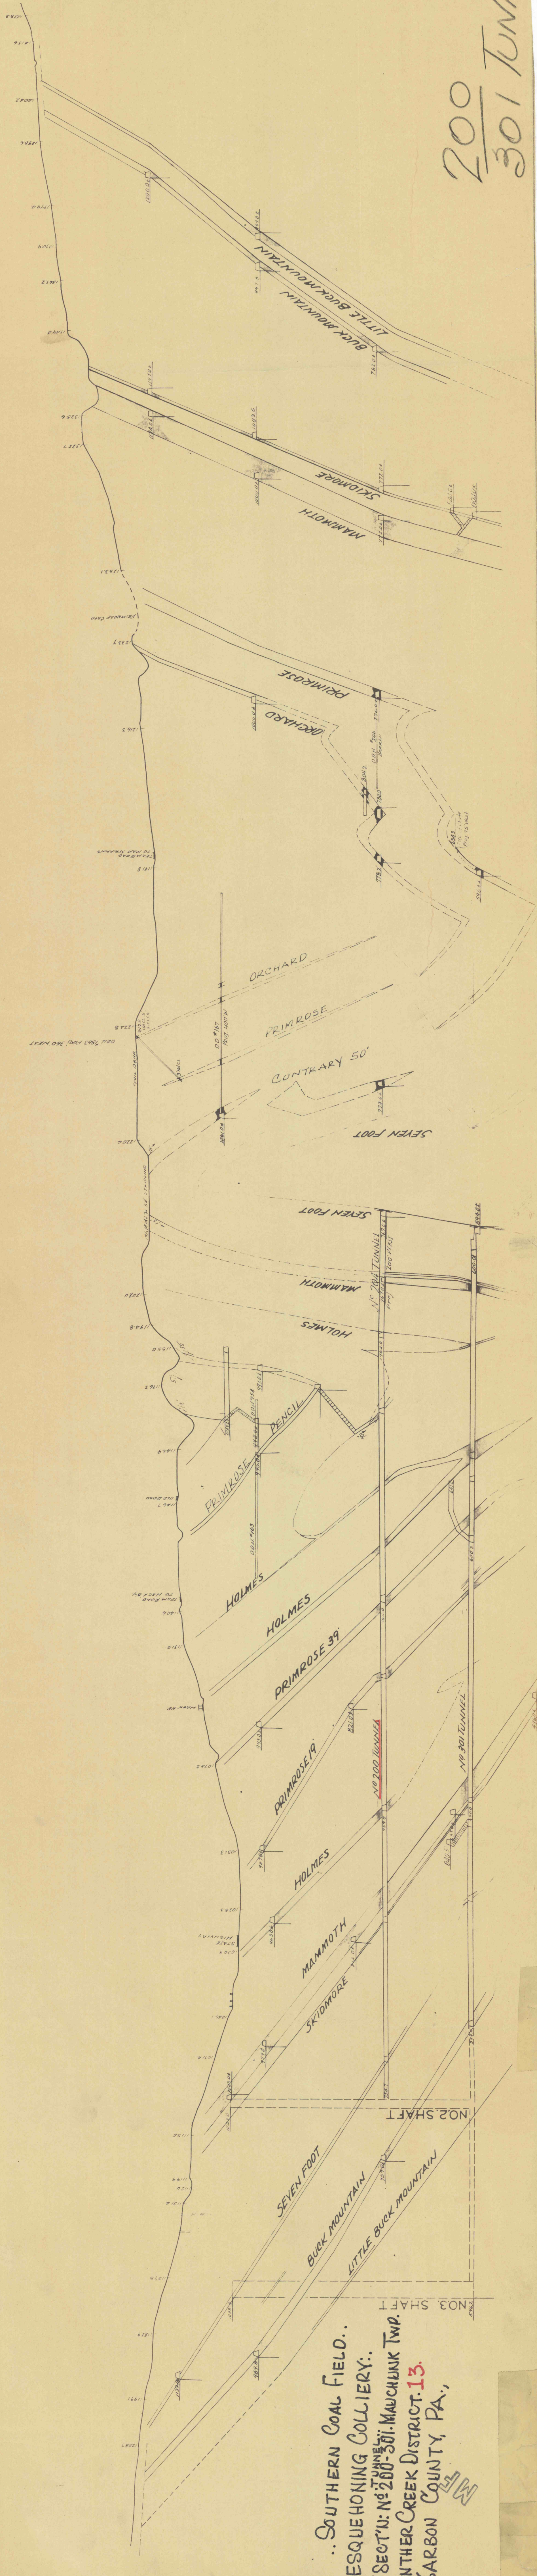

... SOUTHERN COAL FIELD..
NESQUEHONING COLLIERY..
X SECT'N: NO. 200-301. MAUCHUNK TWP.
PANTHER CREEK DISTRICT. 13.
CARBON COUNTY, PA.,

MF

MAY 7 1975