


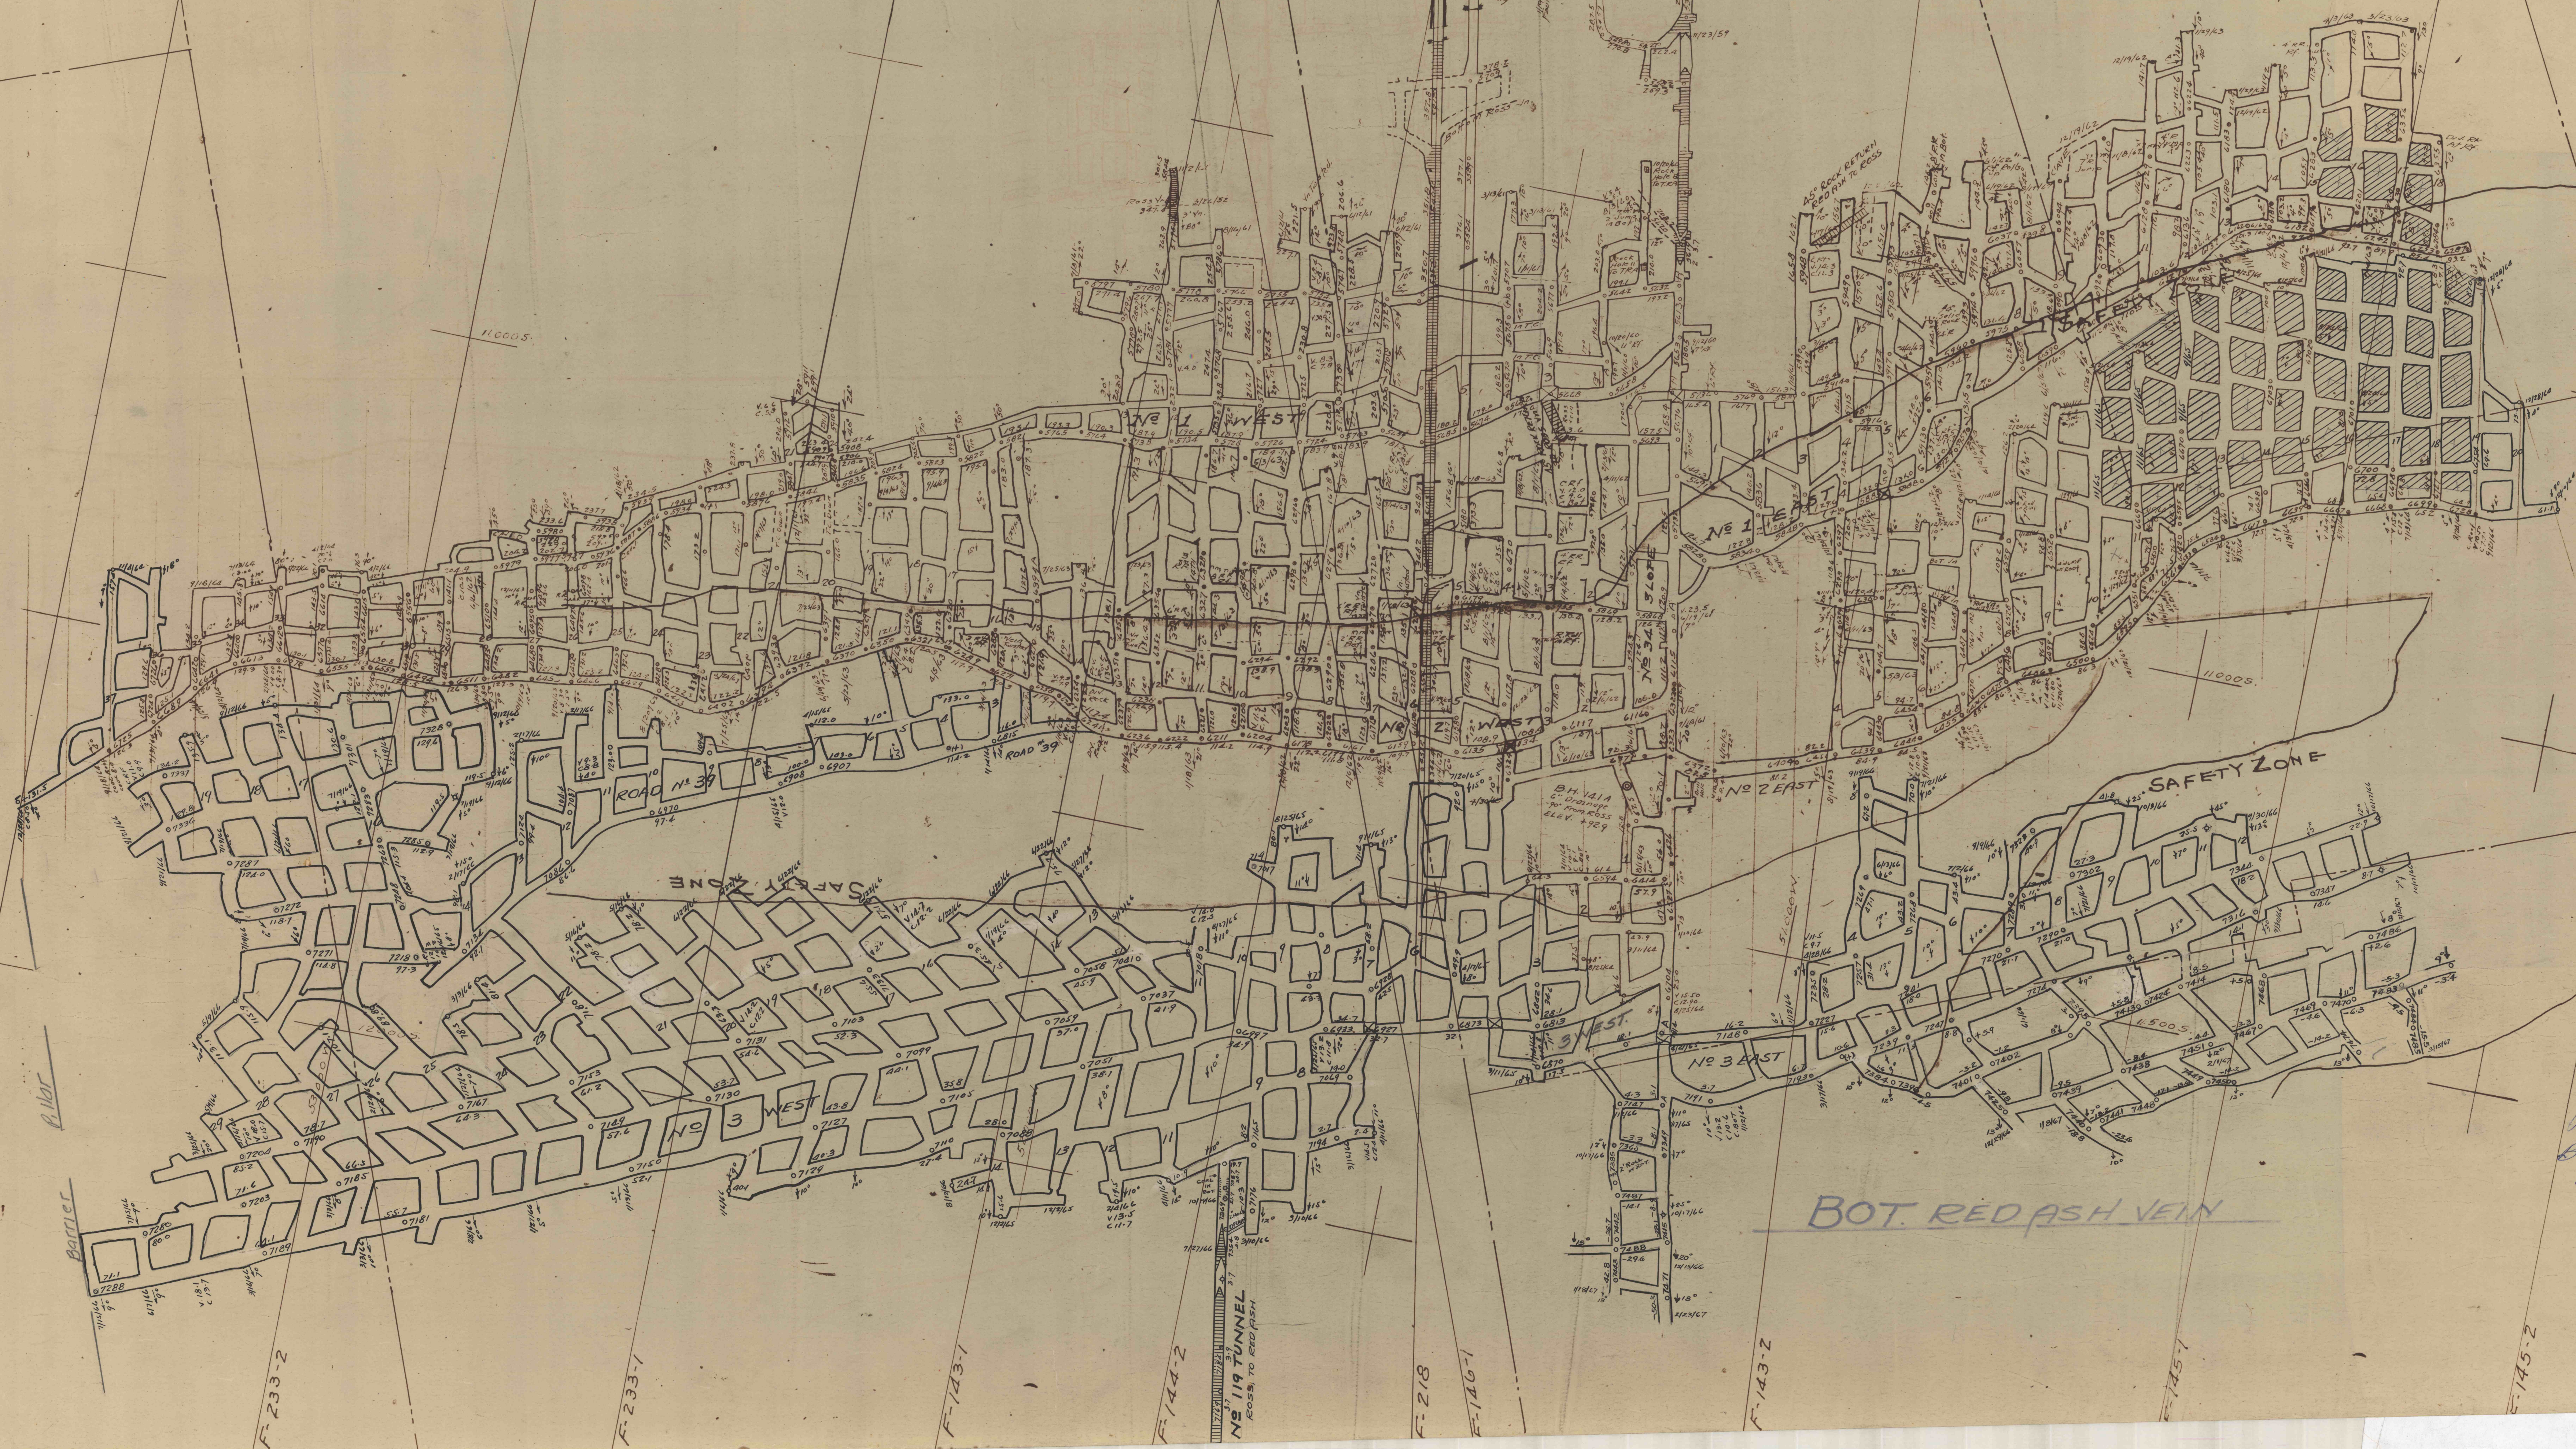

Wonomic City
Bot Red Ash Vein
Scale 1"=100'

POSTED SEE NEW
2-11-65 SEP 1A
6-2-65
3-25-66
8-2-66
10-21-66
3-31-67