


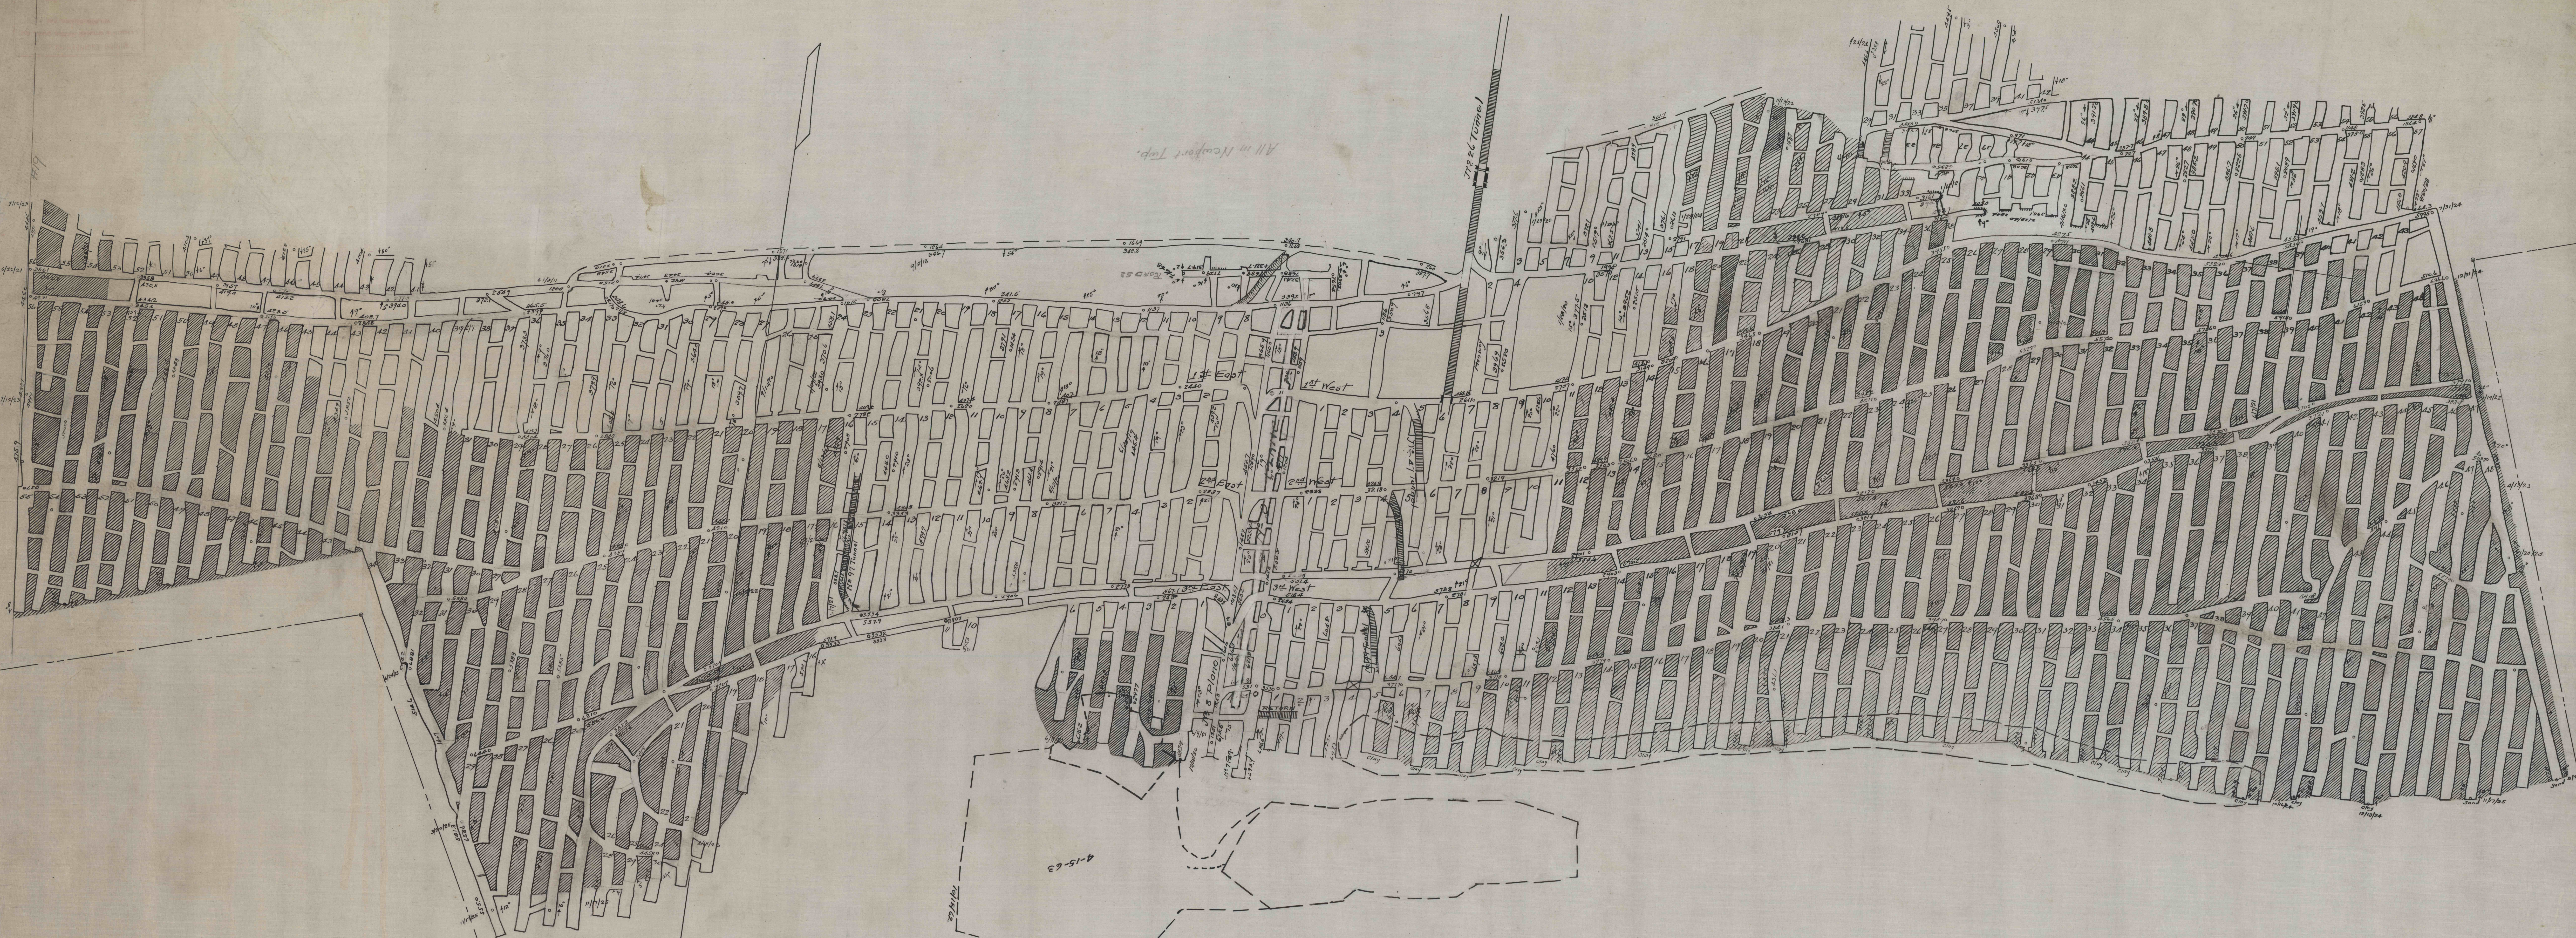

Date of Extension	
April 1951	
August 1951	
March 1952	
January 1953	
July 1953	
November 1953	
April 1954	
June 1954	
January 1955	
December 1955	
April 1956	
January 1957	
October 1957	
February 1958	
September 1958	
April 1959	
November 1959	

Posted May 1963
May 4, 1967
Nov. 11, 1968
Apr. 3, 1970

Nº 19
WANAMIE Nº 19

KIDNEY
NORTH SECTION