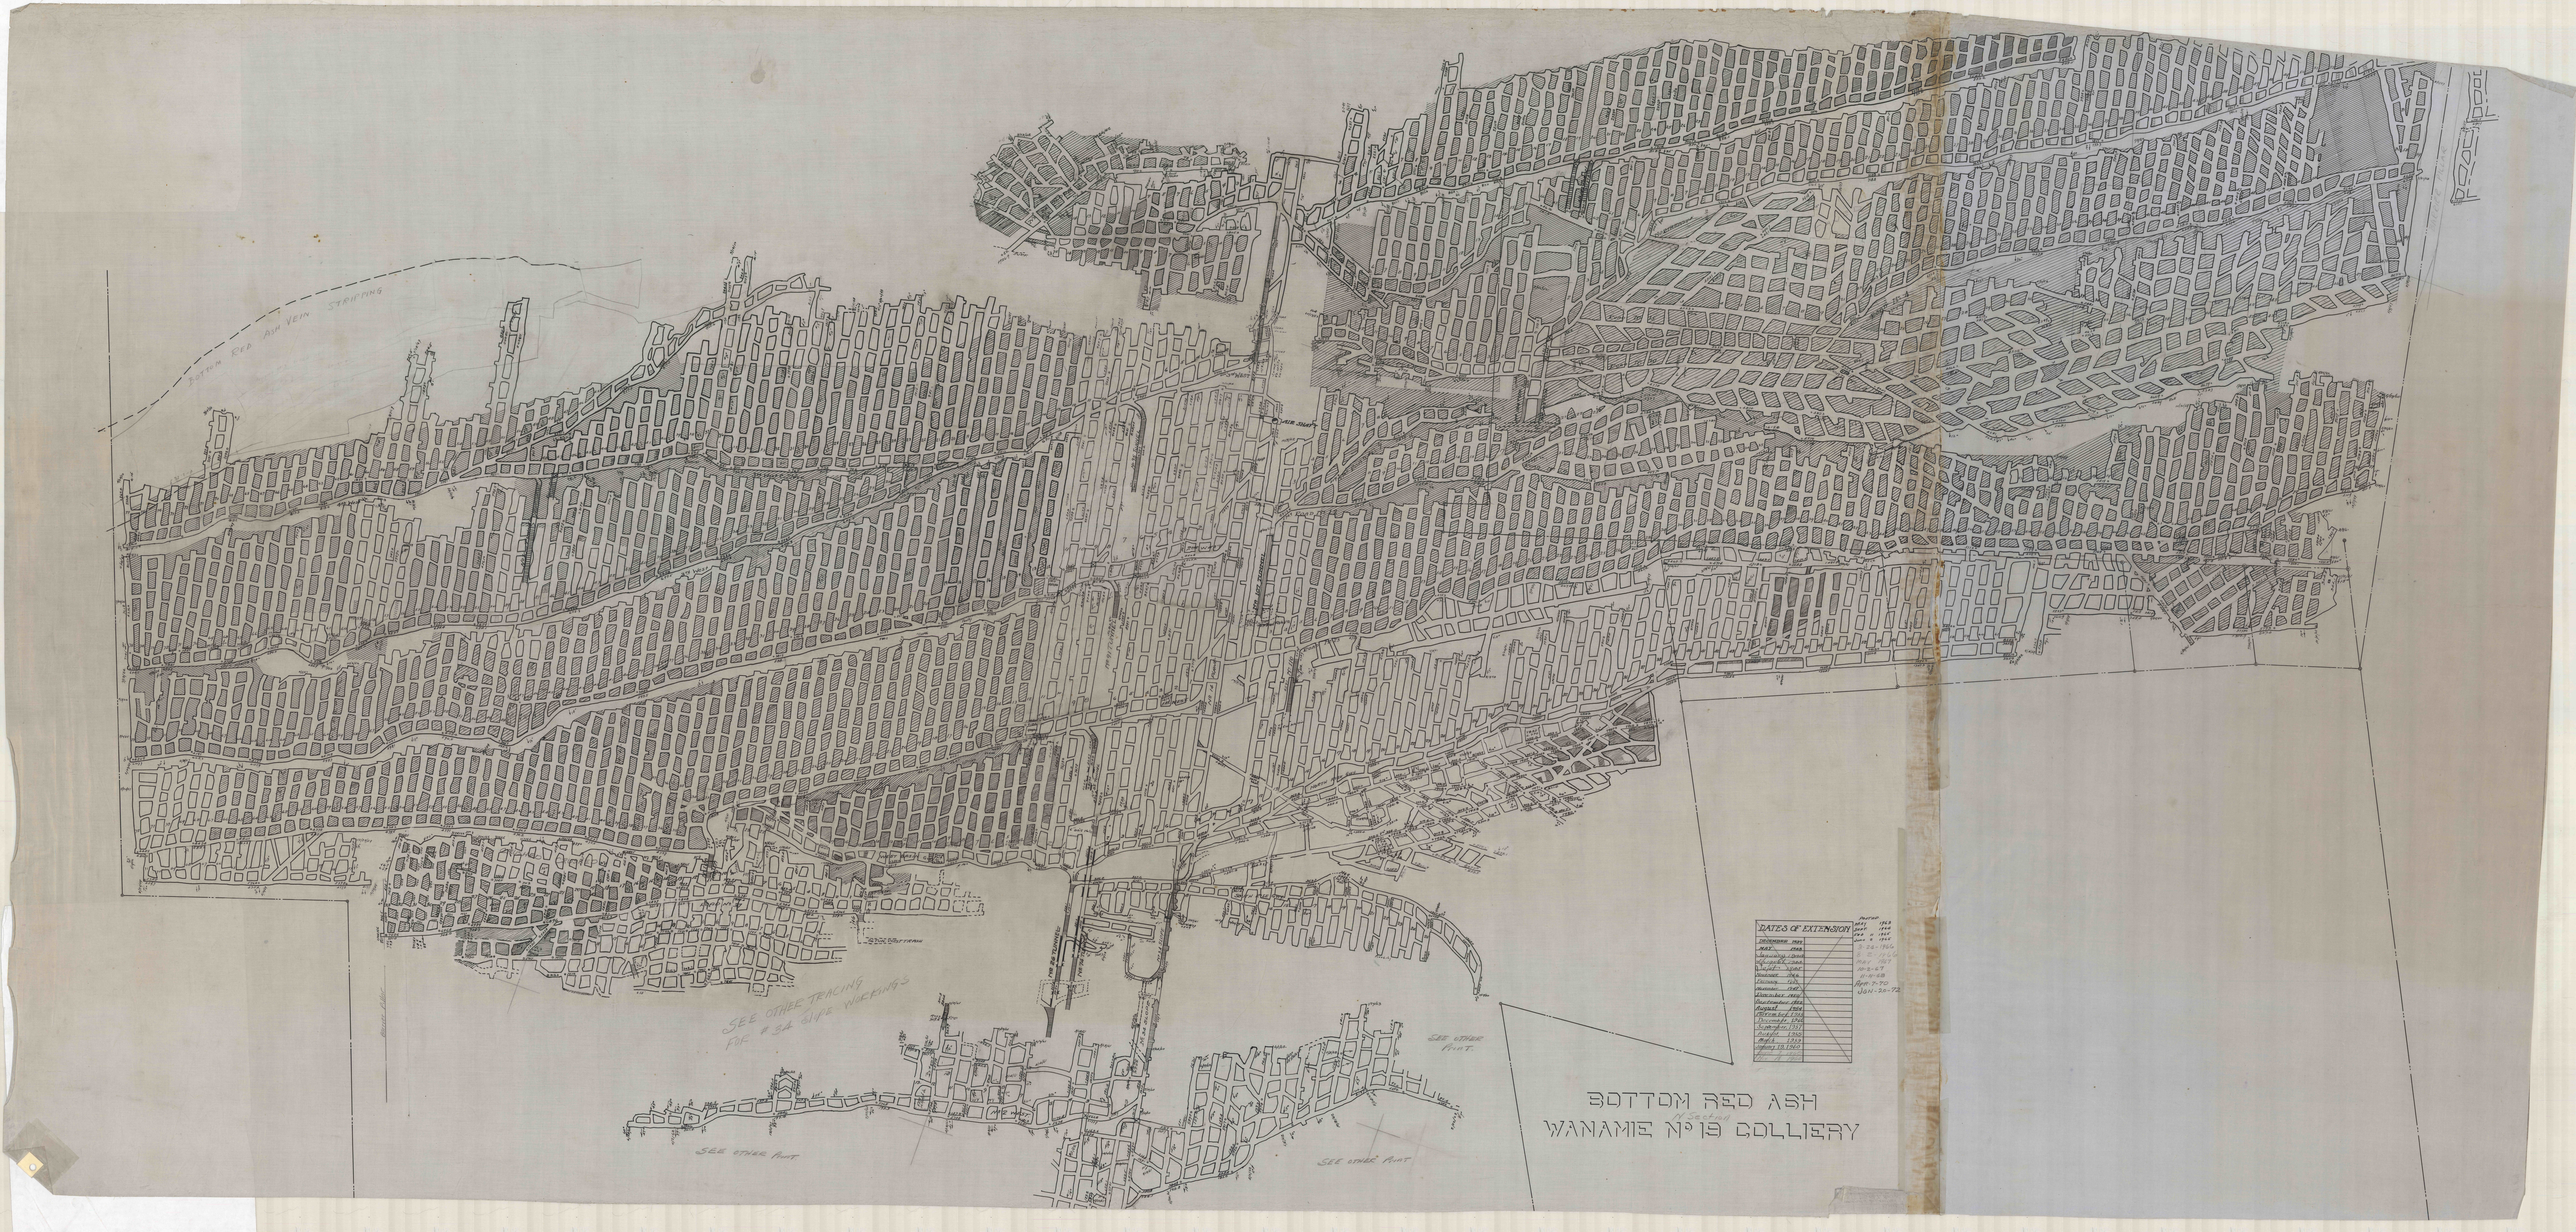
BOTTOM RED ASH VEIN STRIPPING
SEE OTHER TRACING FOR #34 SEAM WORKINGS
SEE OTHER PLAN.
SEE OTHER PLAN.
SEE OTHER PLAN.
DATES OF EXTENSION
BOTTOM RED ASH
WANAMIE No 19 COLLIERY