


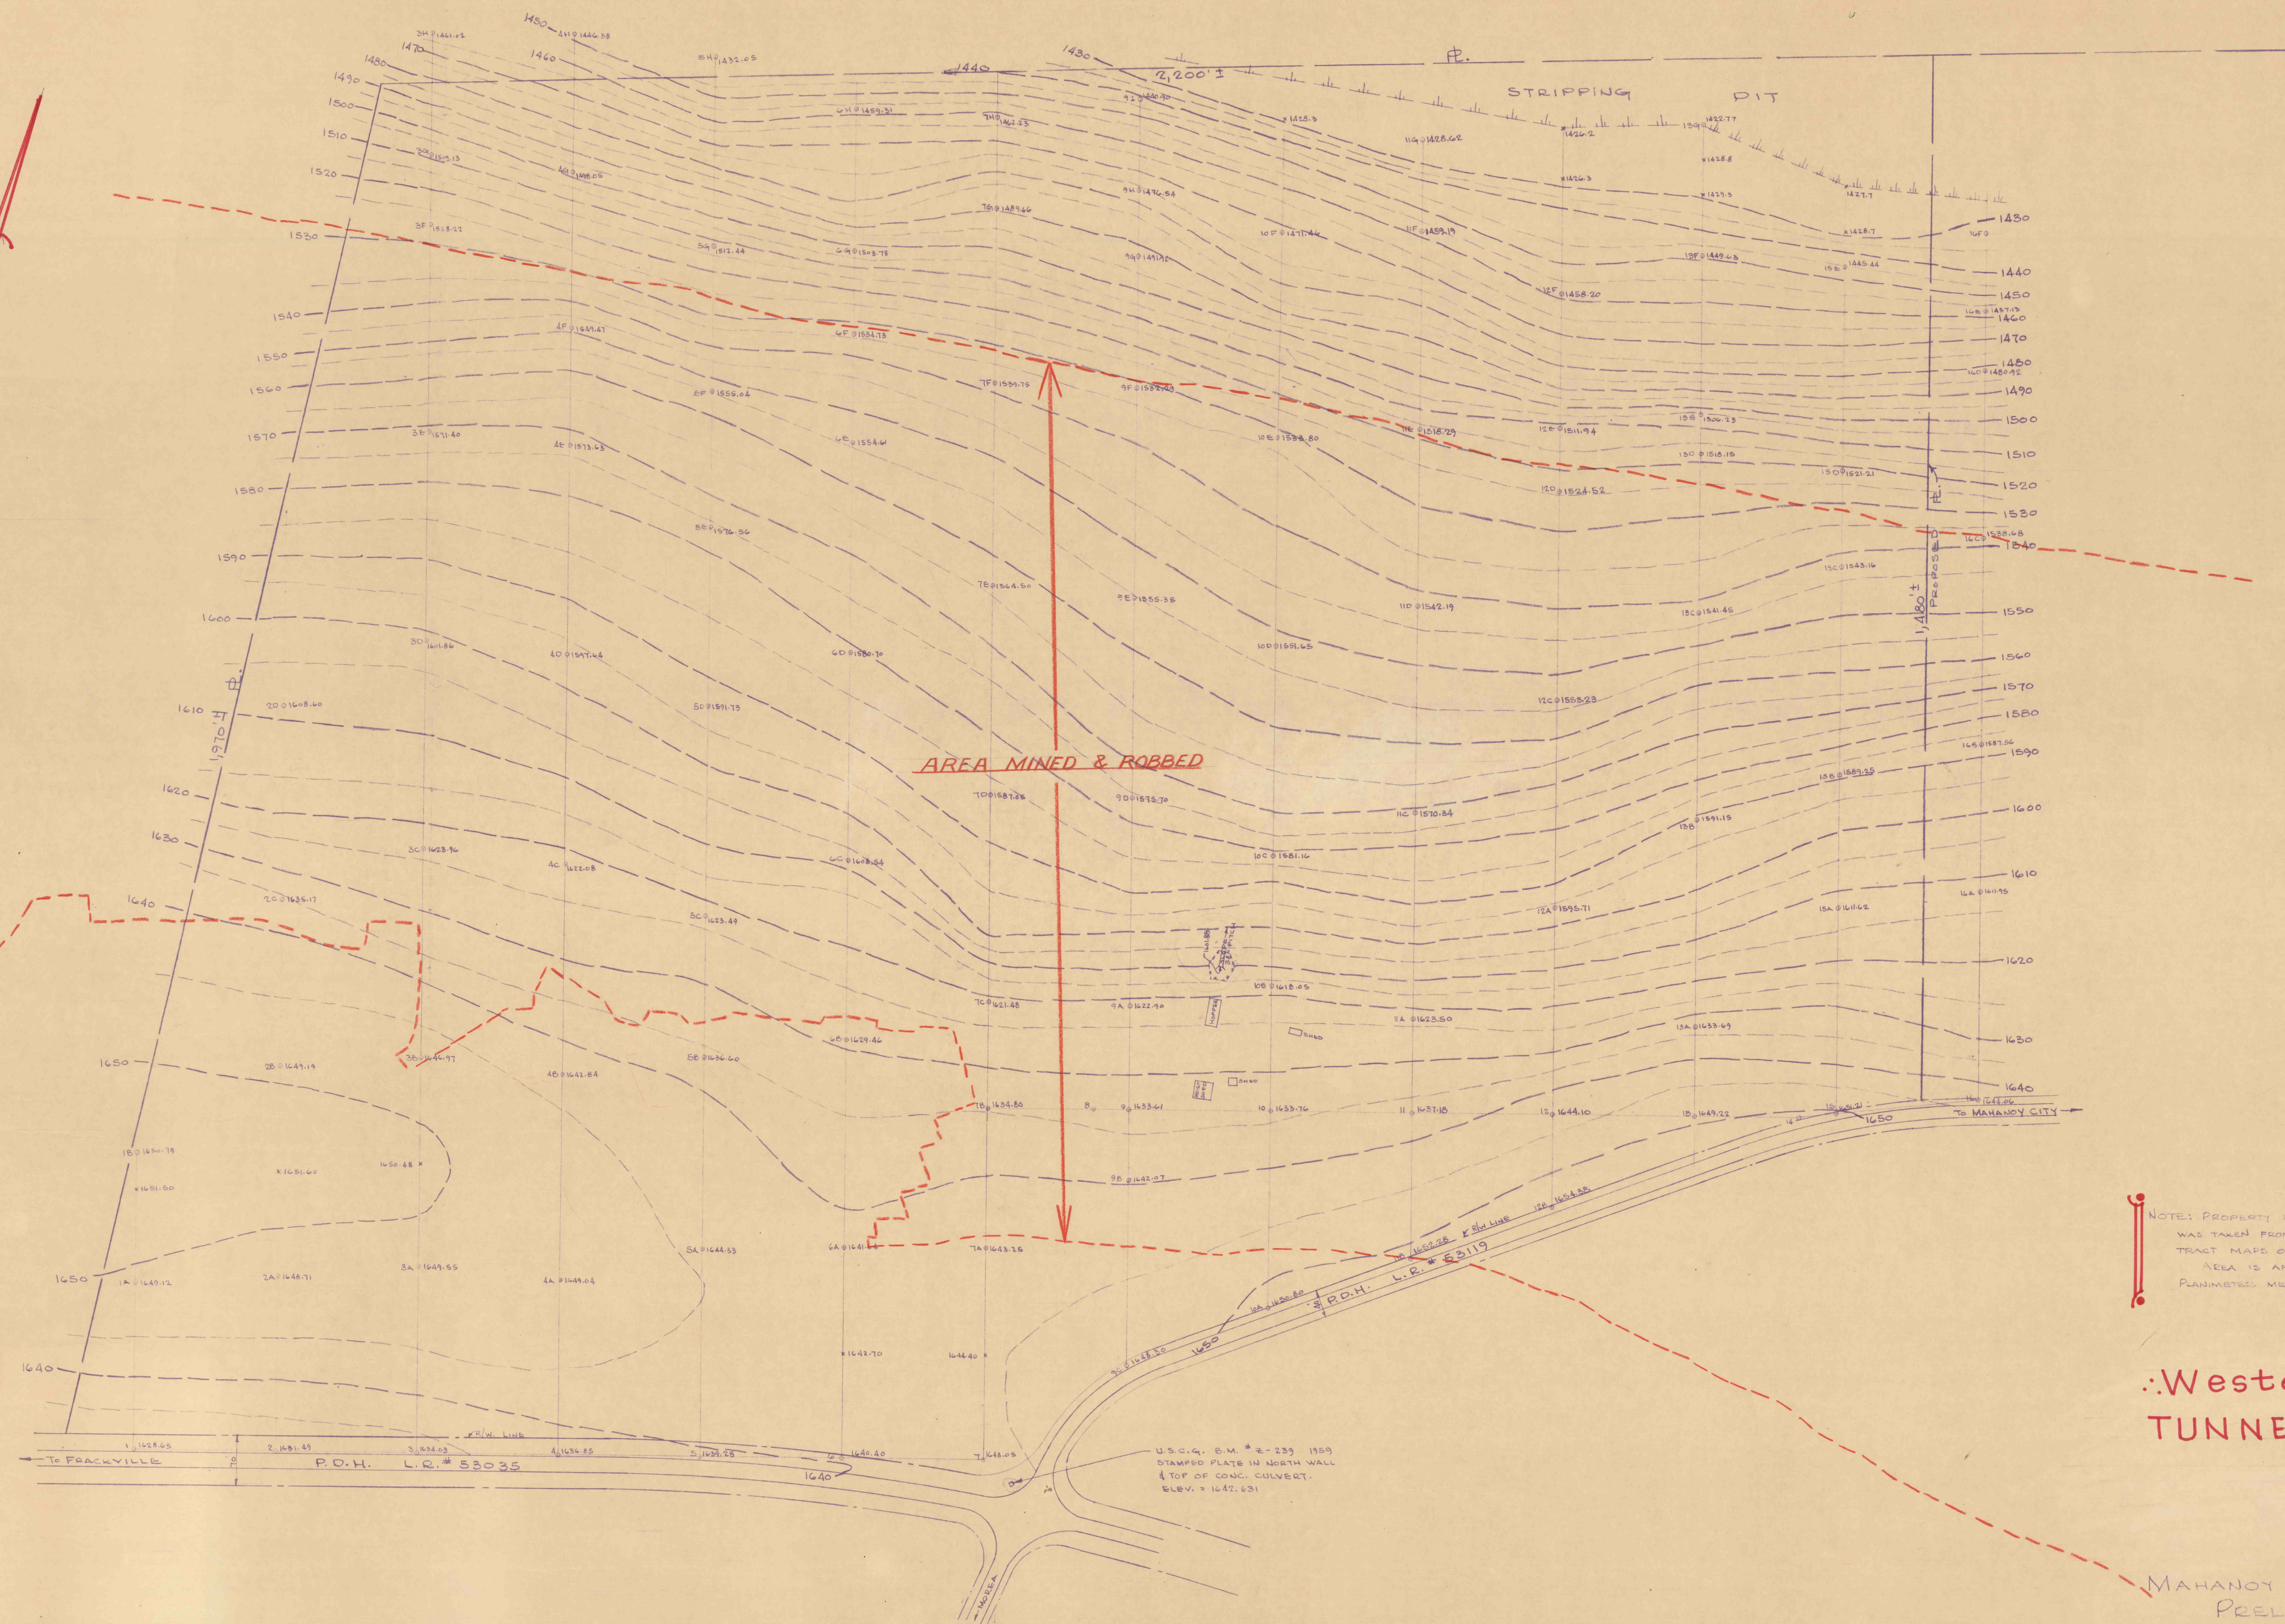

**Western Middle Field:
TUNNEL RIDGE COLLIERY**

MAHANOH AREA SCHOOL DISTRICT
PRELIMINARY TOPOGRAPHIC PLAN

SITUATE IN MAHANOH TOWNSHIP, SCHUYLKUP COUNTY, PA.
SCALE: 1" = 100' • MAY 23, 1968 • DWN: PGR • END: MLL
PREPARED BY: MERVIN J. JENSEN, REGISTERED SURVEYOR
ROOM 301 - CITY HALL BLDG.
POTTSVILLE, PENNSYLVANIA 17901