


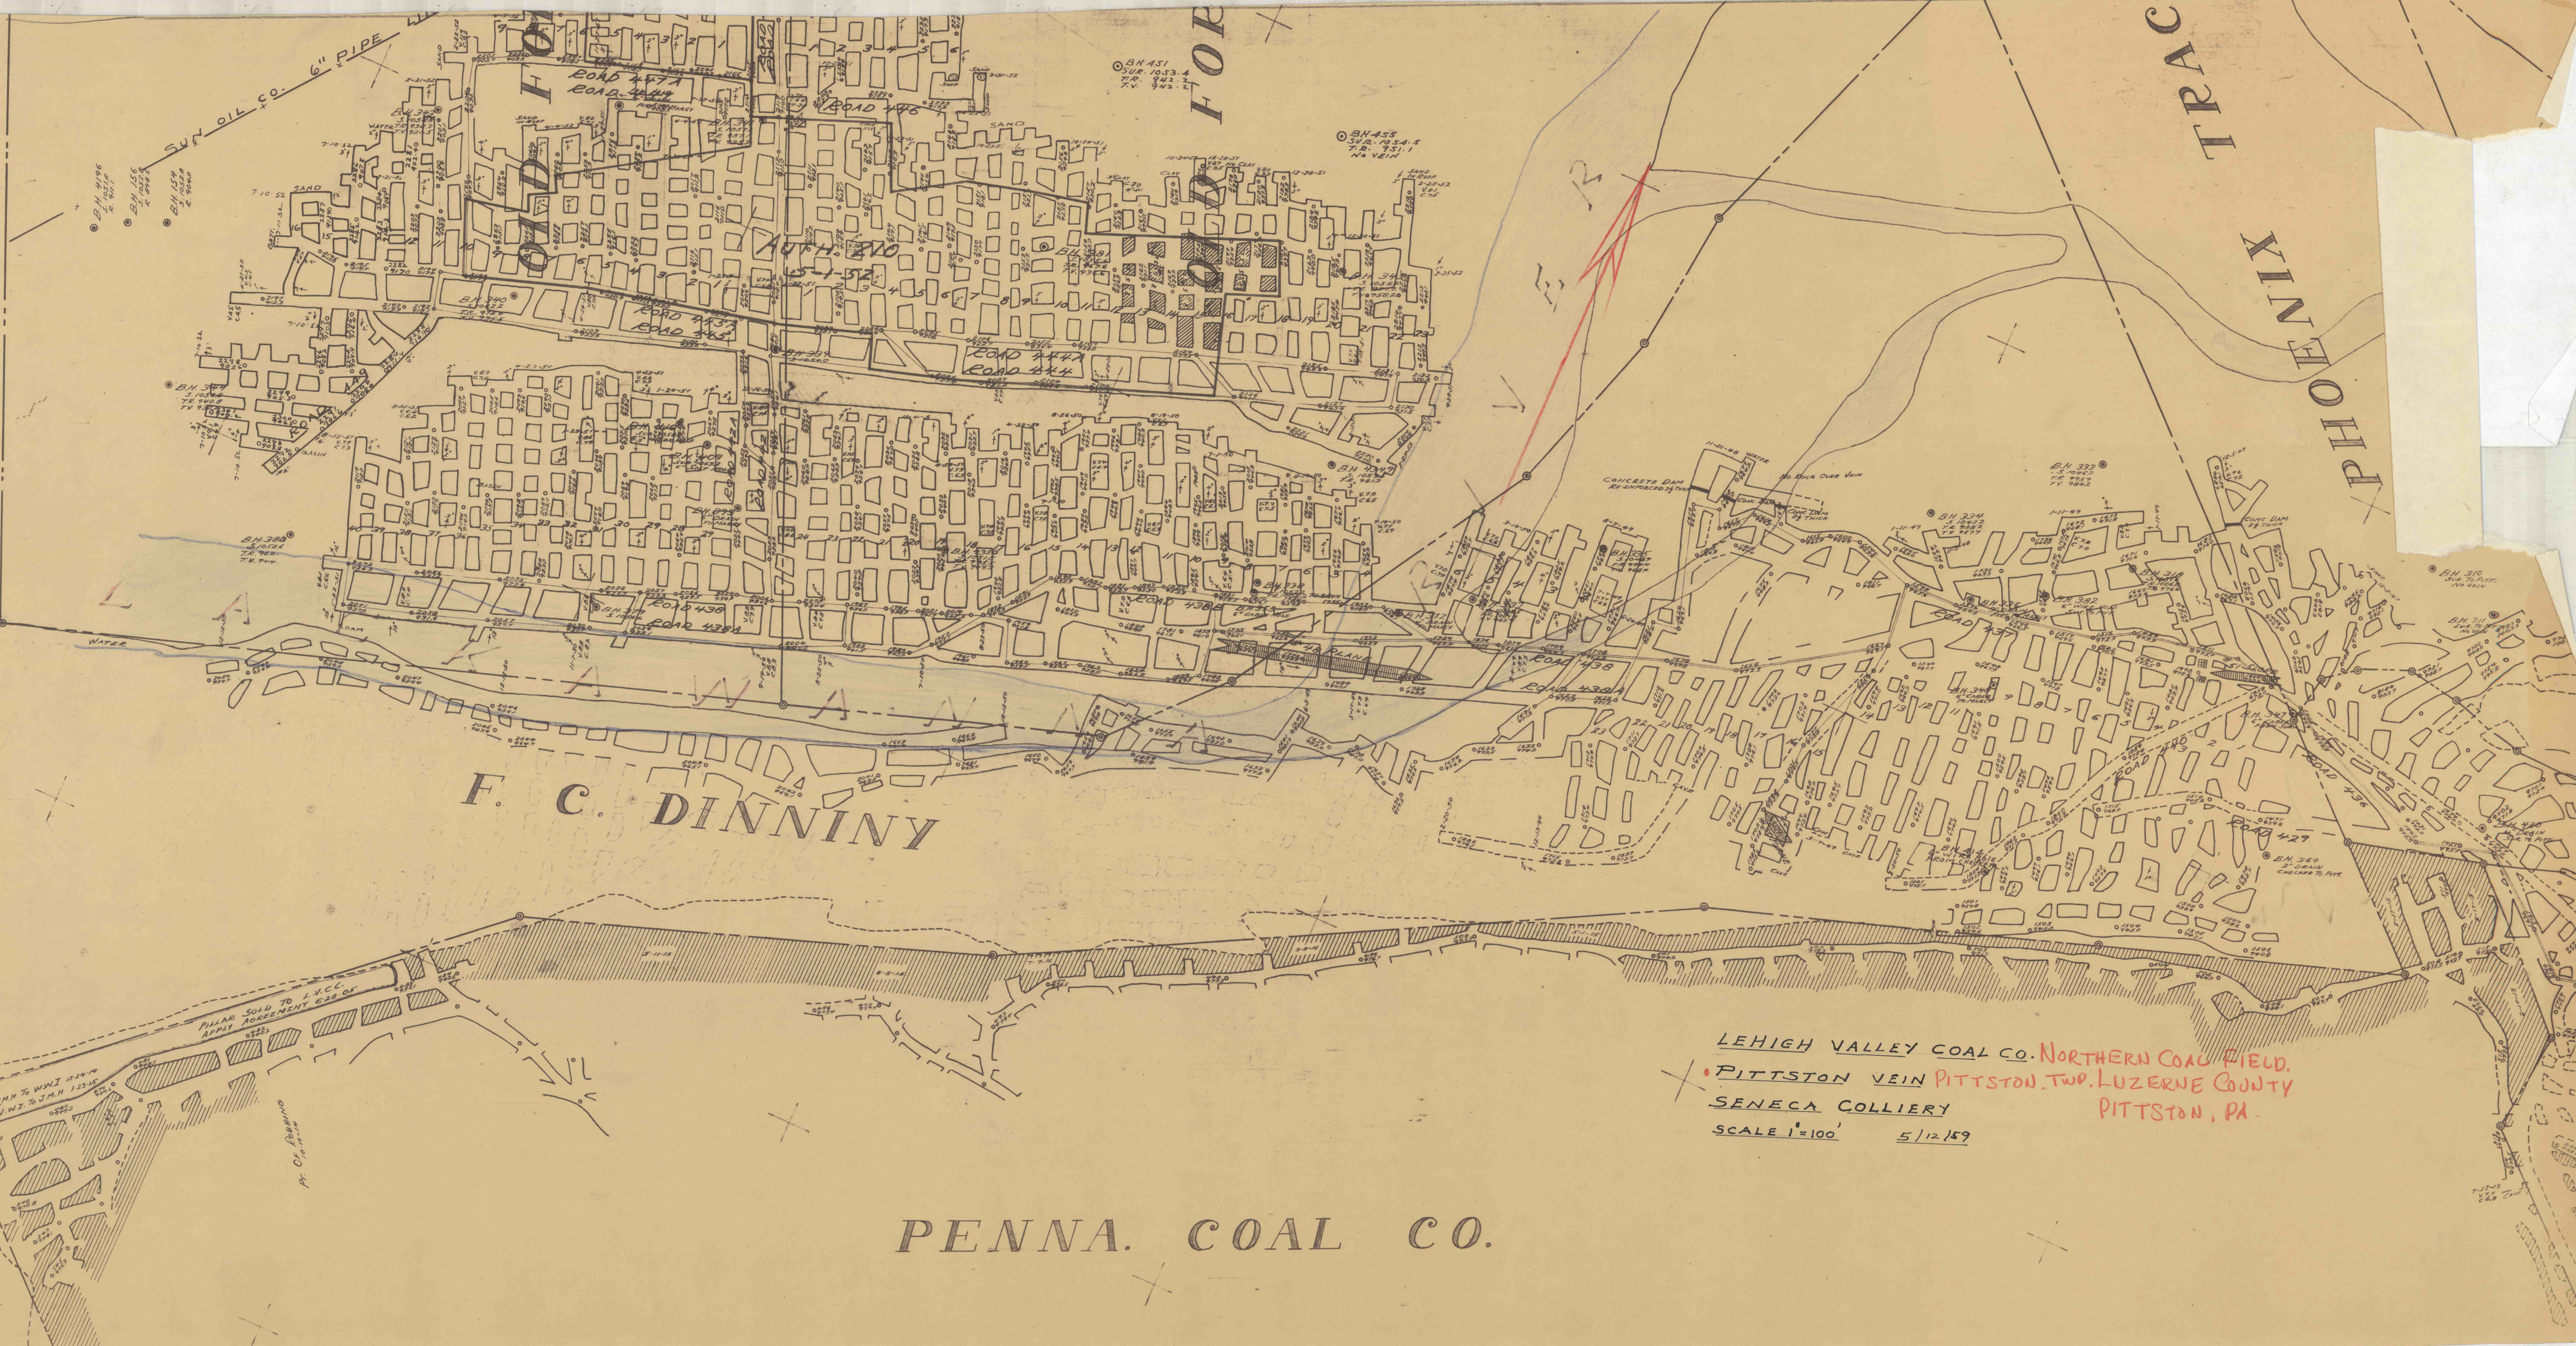

PENNA. COAL CO.

LEHIGH VALLEY COAL CO. NORTHERN COAL FIELD,
SENeca COLLIERY
SCALE 1"=100' 5/12/59