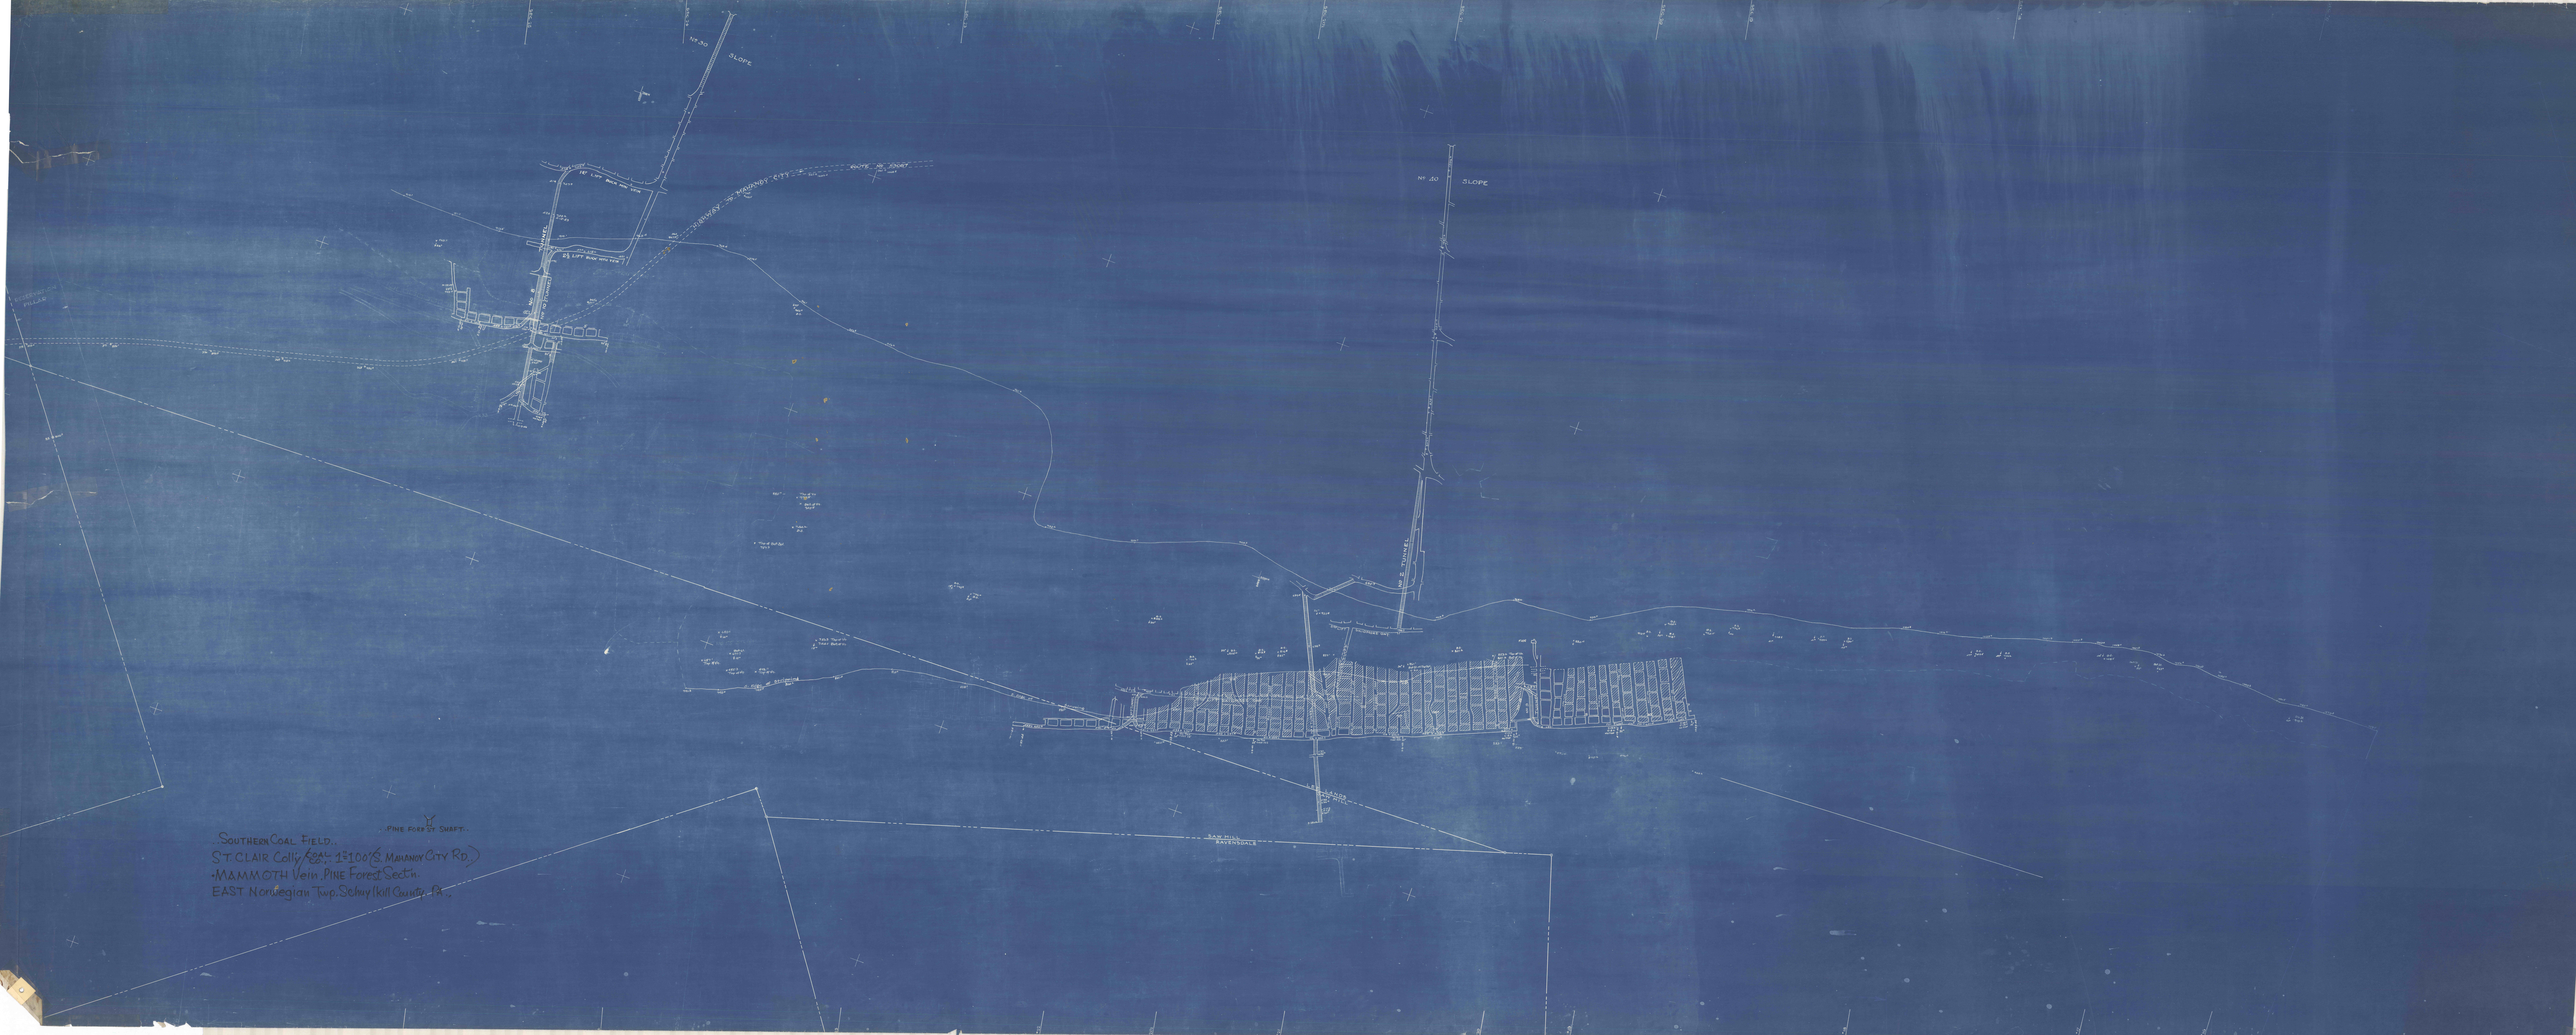

SOUTHERN COAL FIELD.

ST CLAIR Colly Co's 1" = 100' (S. MAHANOY CITY RD.)

MAMMOTH Vein. PINE Forest Sec'tn.

EAST Norwegian Twp. Schuylkill County, Pa.