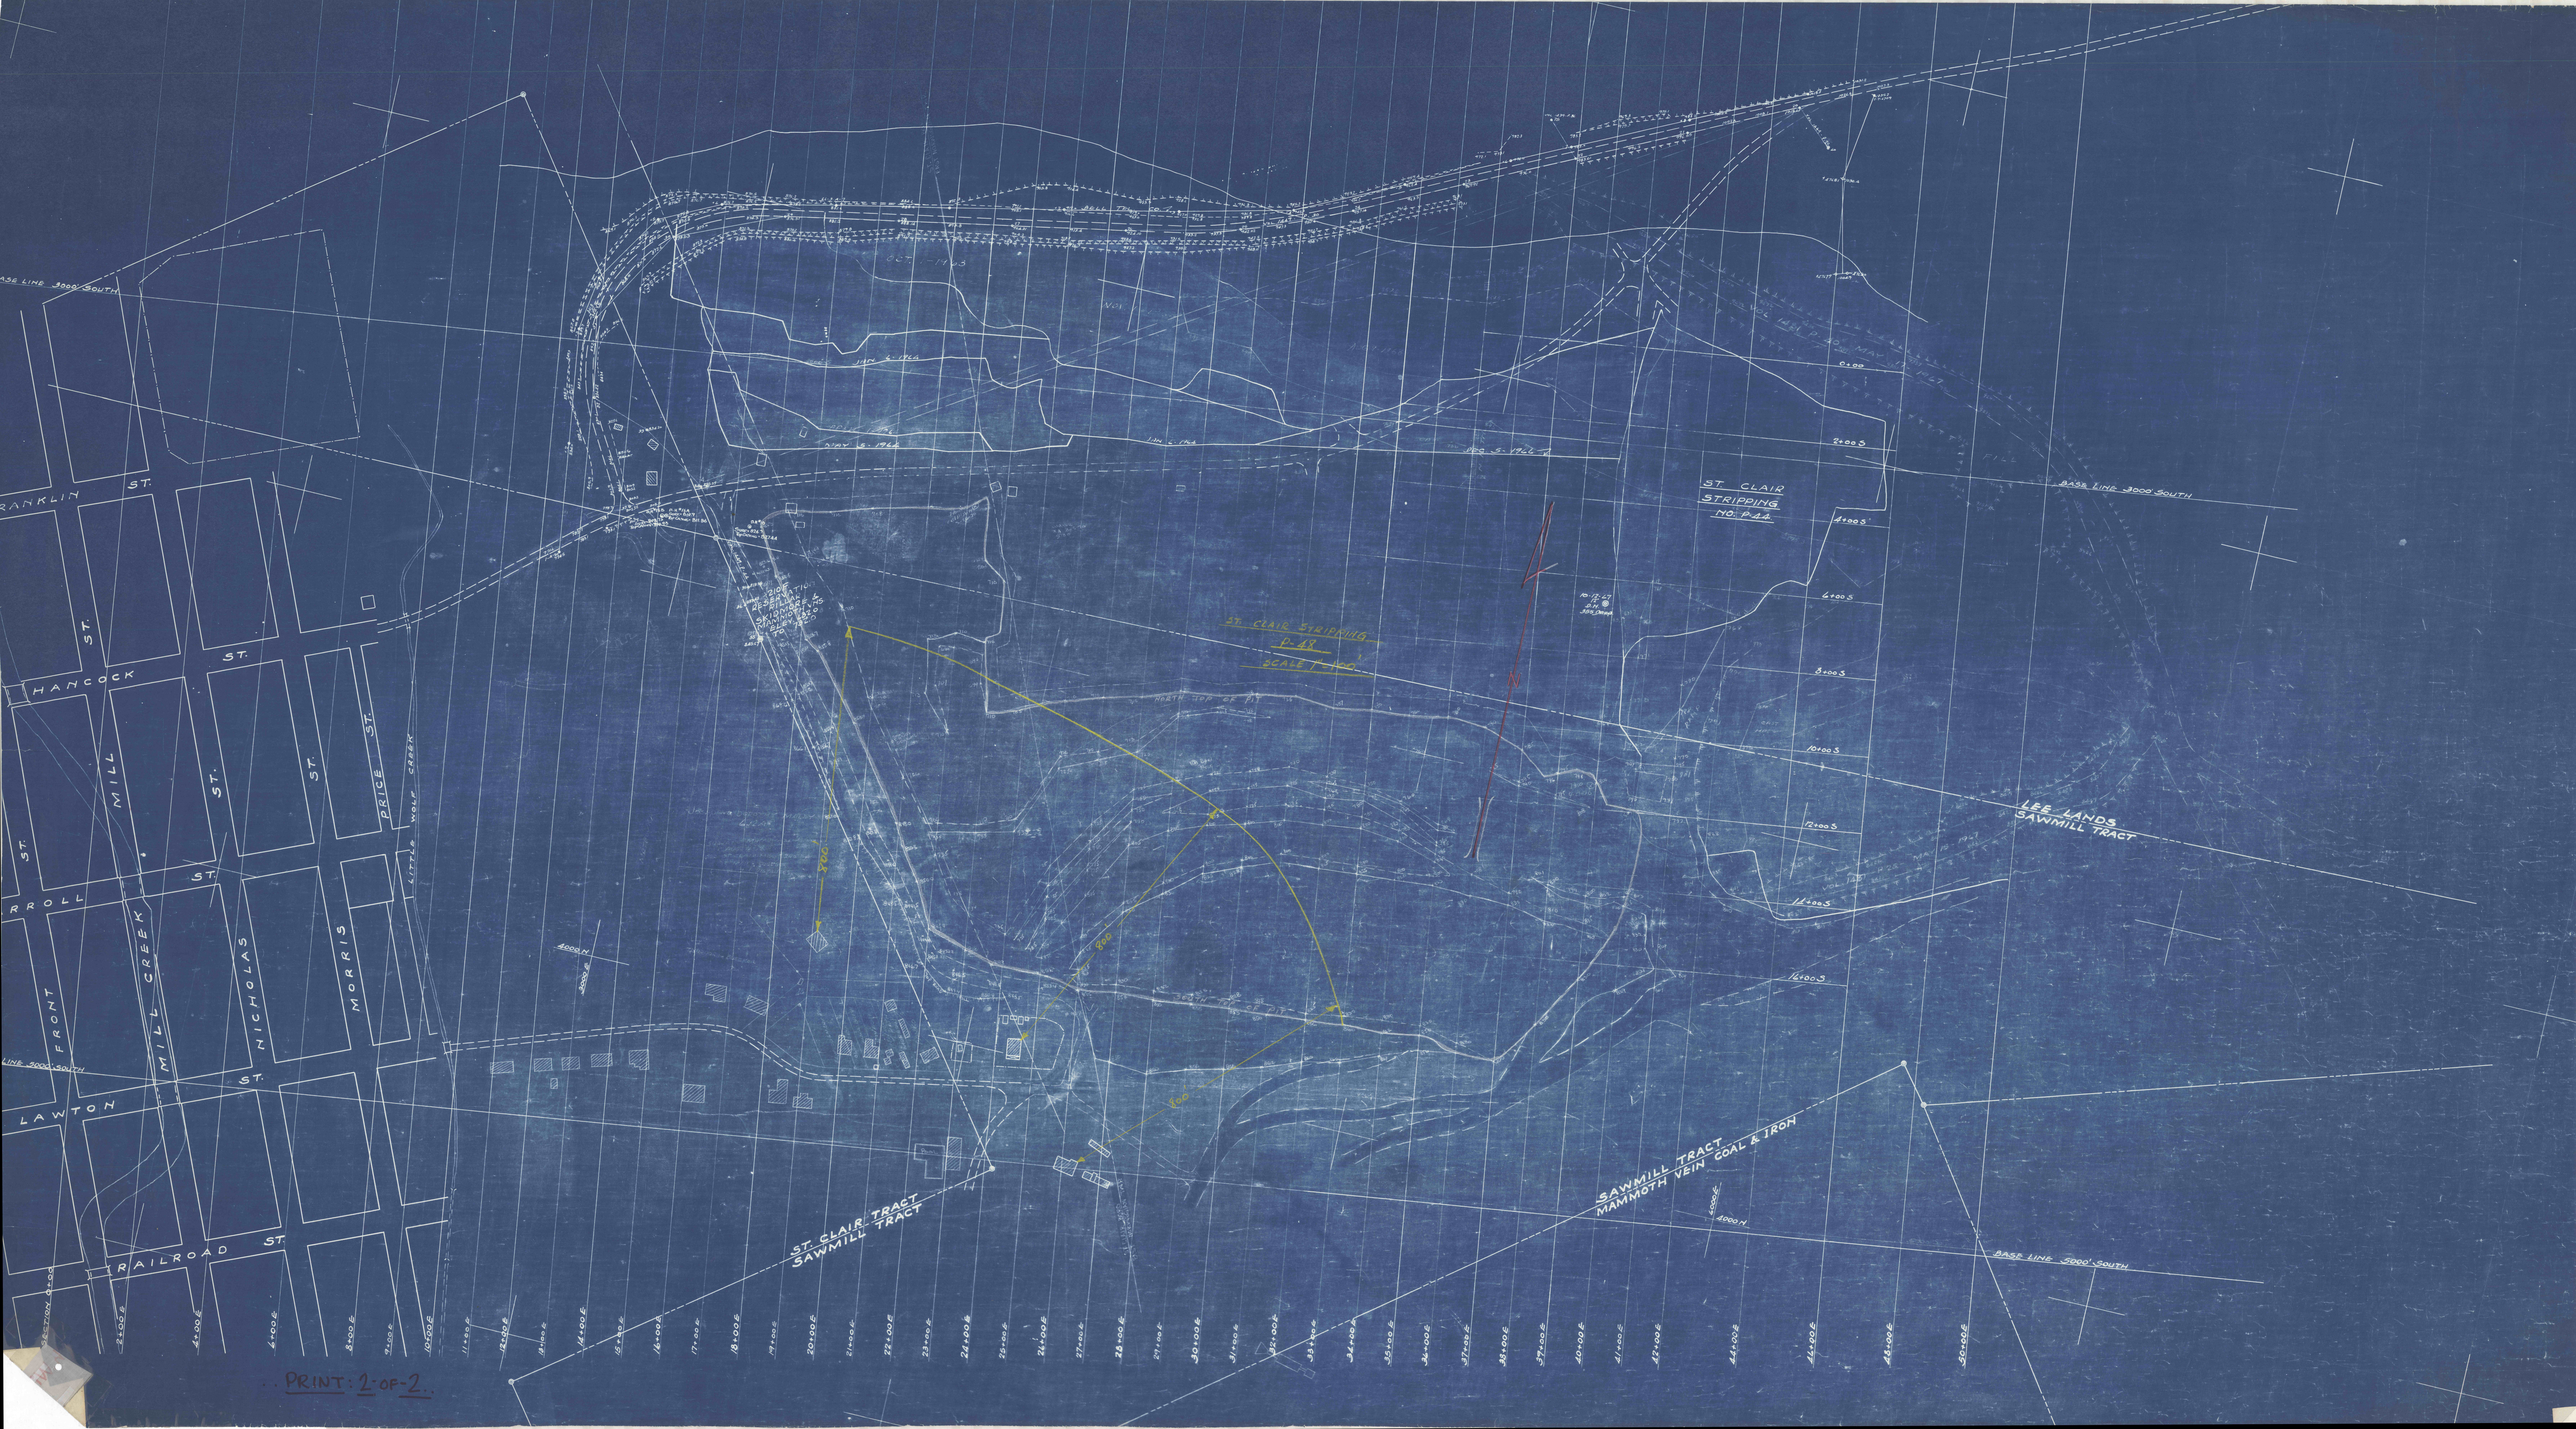

ST. CLAIR STRIPPING
P-48
SCALE 1"=100'
ST. CLAIR
STRIPPING
NO. P-44
BASE LINE 3000' SOUTH
BASE LINE 5000' SOUTH
FRANKLIN ST.
HANCOCK ST.
CARROLL ST.
LAWTON ST.
RAILROAD ST.
FRONT ST.
MILL ST.
MILL CREEK
NICHOLAS ST.
MORRIS ST.
PRICE ST.
LITTLE WOLF CREEK
210 FT. RESERVATION PILLAR SKIDMORE & MAMMOTH VNS. ELEV. 832.0 TO 732.0
BELL TEL. CO.
OCT. 1-1963
JAN. 6-1964
MAY 5-1964
DEC. 5-1966
VOL. 1481 P. 40 MAY 17, 1967
VOL. 1481 P. 25 MAY 15, 1967
FILL
RAMP
NORTH TOP OF PIT
SOUTH TOP OF PIT
10-12-67 12" D.H. 355 DEEP
N
800'
800'
800'
POOL
4000 N
3000 E
6000 E
4000 N
LEE LANDS
SAWMILL TRACT
ST. CLAIR TRACT
SAWMILL TRACT
SAWMILL TRACT
MAMMOTH VEIN COAL & IRON
0+00
2+00 S
4+00 S
6+00 S
8+00 S
10+00 S
12+00 S
14+00 S
16+00 S
SECTION 0+00
2+00 E
4+00 E
6+00 E
8+00 E
9+00 E
10+00 E
11+00 E
12+00 E
13+00 E
14+00 E
15+00 E
16+00 E
17+00 E
18+00 E
19+00 E
20+00 E
21+00 E
22+00 E
23+00 E
24+00 E
25+00 E
26+00 E
27+00 E
28+00 E
29+00 E
30+00 E
31+00 E
32+00 E
33+00 E
34+00 E
35+00 E
36+00 E
37+00 E
38+00 E
39+00 E
40+00 E
41+00 E
42+00 E
44+00 E
46+00 E
48+00 E
50+00 E

PRINT: 2 OF 2