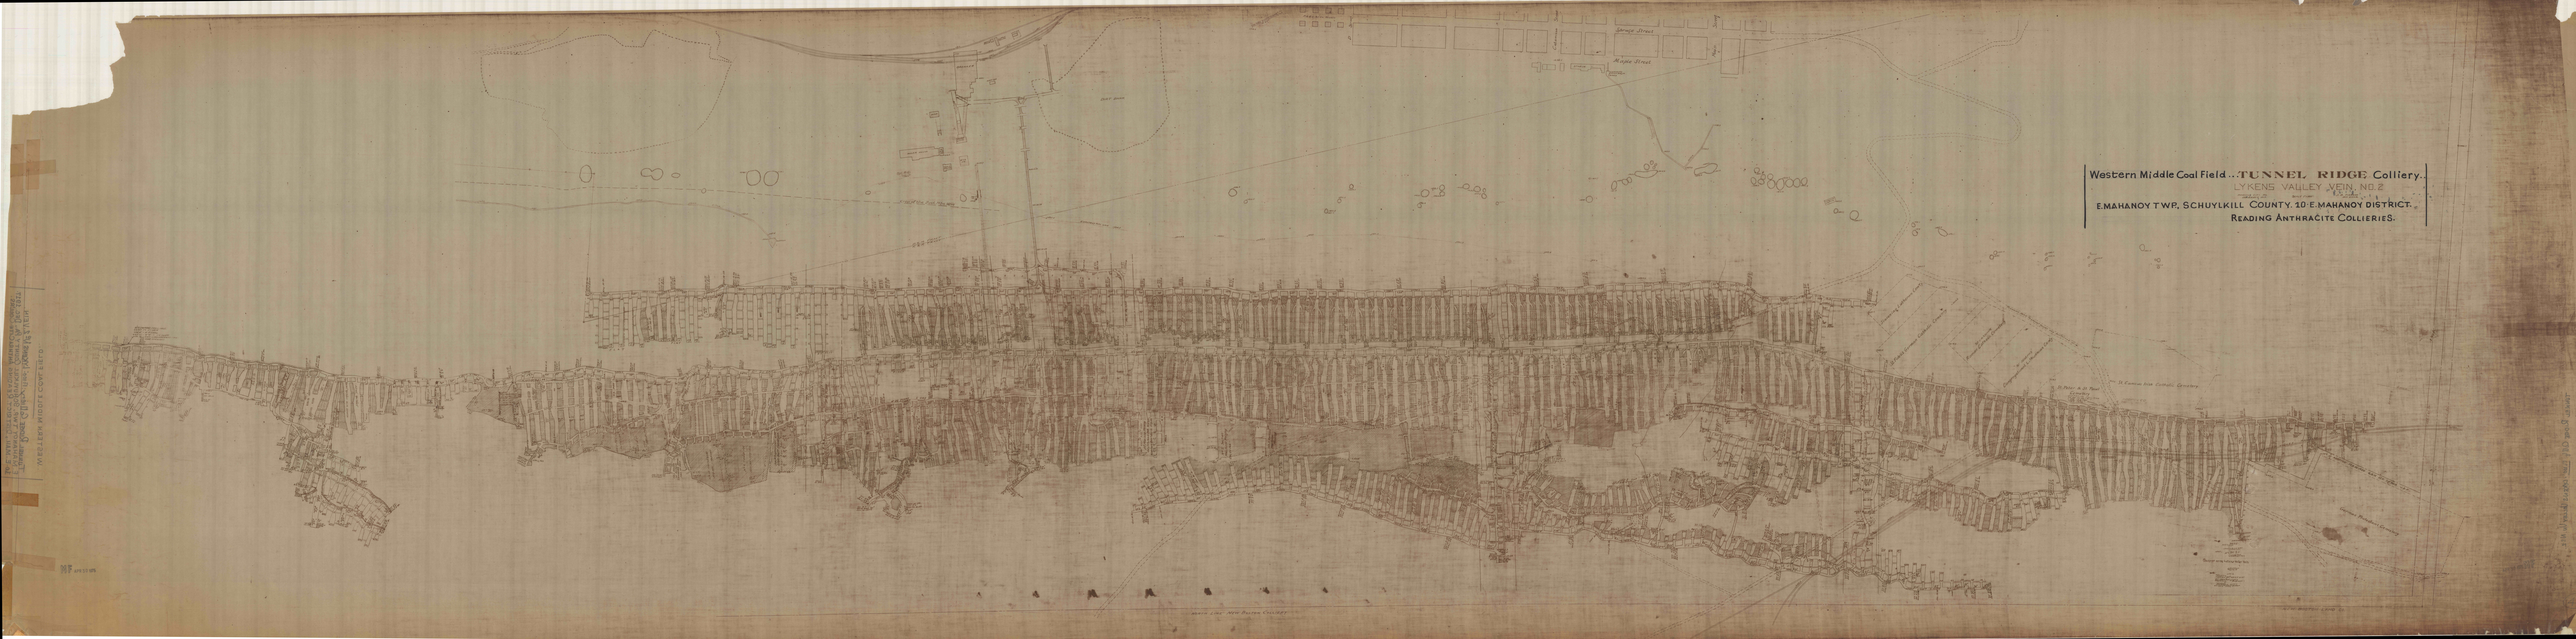

Western Middle Coal Field .. TUNNEL RIDGE Colliery..
LYKENS VALLEY VEIN NO. 2
E. MAHANOY TWP. SCHUYLKILL COUNTY. 10 E. MAHANOY DISTRICT.
READING ANTHRACITE COLLIERIES.