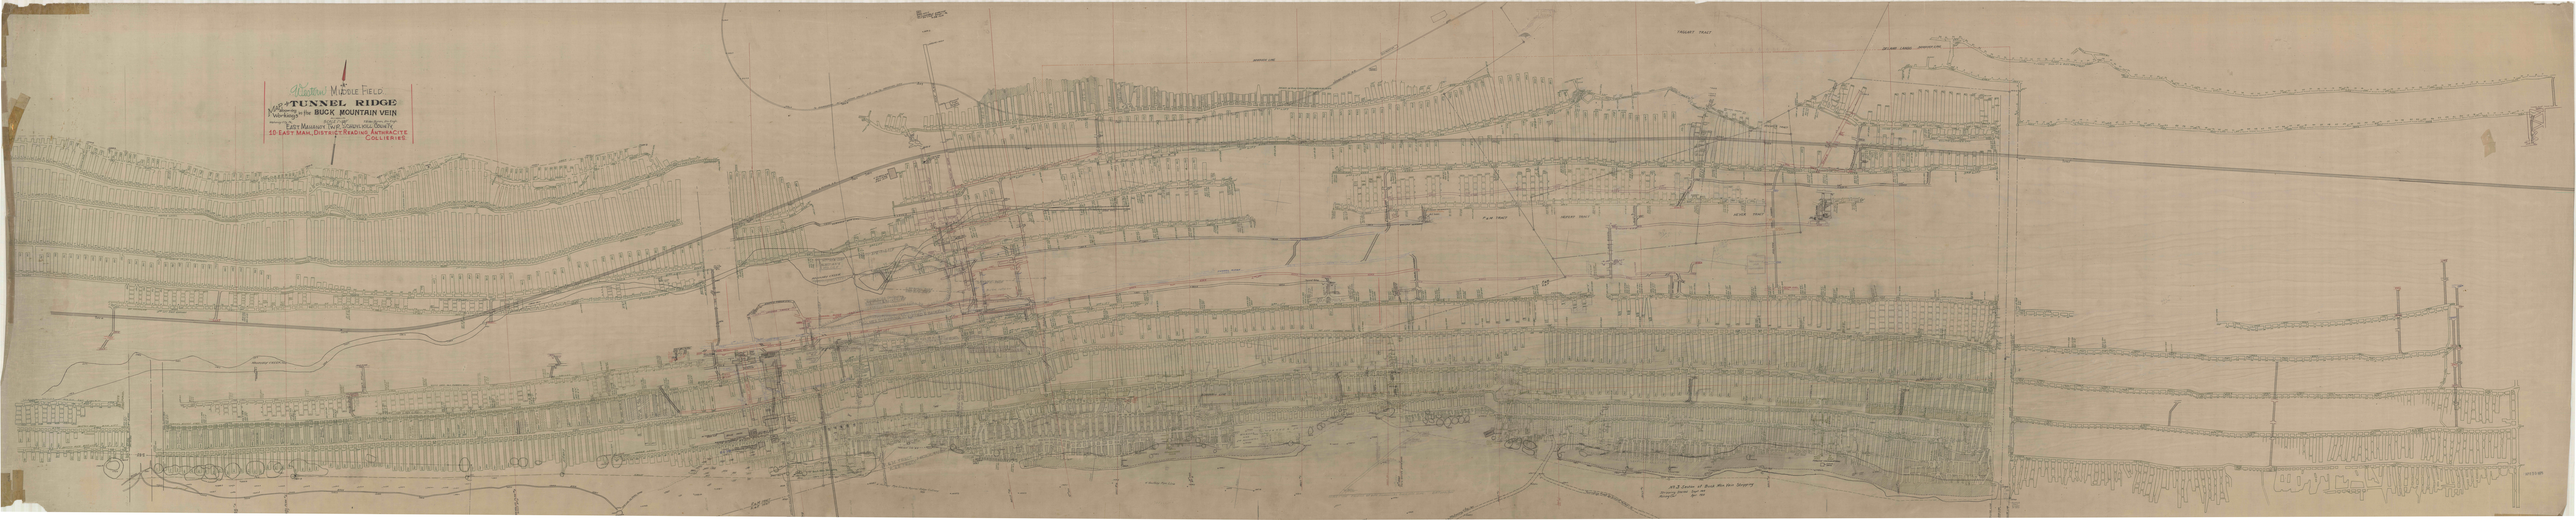
Western Middle Field
Map of TUNNEL RIDGE
Showing Workings in the BUCK MOUNTAIN VEIN
East Mahanoy Twp. Schuylkill County
to East Main District Reading Anthracite Collieries