


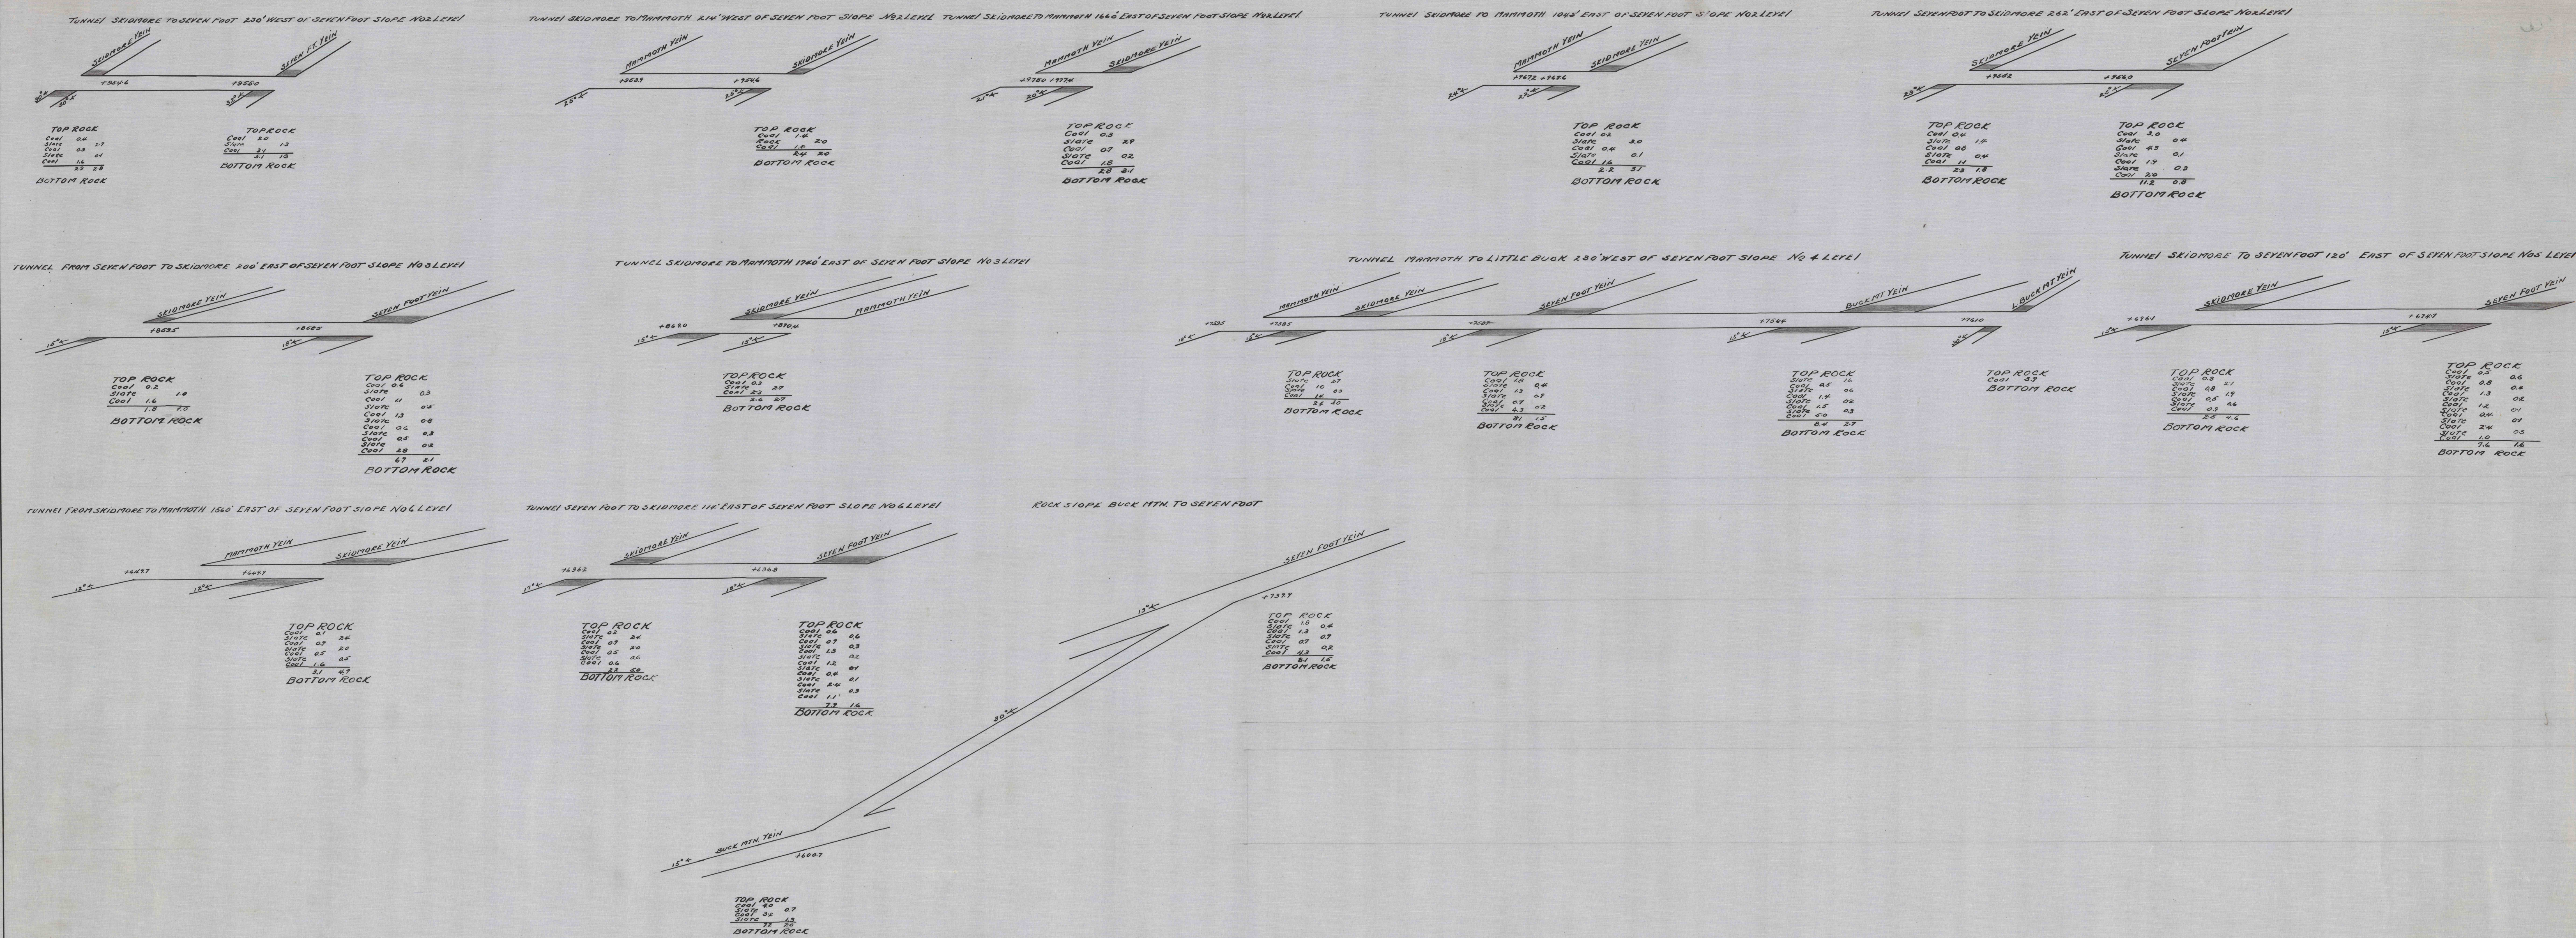

Western MIDDLE COAL FIELD.  
TUNNEL COLLIERIES.. 1"=100'. ALL VEINS.  
COLUMNAR SECTIONS CUT IN TUNNEL..  
Schuylkill COUNTY, PA. ASHLAND..  
..READING ANTHRACITE COLLIERIES..

.. 2 of 3..  
MF APR 30 1975

MF APR 30 1975