


MAP SHOWING MCCANN SLOPE WORKINGS
IN TUNNEL RIDGE-BUCK MOUNTAIN VEIN-
IN RELATION TO INDEPENDENT MINERS
WORKINGS IN-BUCK MOUNTAIN, LITTLE
BUCK MOUNTAIN AND SEVEN FOOT VEINS
JULY 30, 1946.
SCALE 10'-100'.

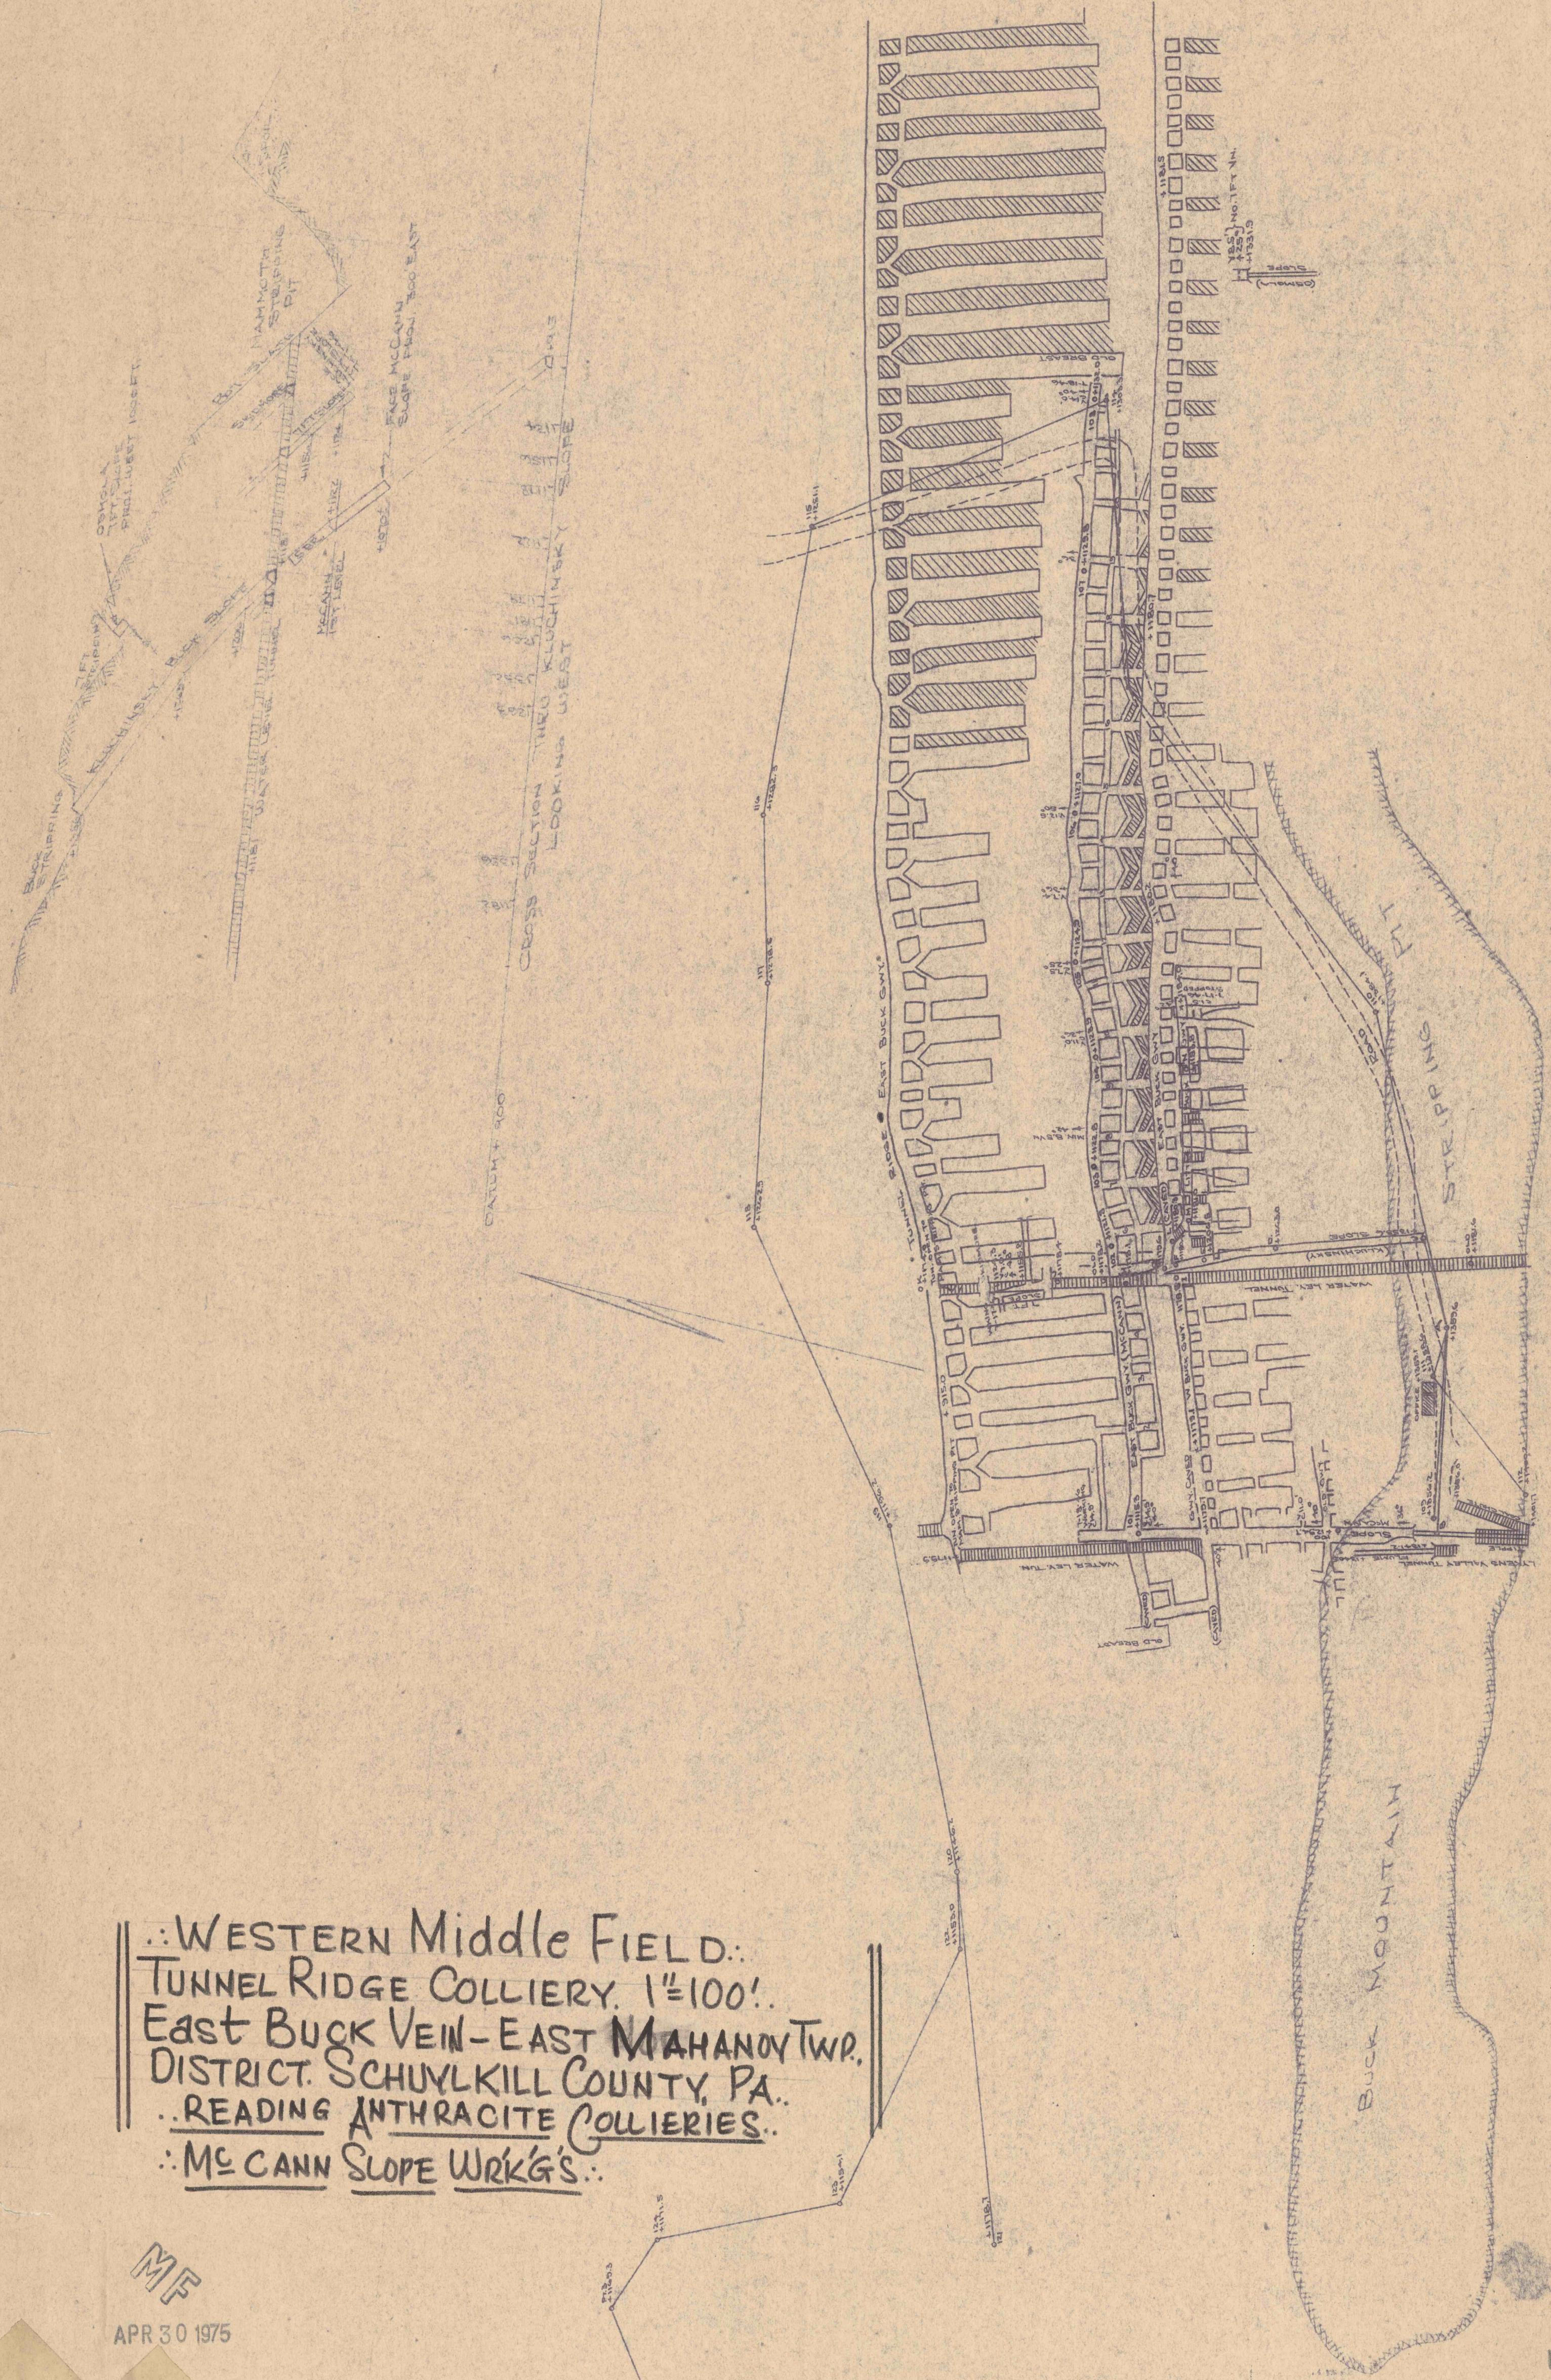

WESTERN Middle FIELD:
TUNNEL RIDGE COLLIERY. 1"=100'.
East BUCK VEIN-EAST MAHANOV TWP.
DISTRICT. SCHUYLKILL COUNTY, PA..
READING ANTHRACITE COLLIERIES..
MCCANN SLOPE WRK'G'S.:

APR 30 1975

APR 30 1975