


L & W. B. COAL CO
PELL

THOMAS P. COLLINGS

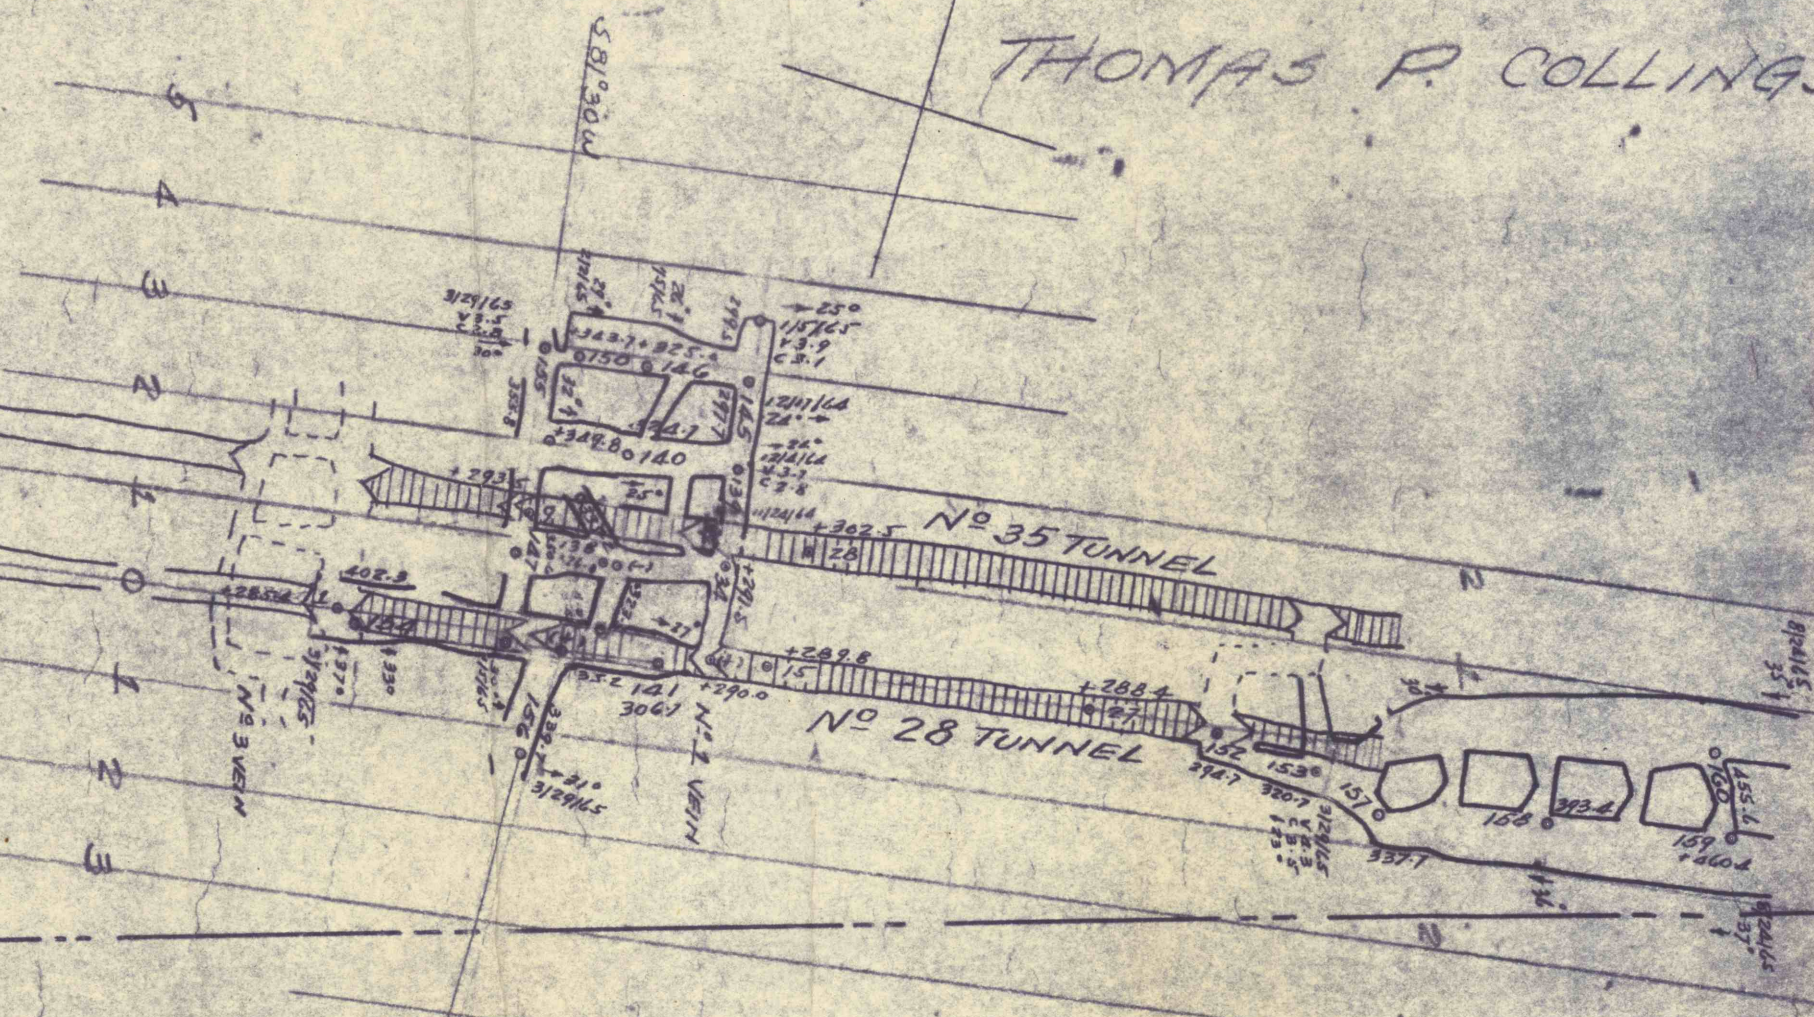

MARY MILLER ET AL.

TRUESDALE Colliery,
SCALE: 1"=100'
#218 SLOPE, NO. 1-VEIN
LUZERNE COUNTY, NORTHERN ANTHRACITE FIELD.

ZIBA BENNETT
COPRA