
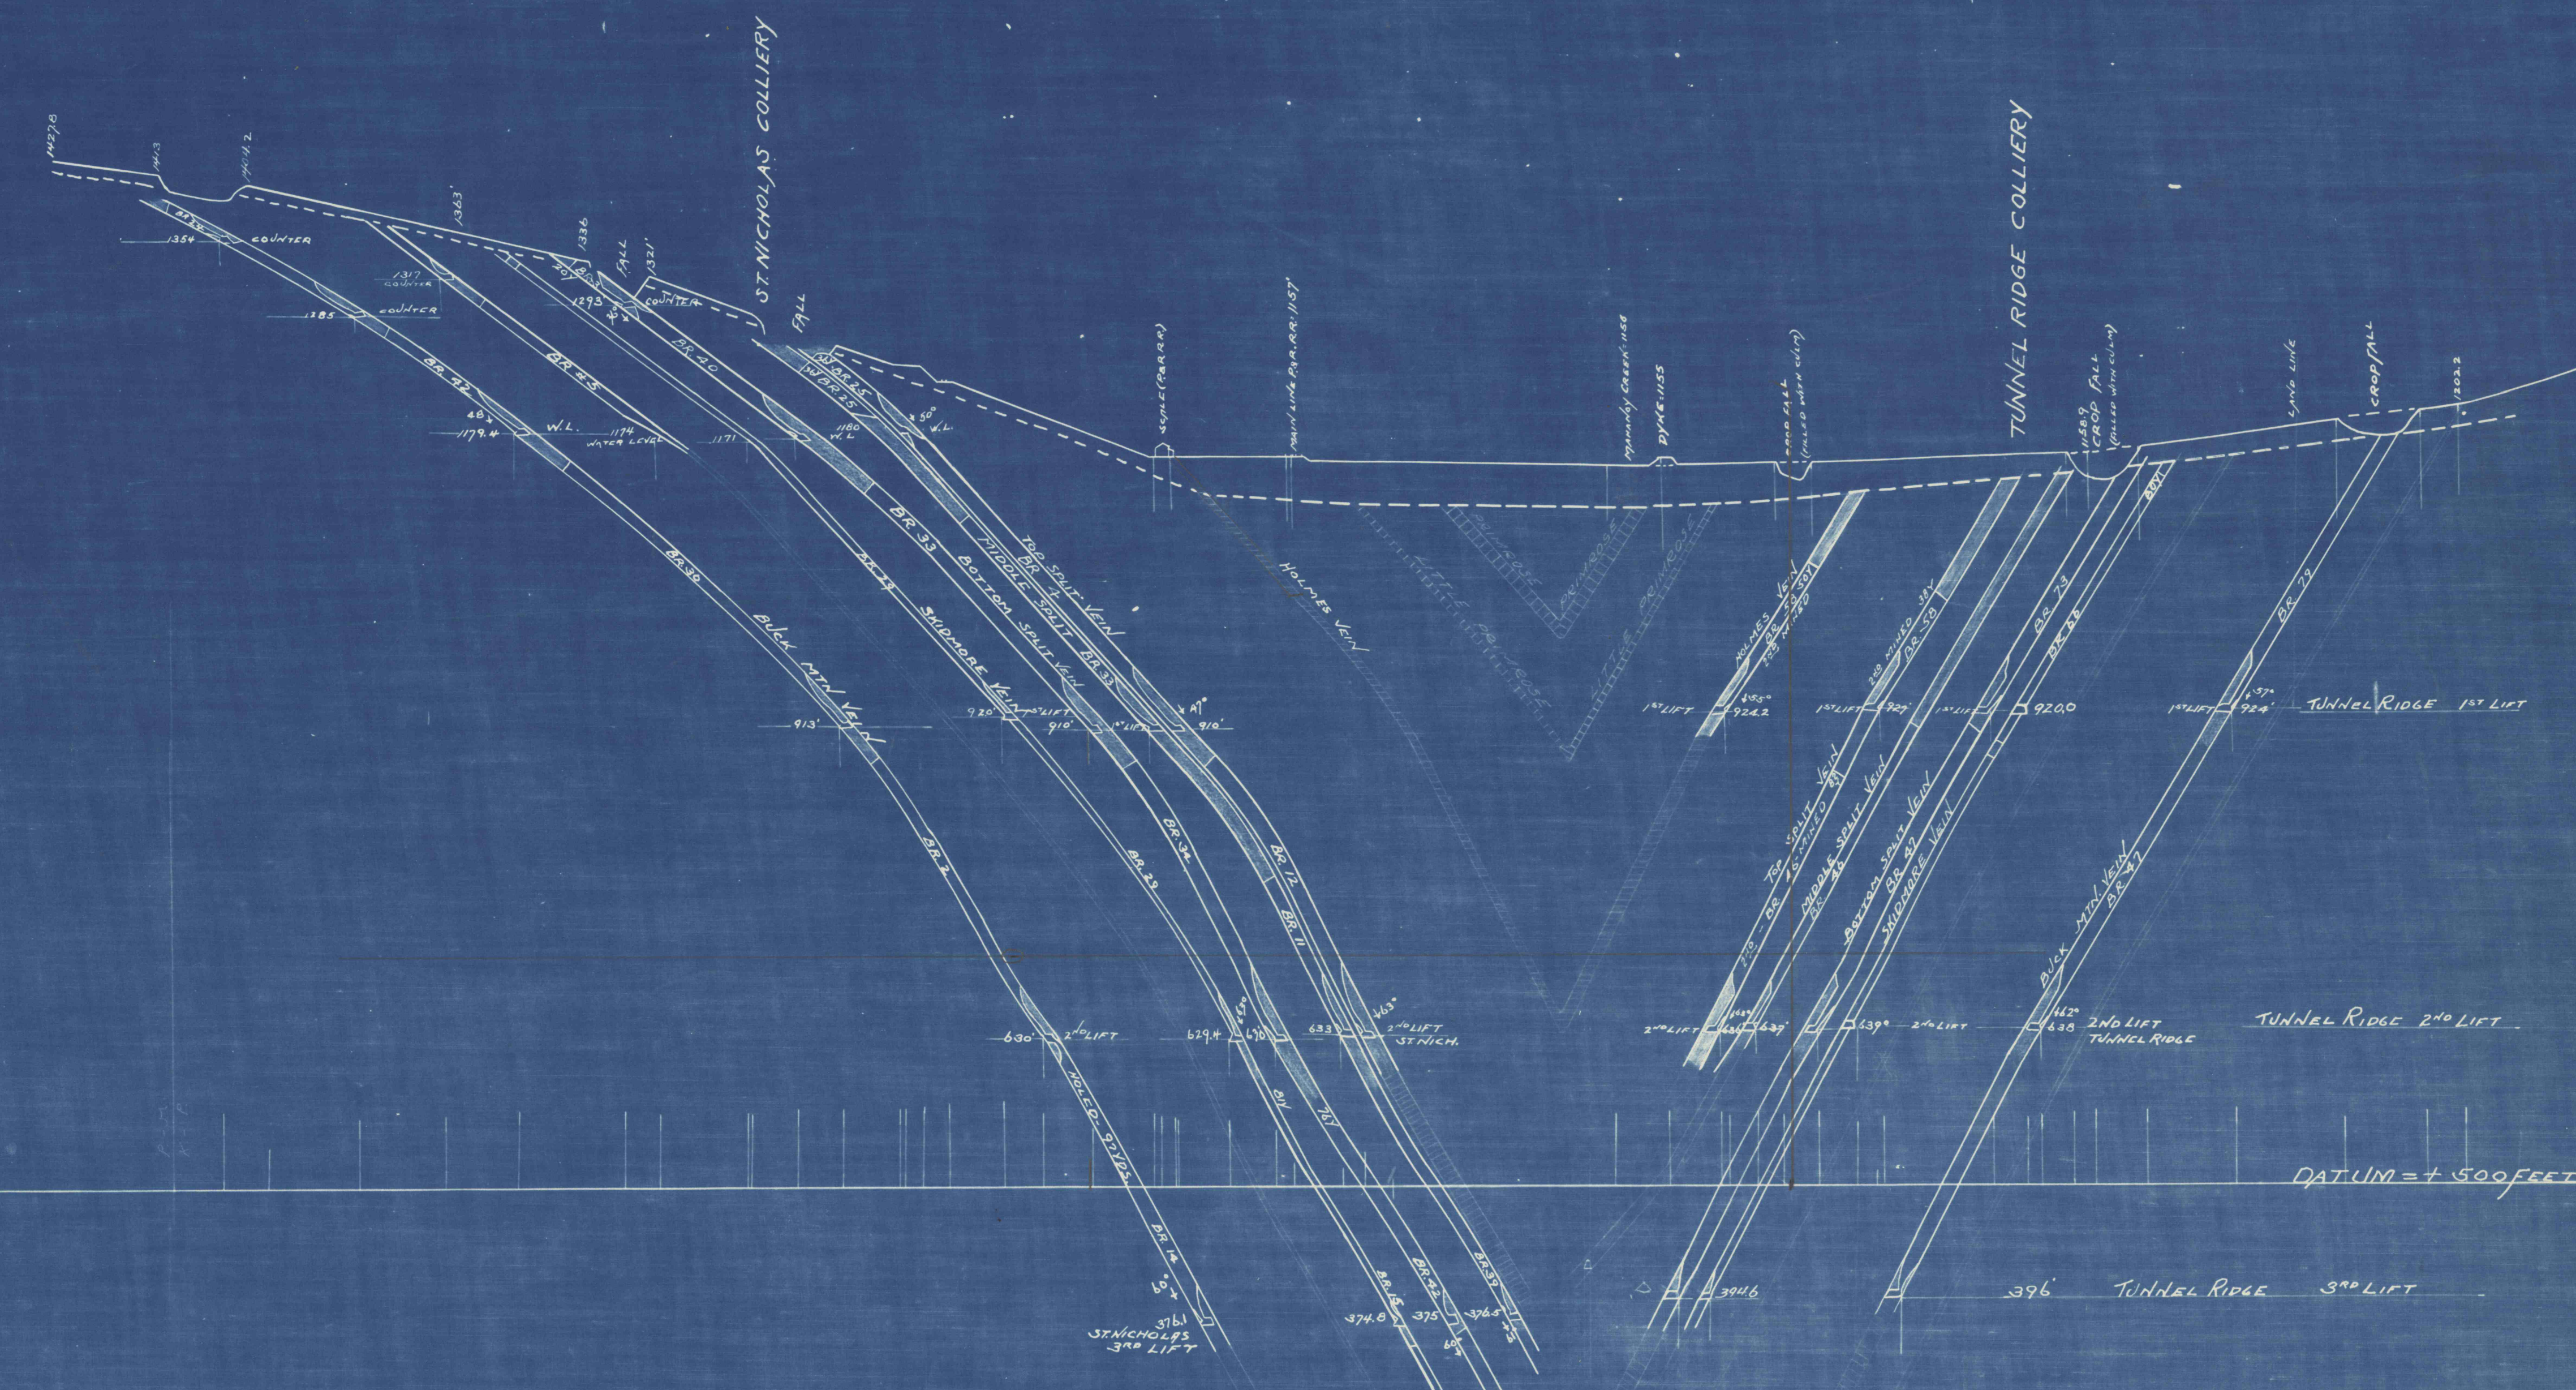


WESTERN Middle COAL FIELD. Tunnel Ridge Colliery.
 EAST MAHANOTY TWP, CHUYLKILL COUNTY PA,
 10 E. MAH. DISTRICT. READ G ANTHRACITE COLLIERIES.
 Section No 31- 1700 Feet West of Gunboat Hoisting Slope

Same as St Nich X.S #17

Section No 32- 3660 Feet West of Gunboat Hoisting Slope

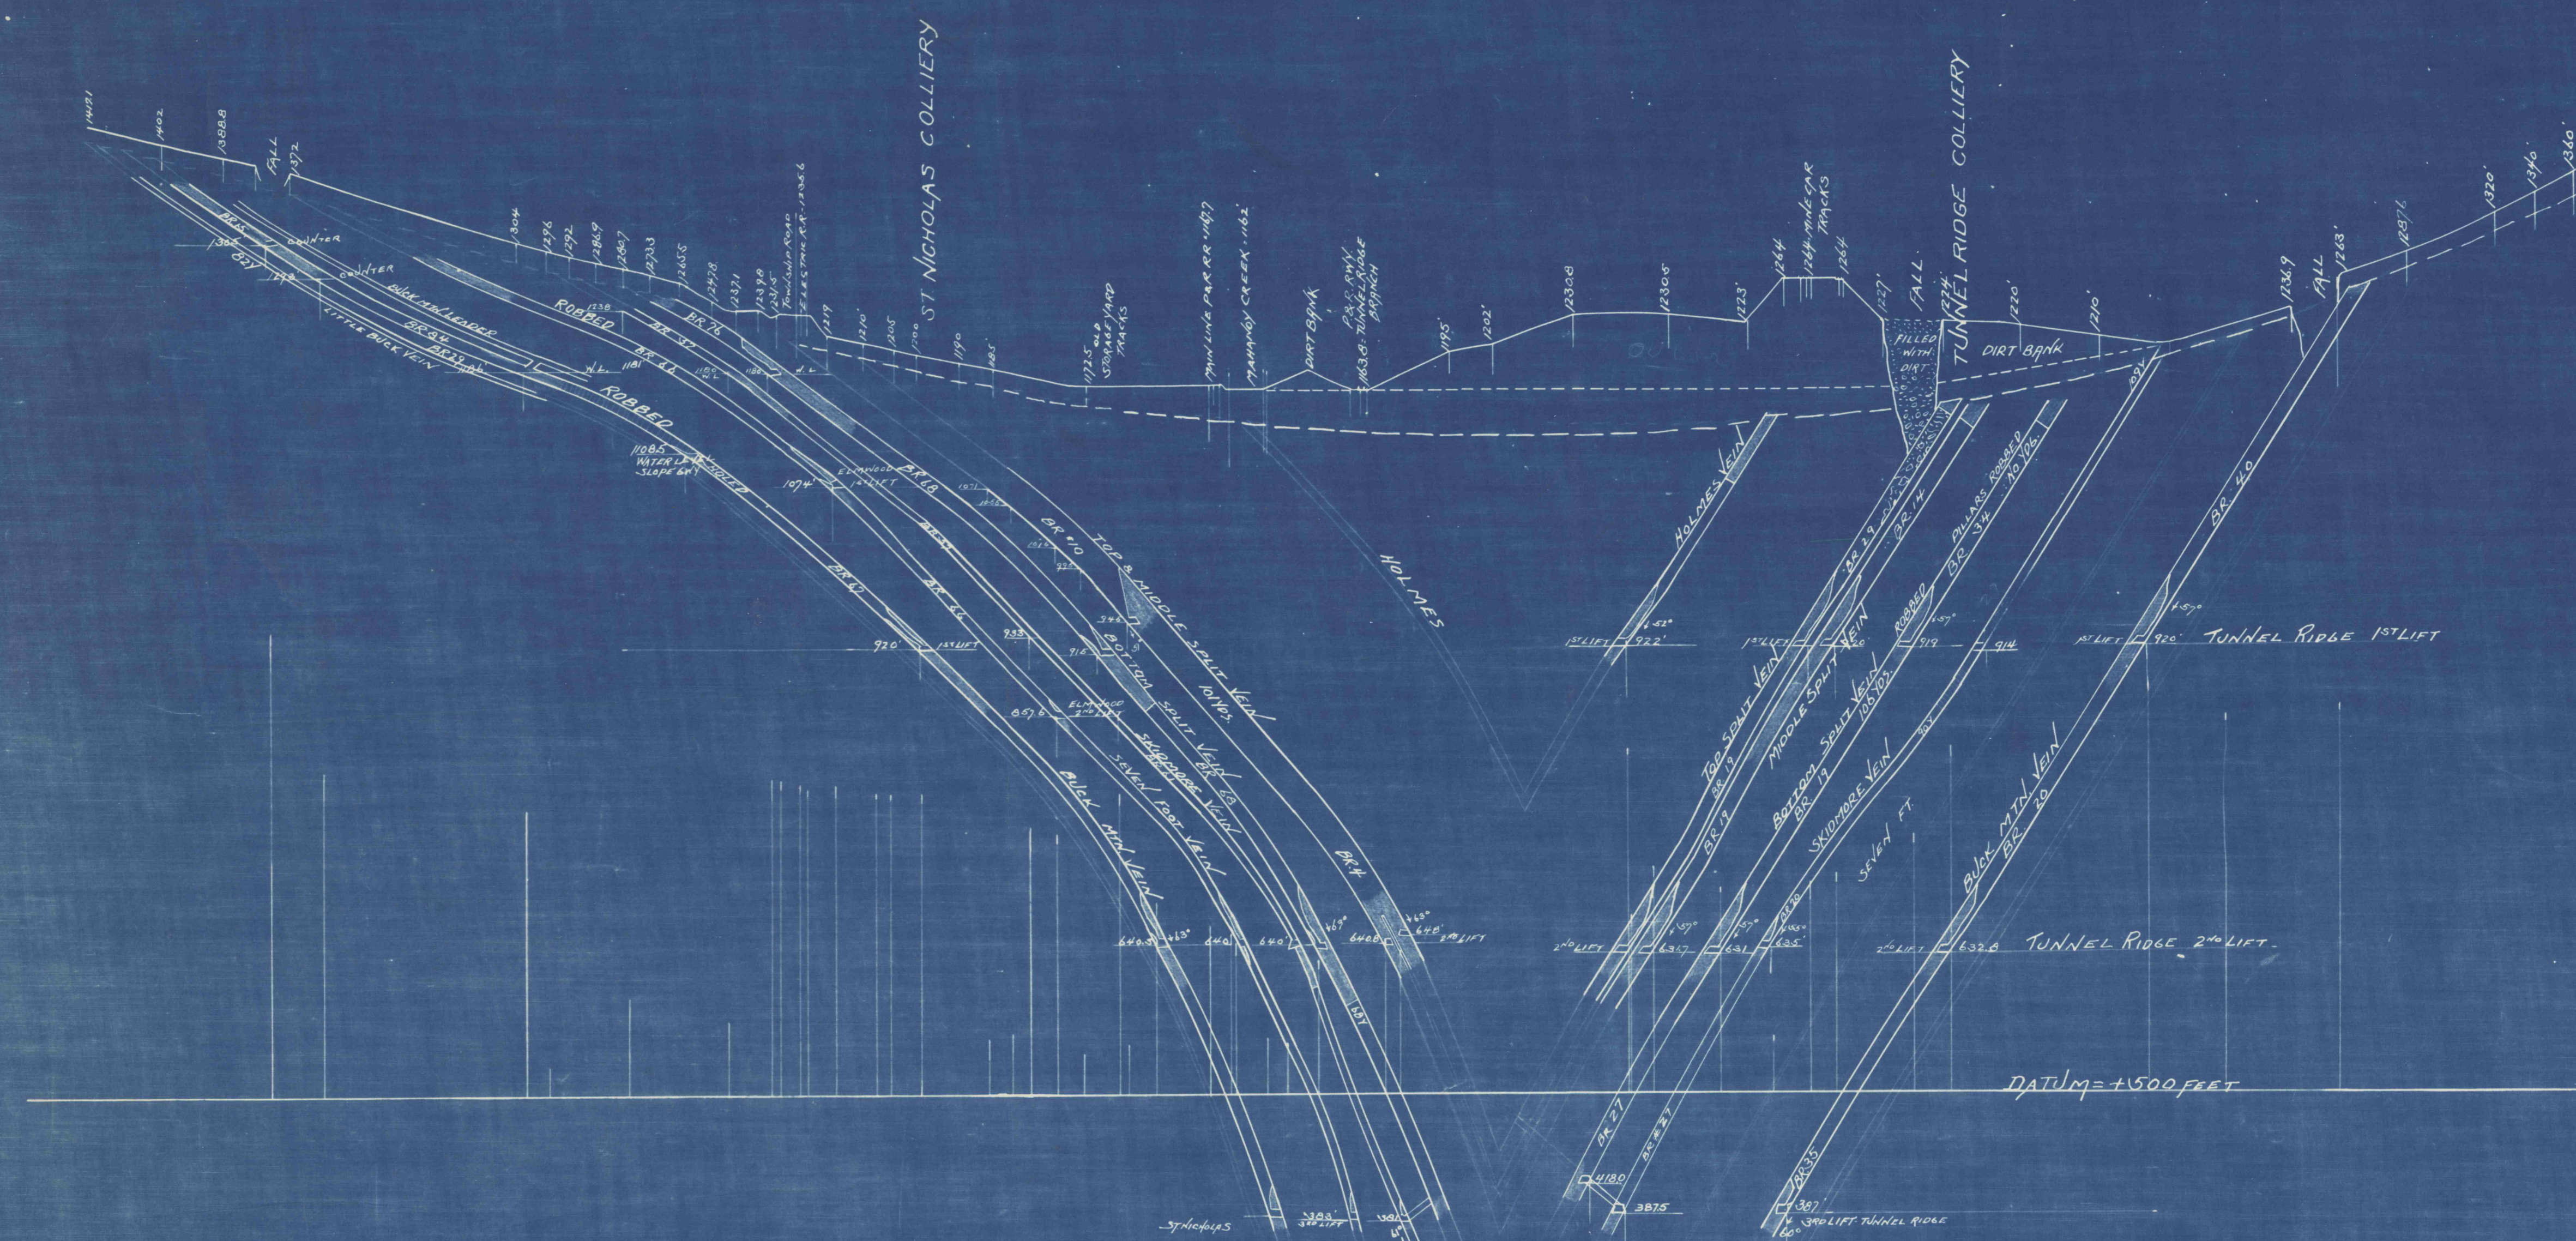

APR 30 1975
 100
 100

DATUM = 0

DATUM = 0

ME
 APR 30 1975