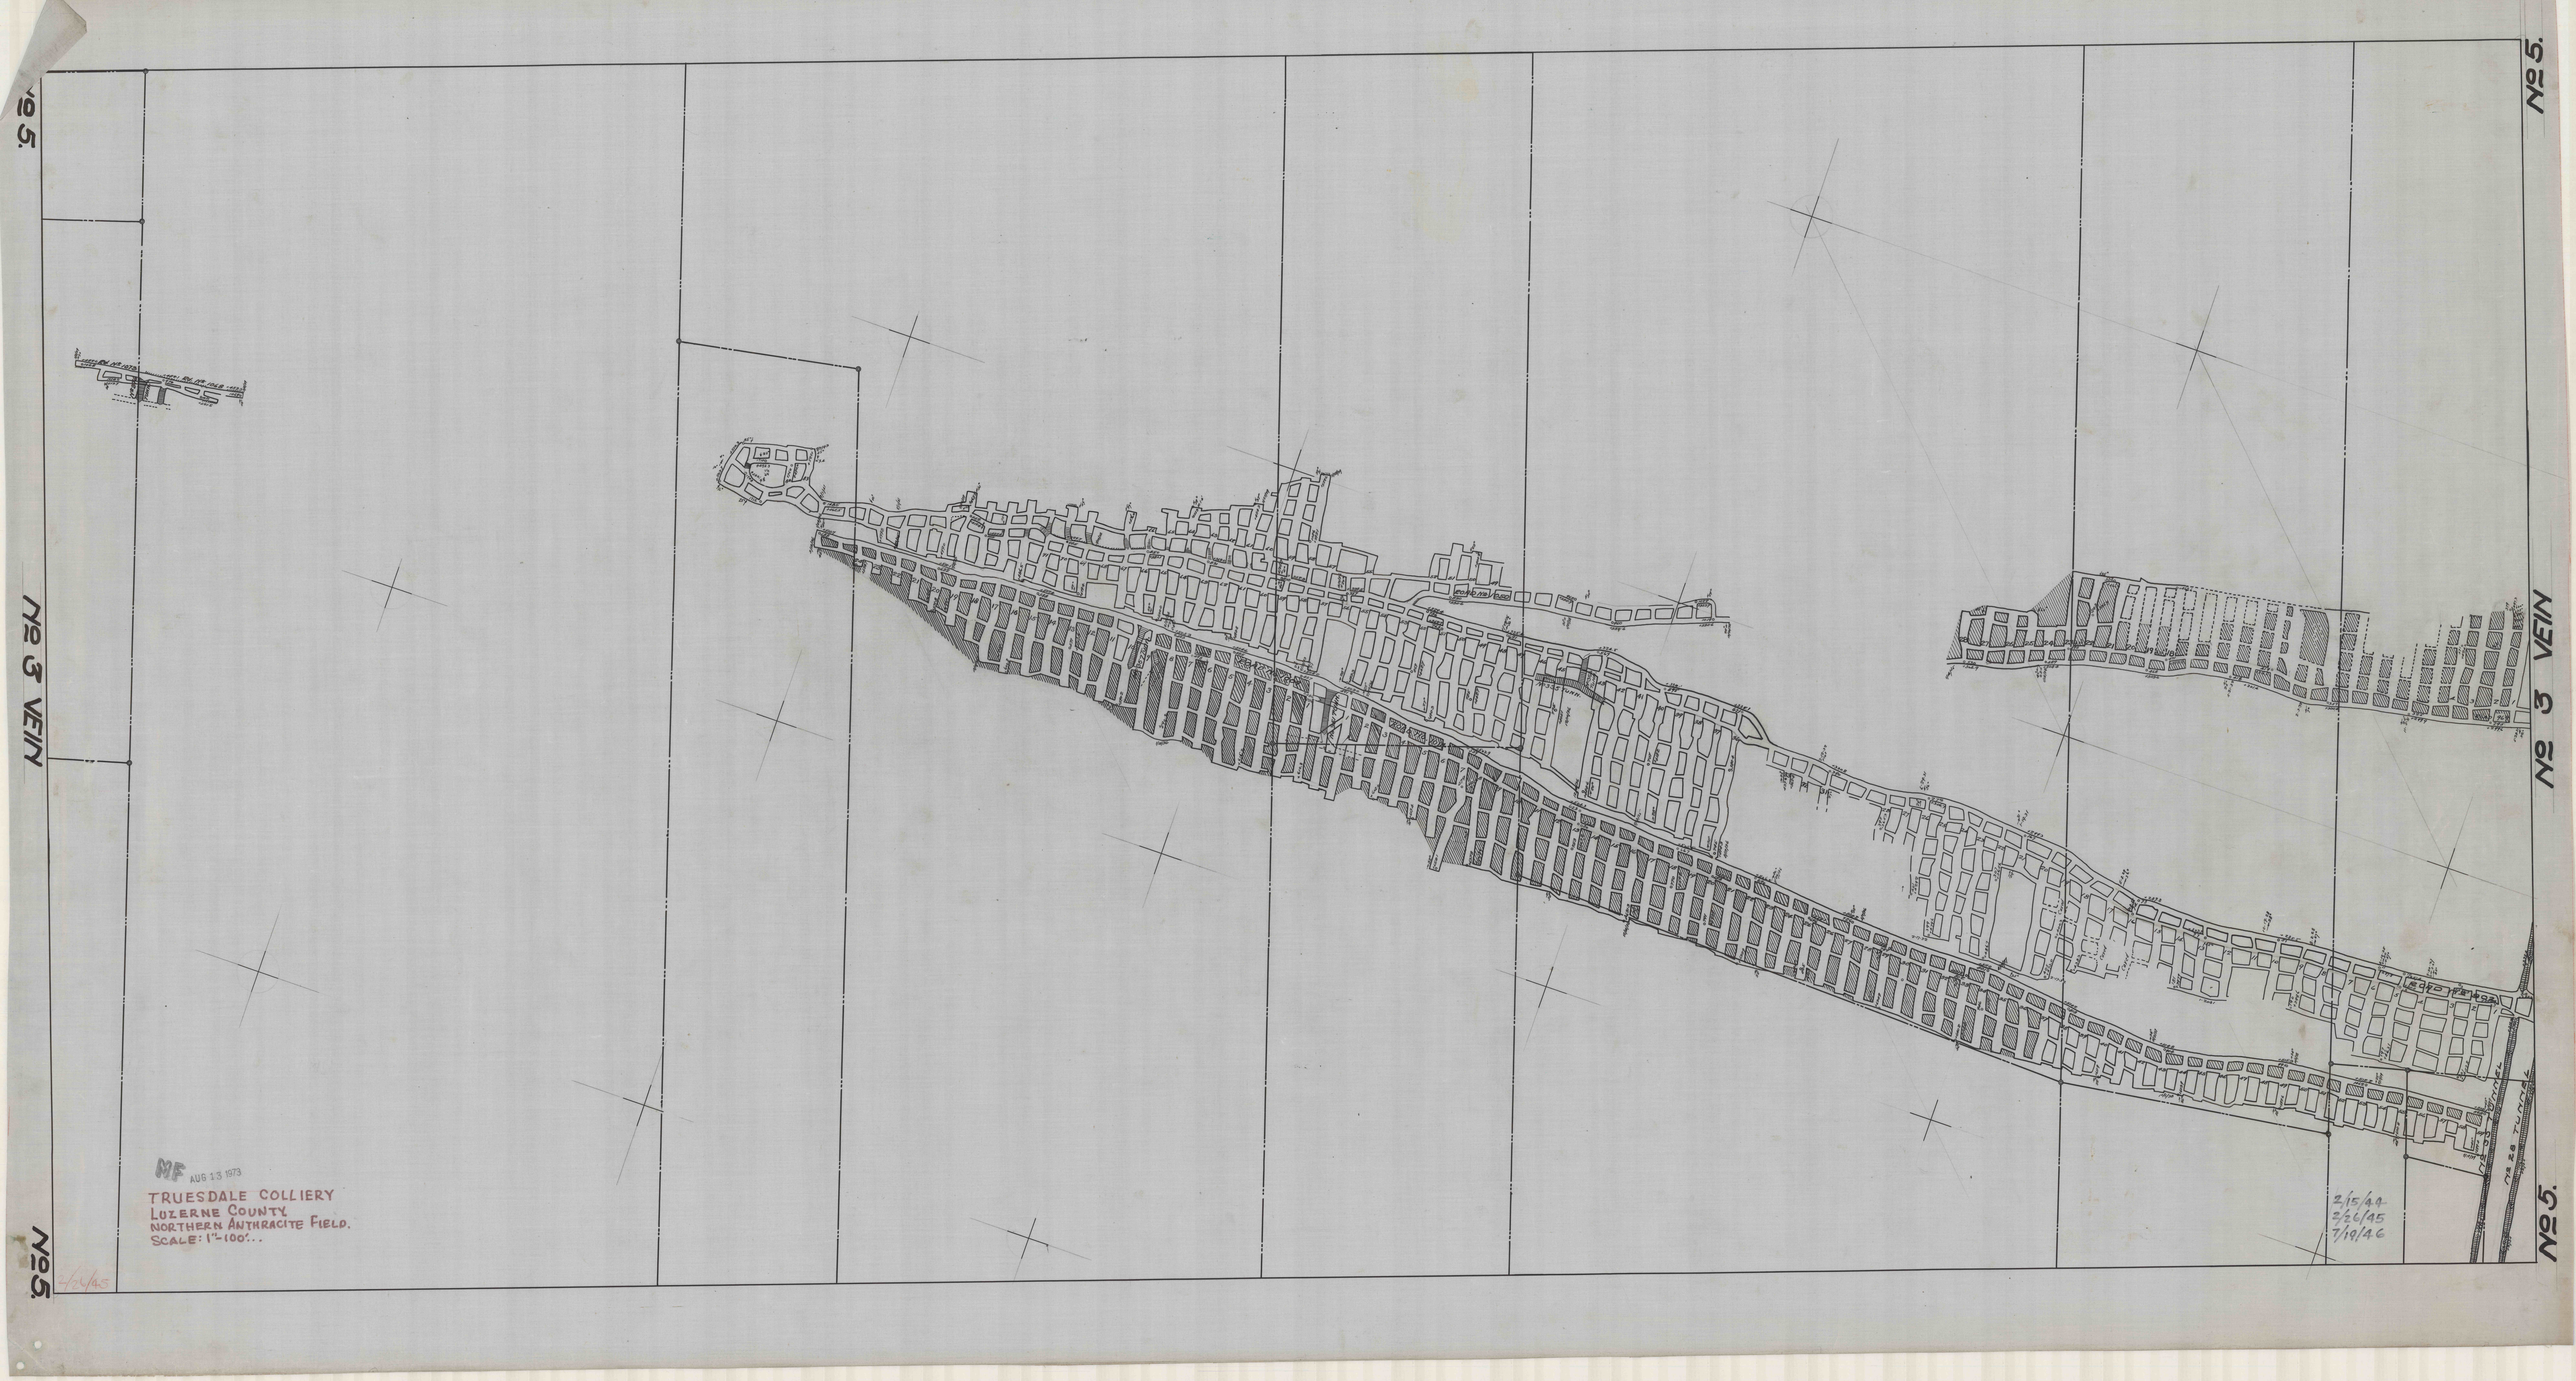
No 5.
No 3 VEIN
No 5.
No 5.
No 3 VEIN
No 5.
MF AUG 13 1973
TRUESDALE COLLIERY
LUZERNE COUNTY
NORTHERN ANTHRACITE FIELD.
SCALE: 1"=100'..
2/15/42
2/26/45
7/19/46