


Mills & Vein

MS 6

MF
AUG 13 1873

TRUESDALE COLLIERY
SCALE: 1"=100'. LUZERNE CO.
NORTHERN ANTHRACITE FLD.

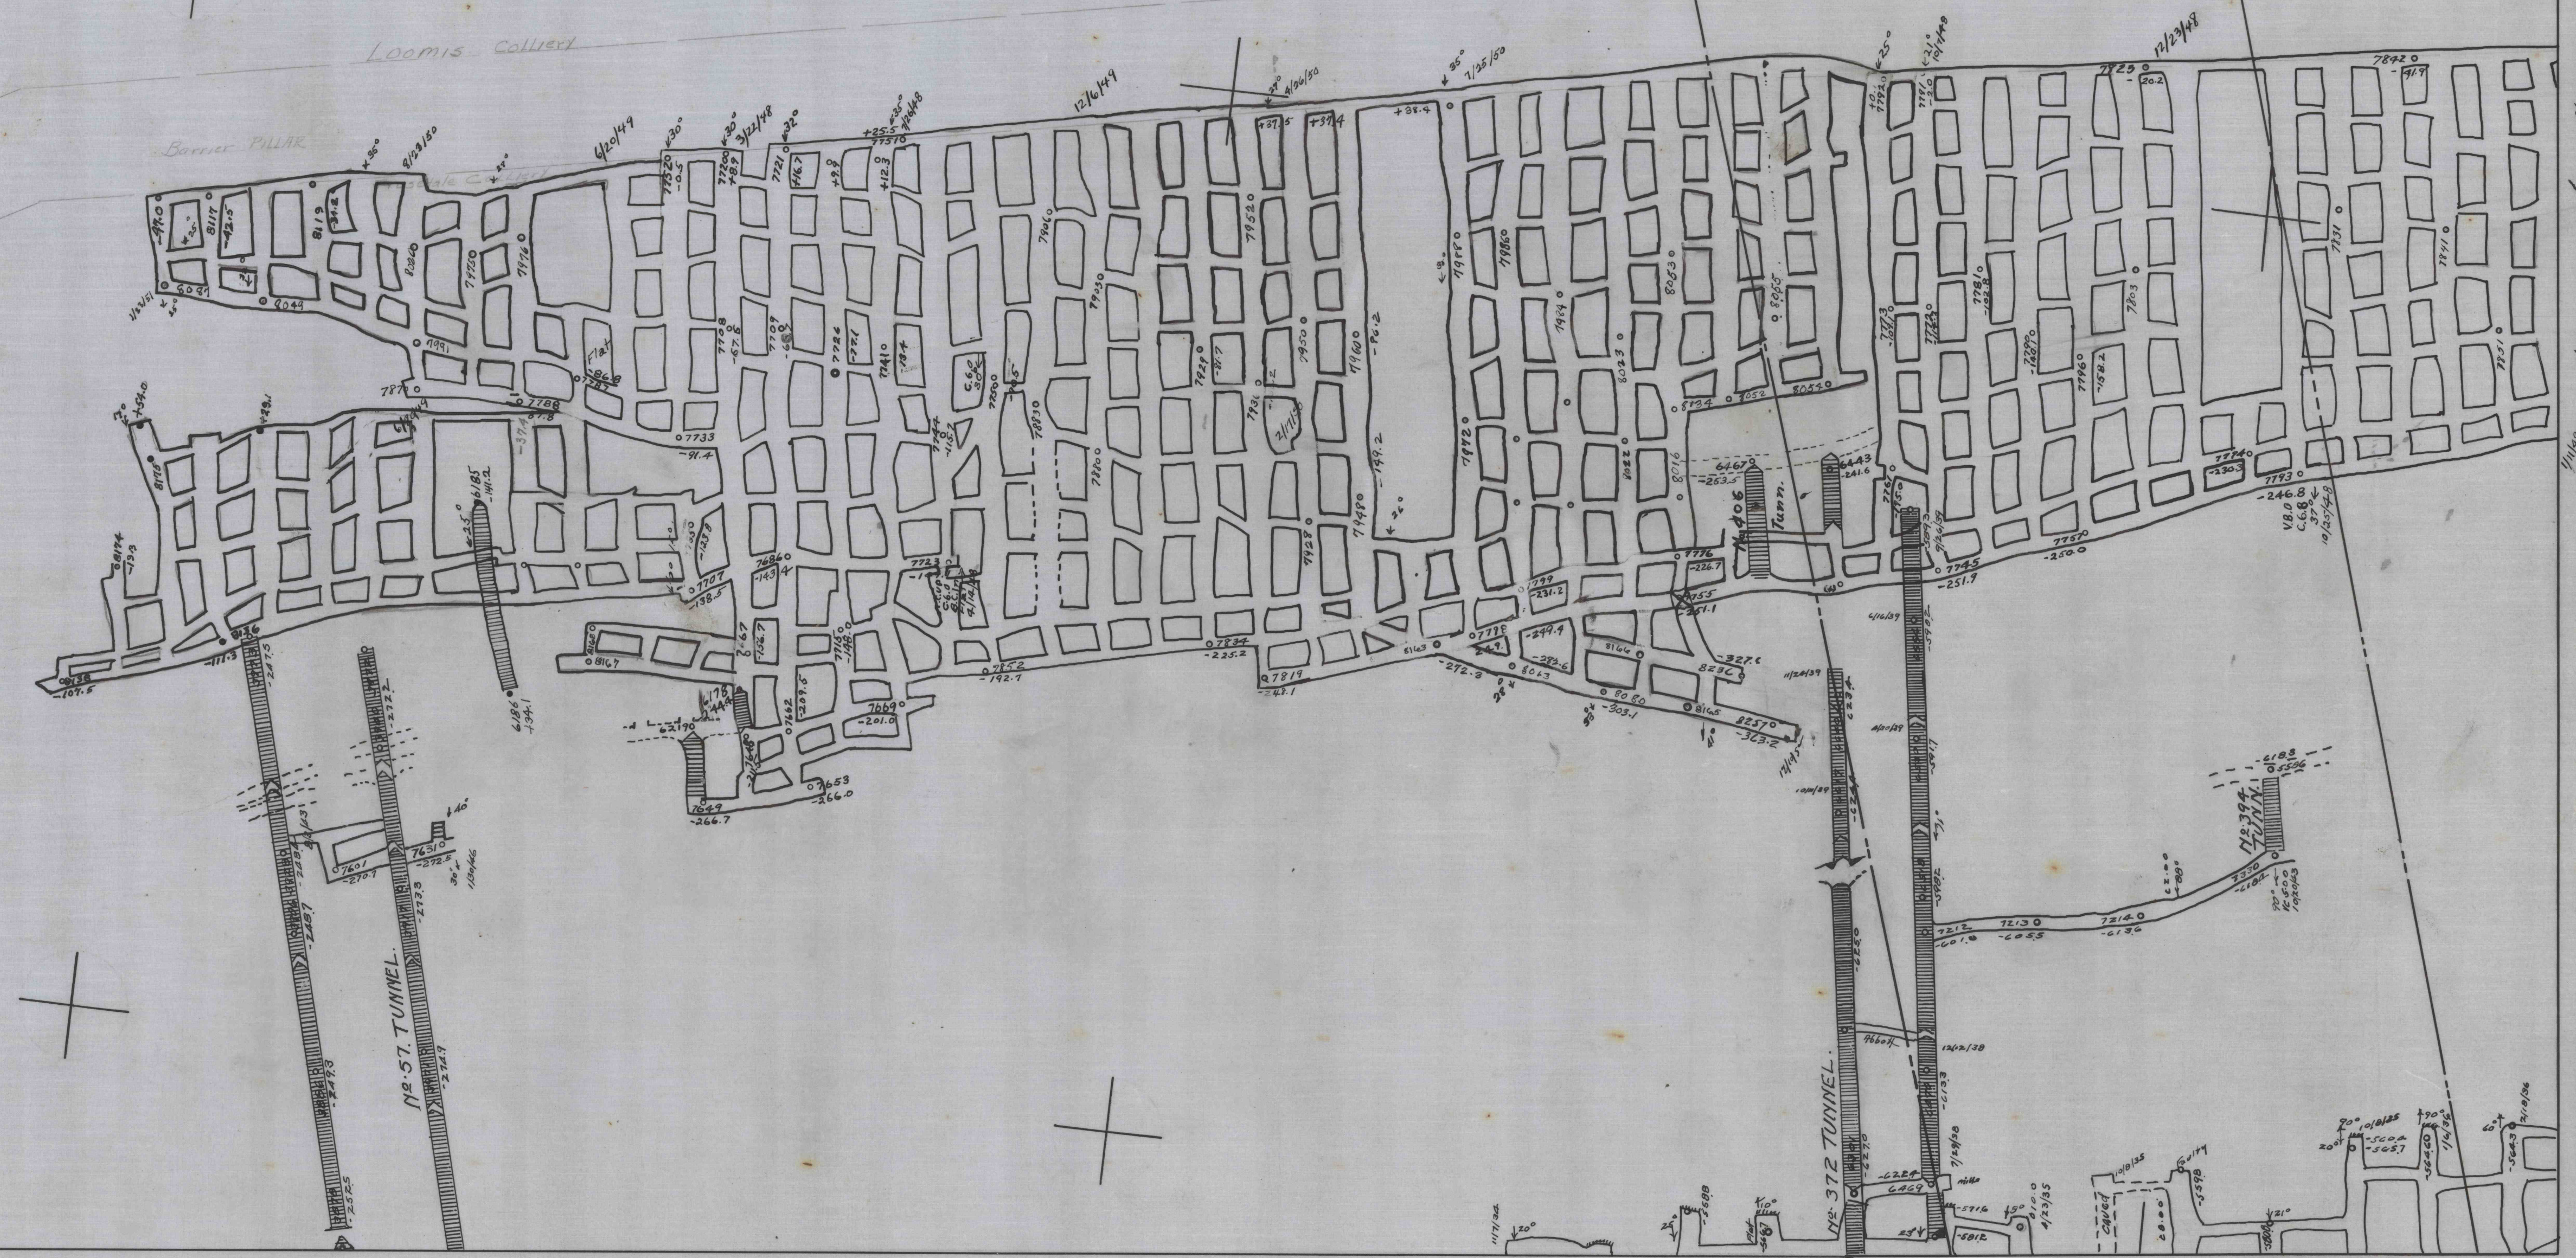

Mills & Vein

MS 6