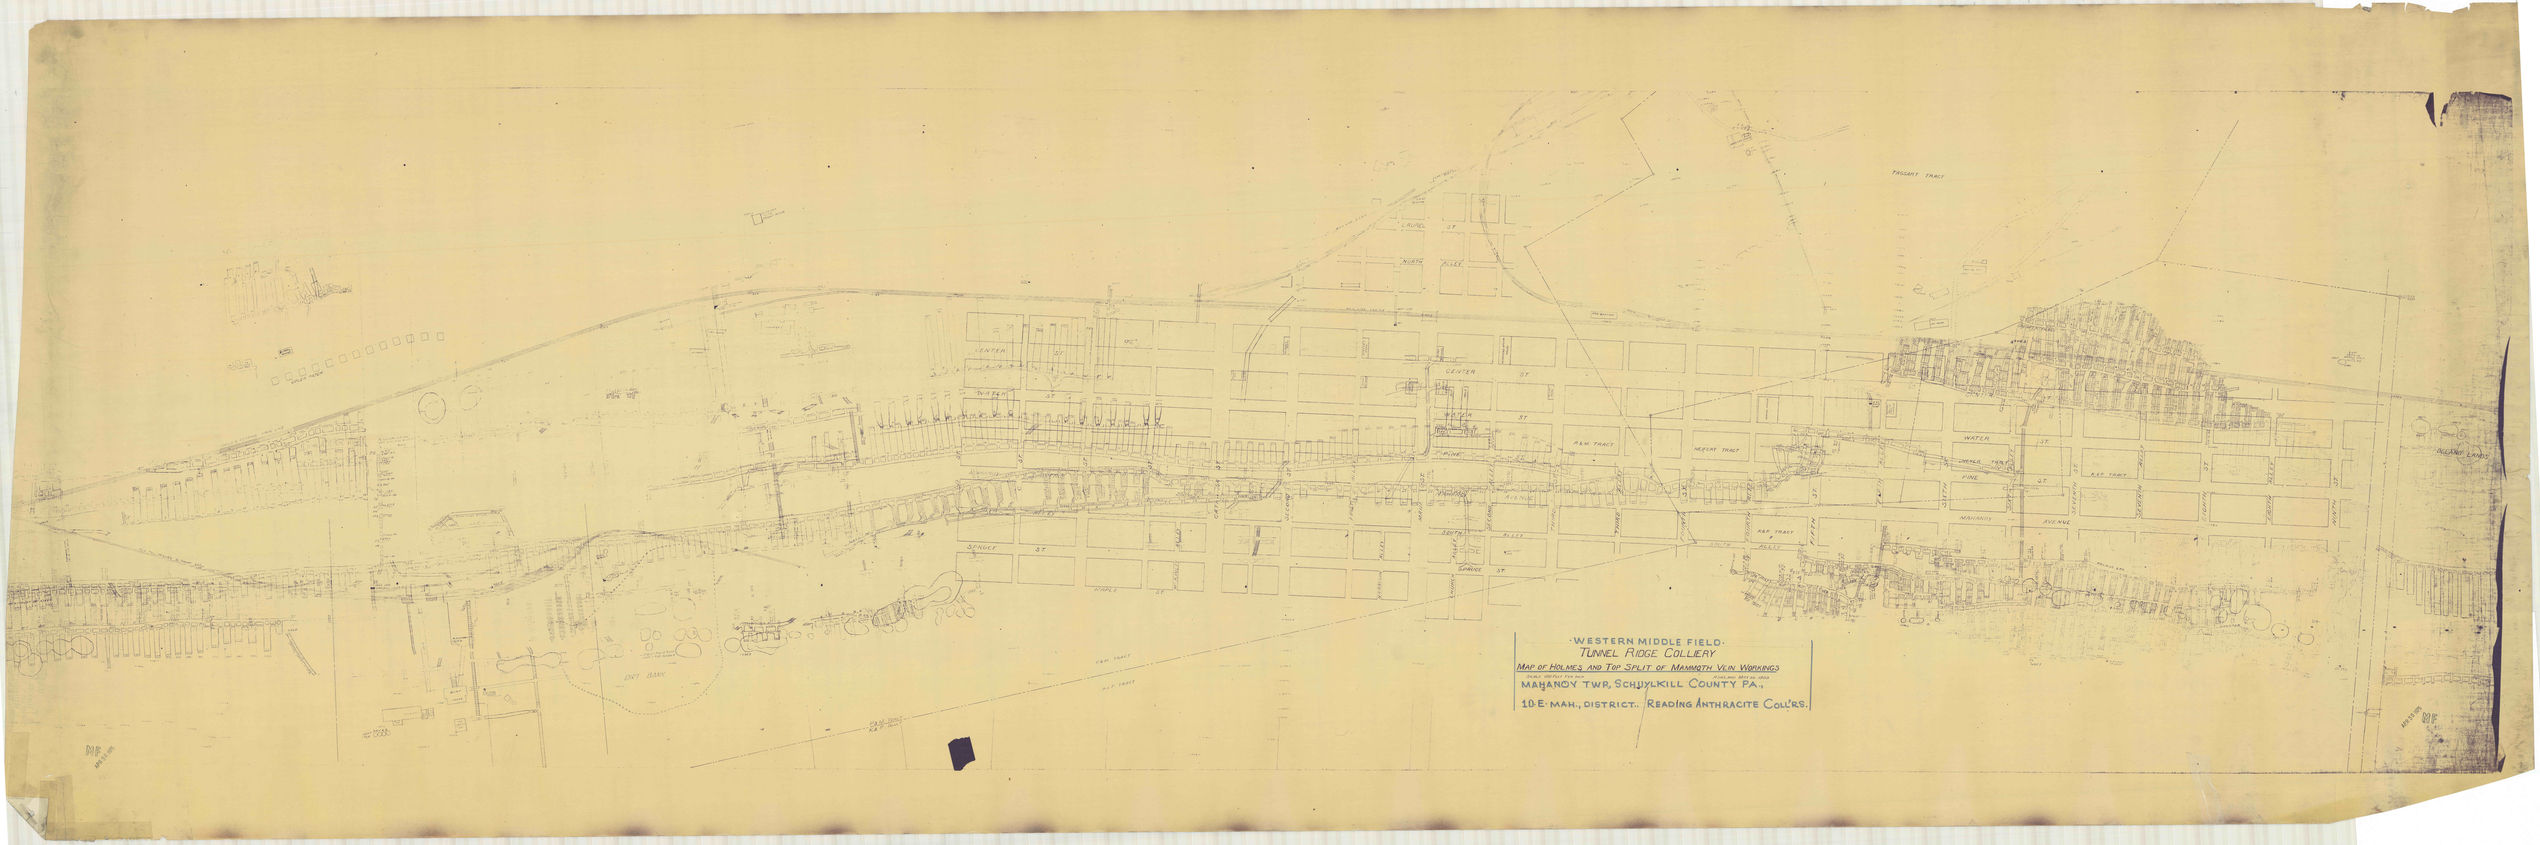
·WESTERN MIDDLE FIELD·
TUNNEL RIDGE COLLIERY
MAP OF HOLMES AND TOP SPLIT OF MAMMOTH VEIN WORKINGS
MAHANOY TWP, SCHUYLKILL COUNTY PA.
10 E MAH., DISTRICT. READING ANTHRACITE COL'RS.