


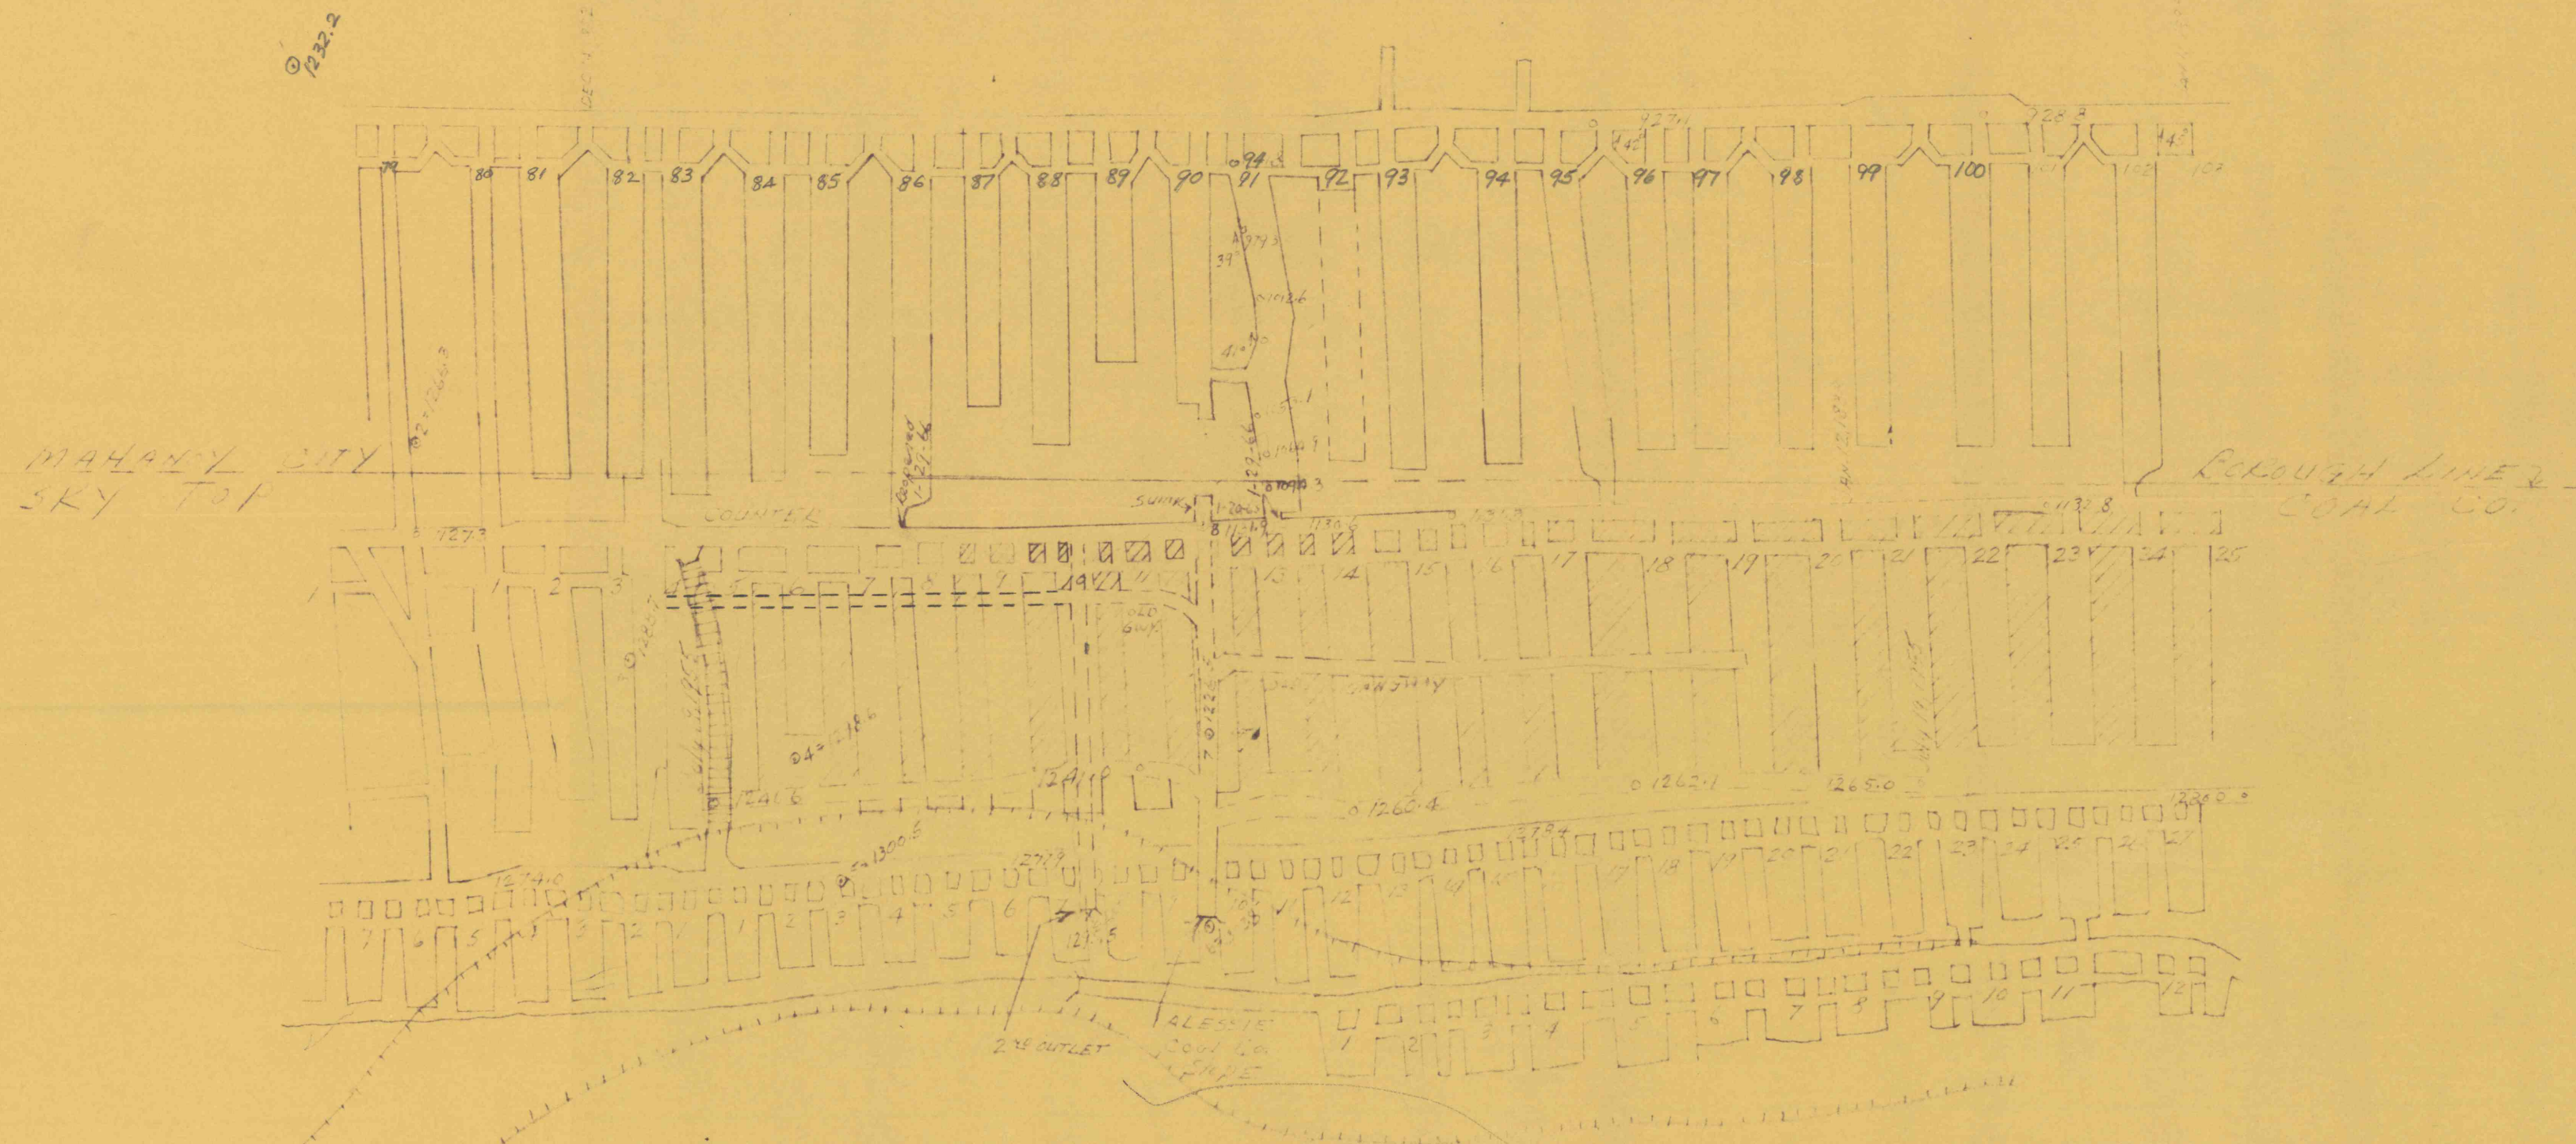

APR 30 1975

Map showing ALESSIE Coal Co., and
 Buck Mountain vein-mine workings, situated
 in Mahanoy Township, Schuylkill County, Pa.
 scale 1"=100.. Sept. 20, 1965. John C. Pries Jr.
 posted 1-29-66

BAD PRINT NO "MF"
 30 APR. 75