


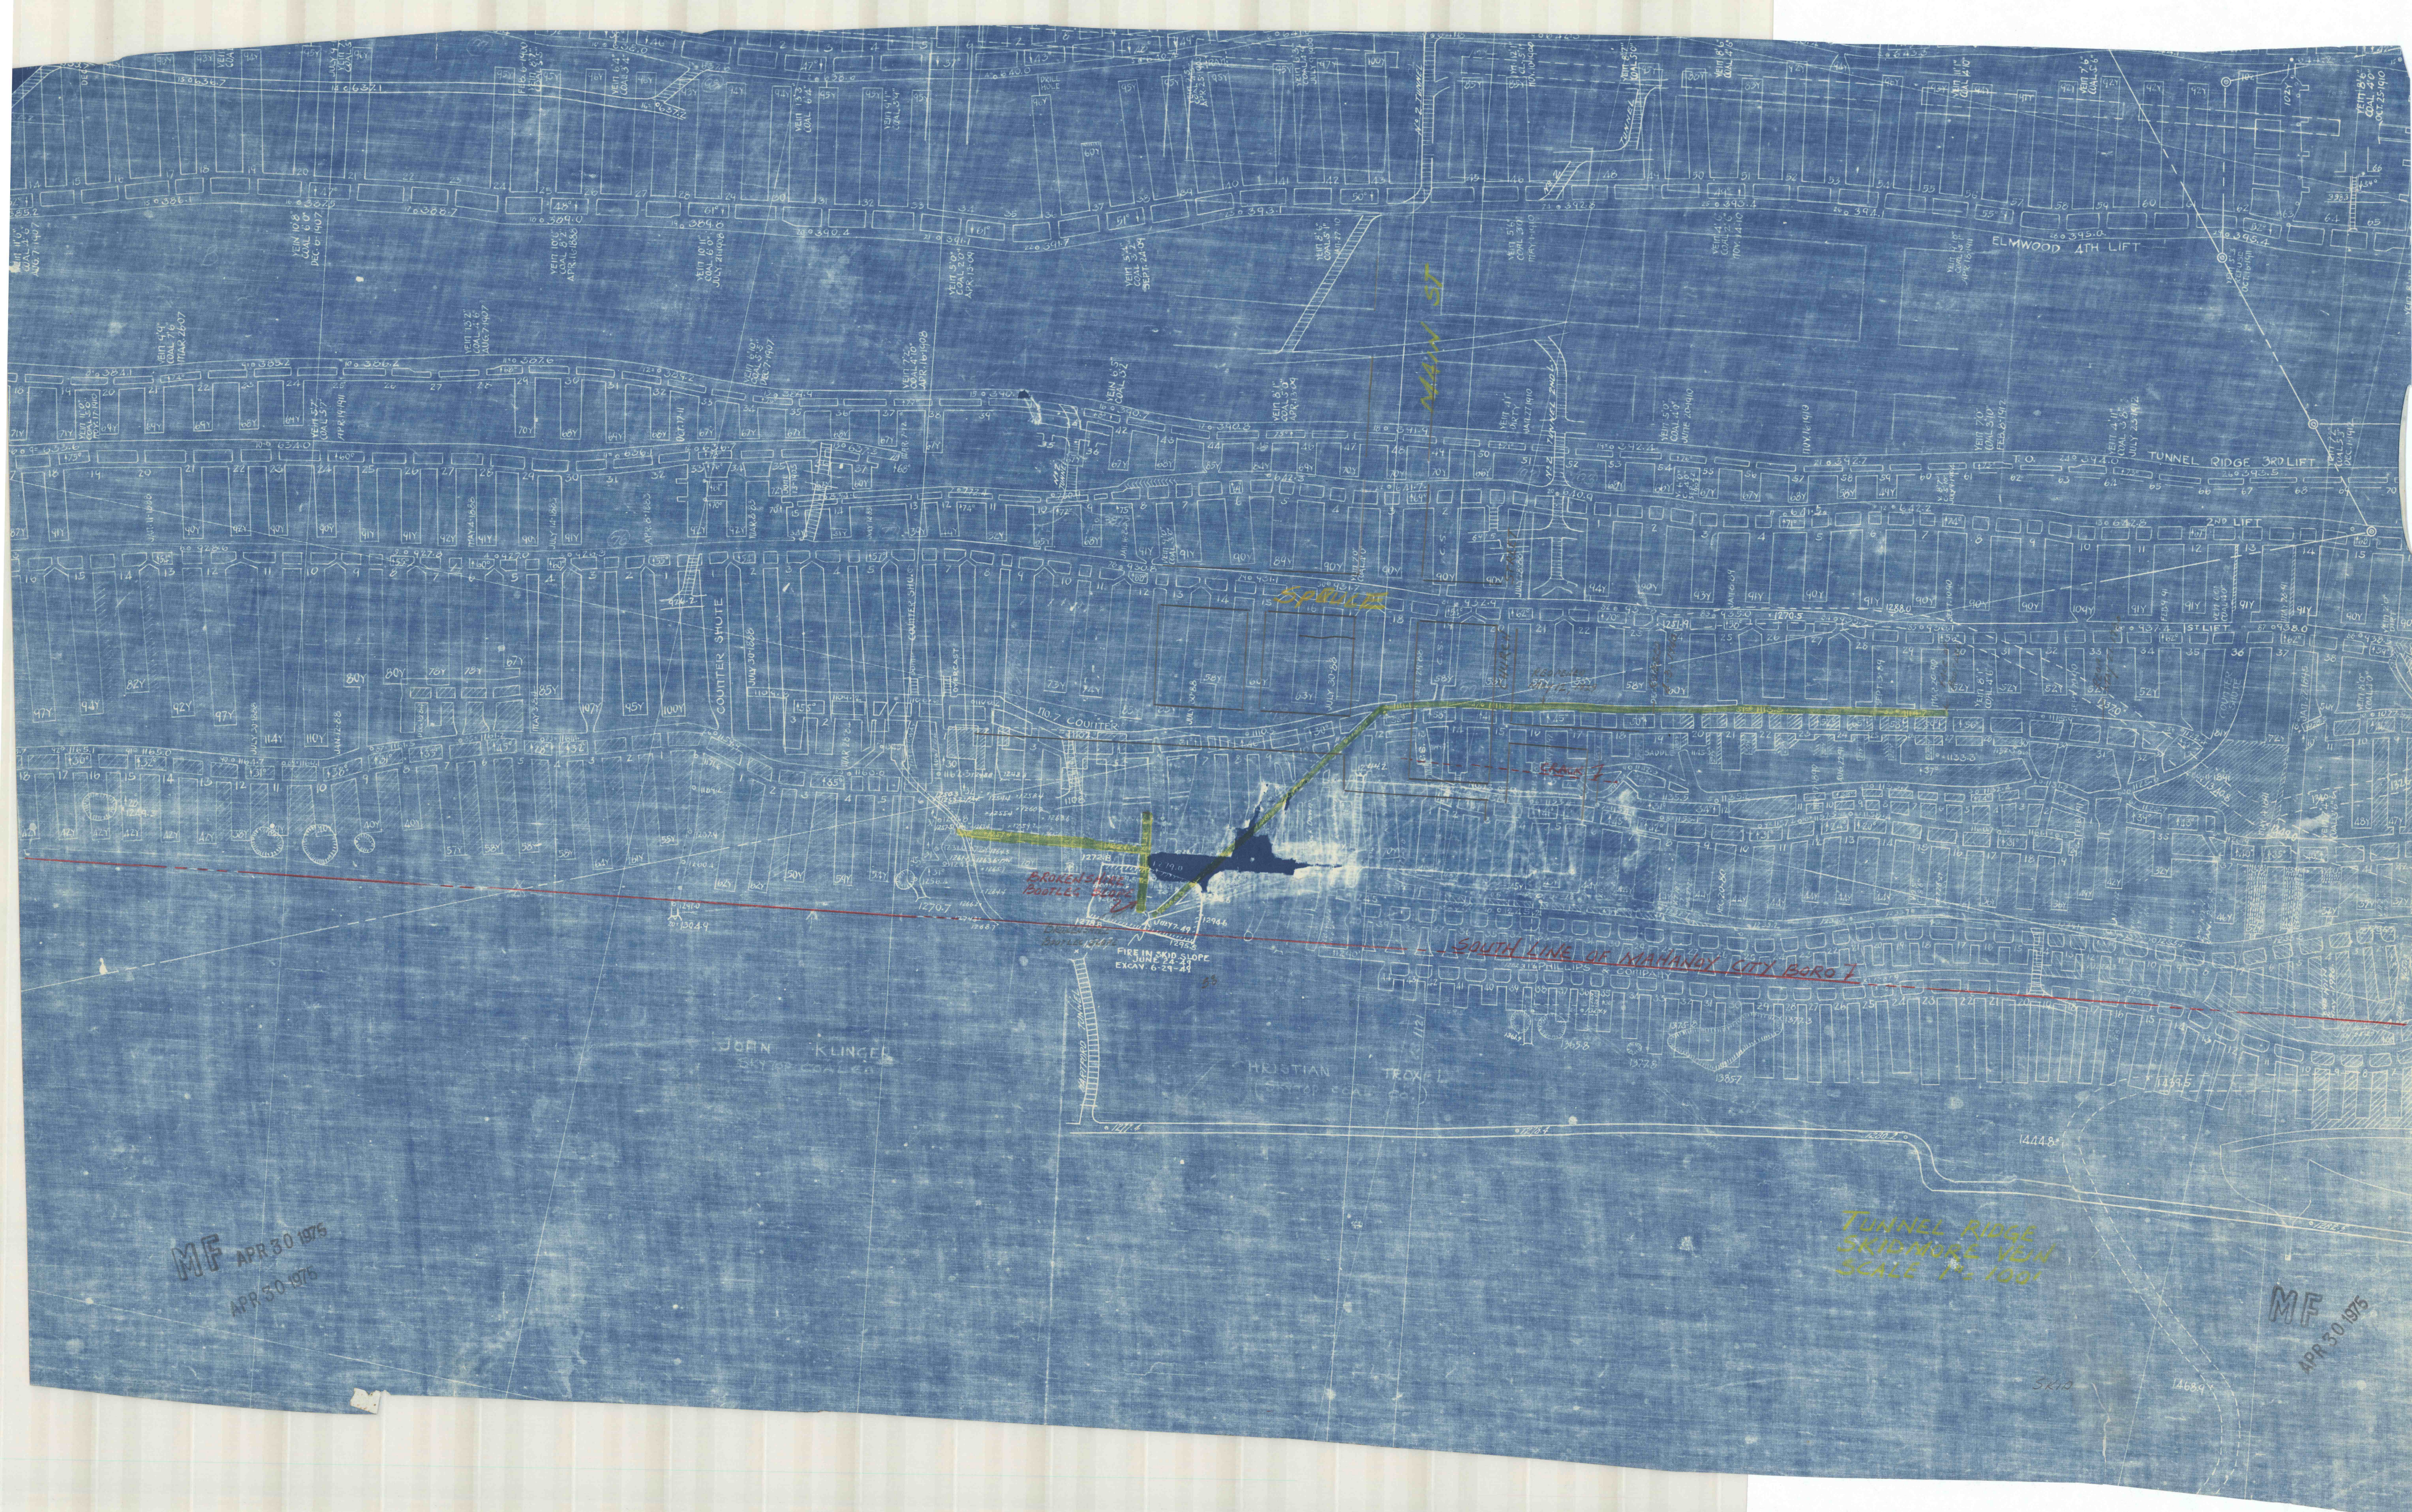

MF APR 30 1975
APR 30 1975

TUNNEL RIDGE
SKIDMORE VEIN
SCALE 1" = 100'

MF
APR 30 1975