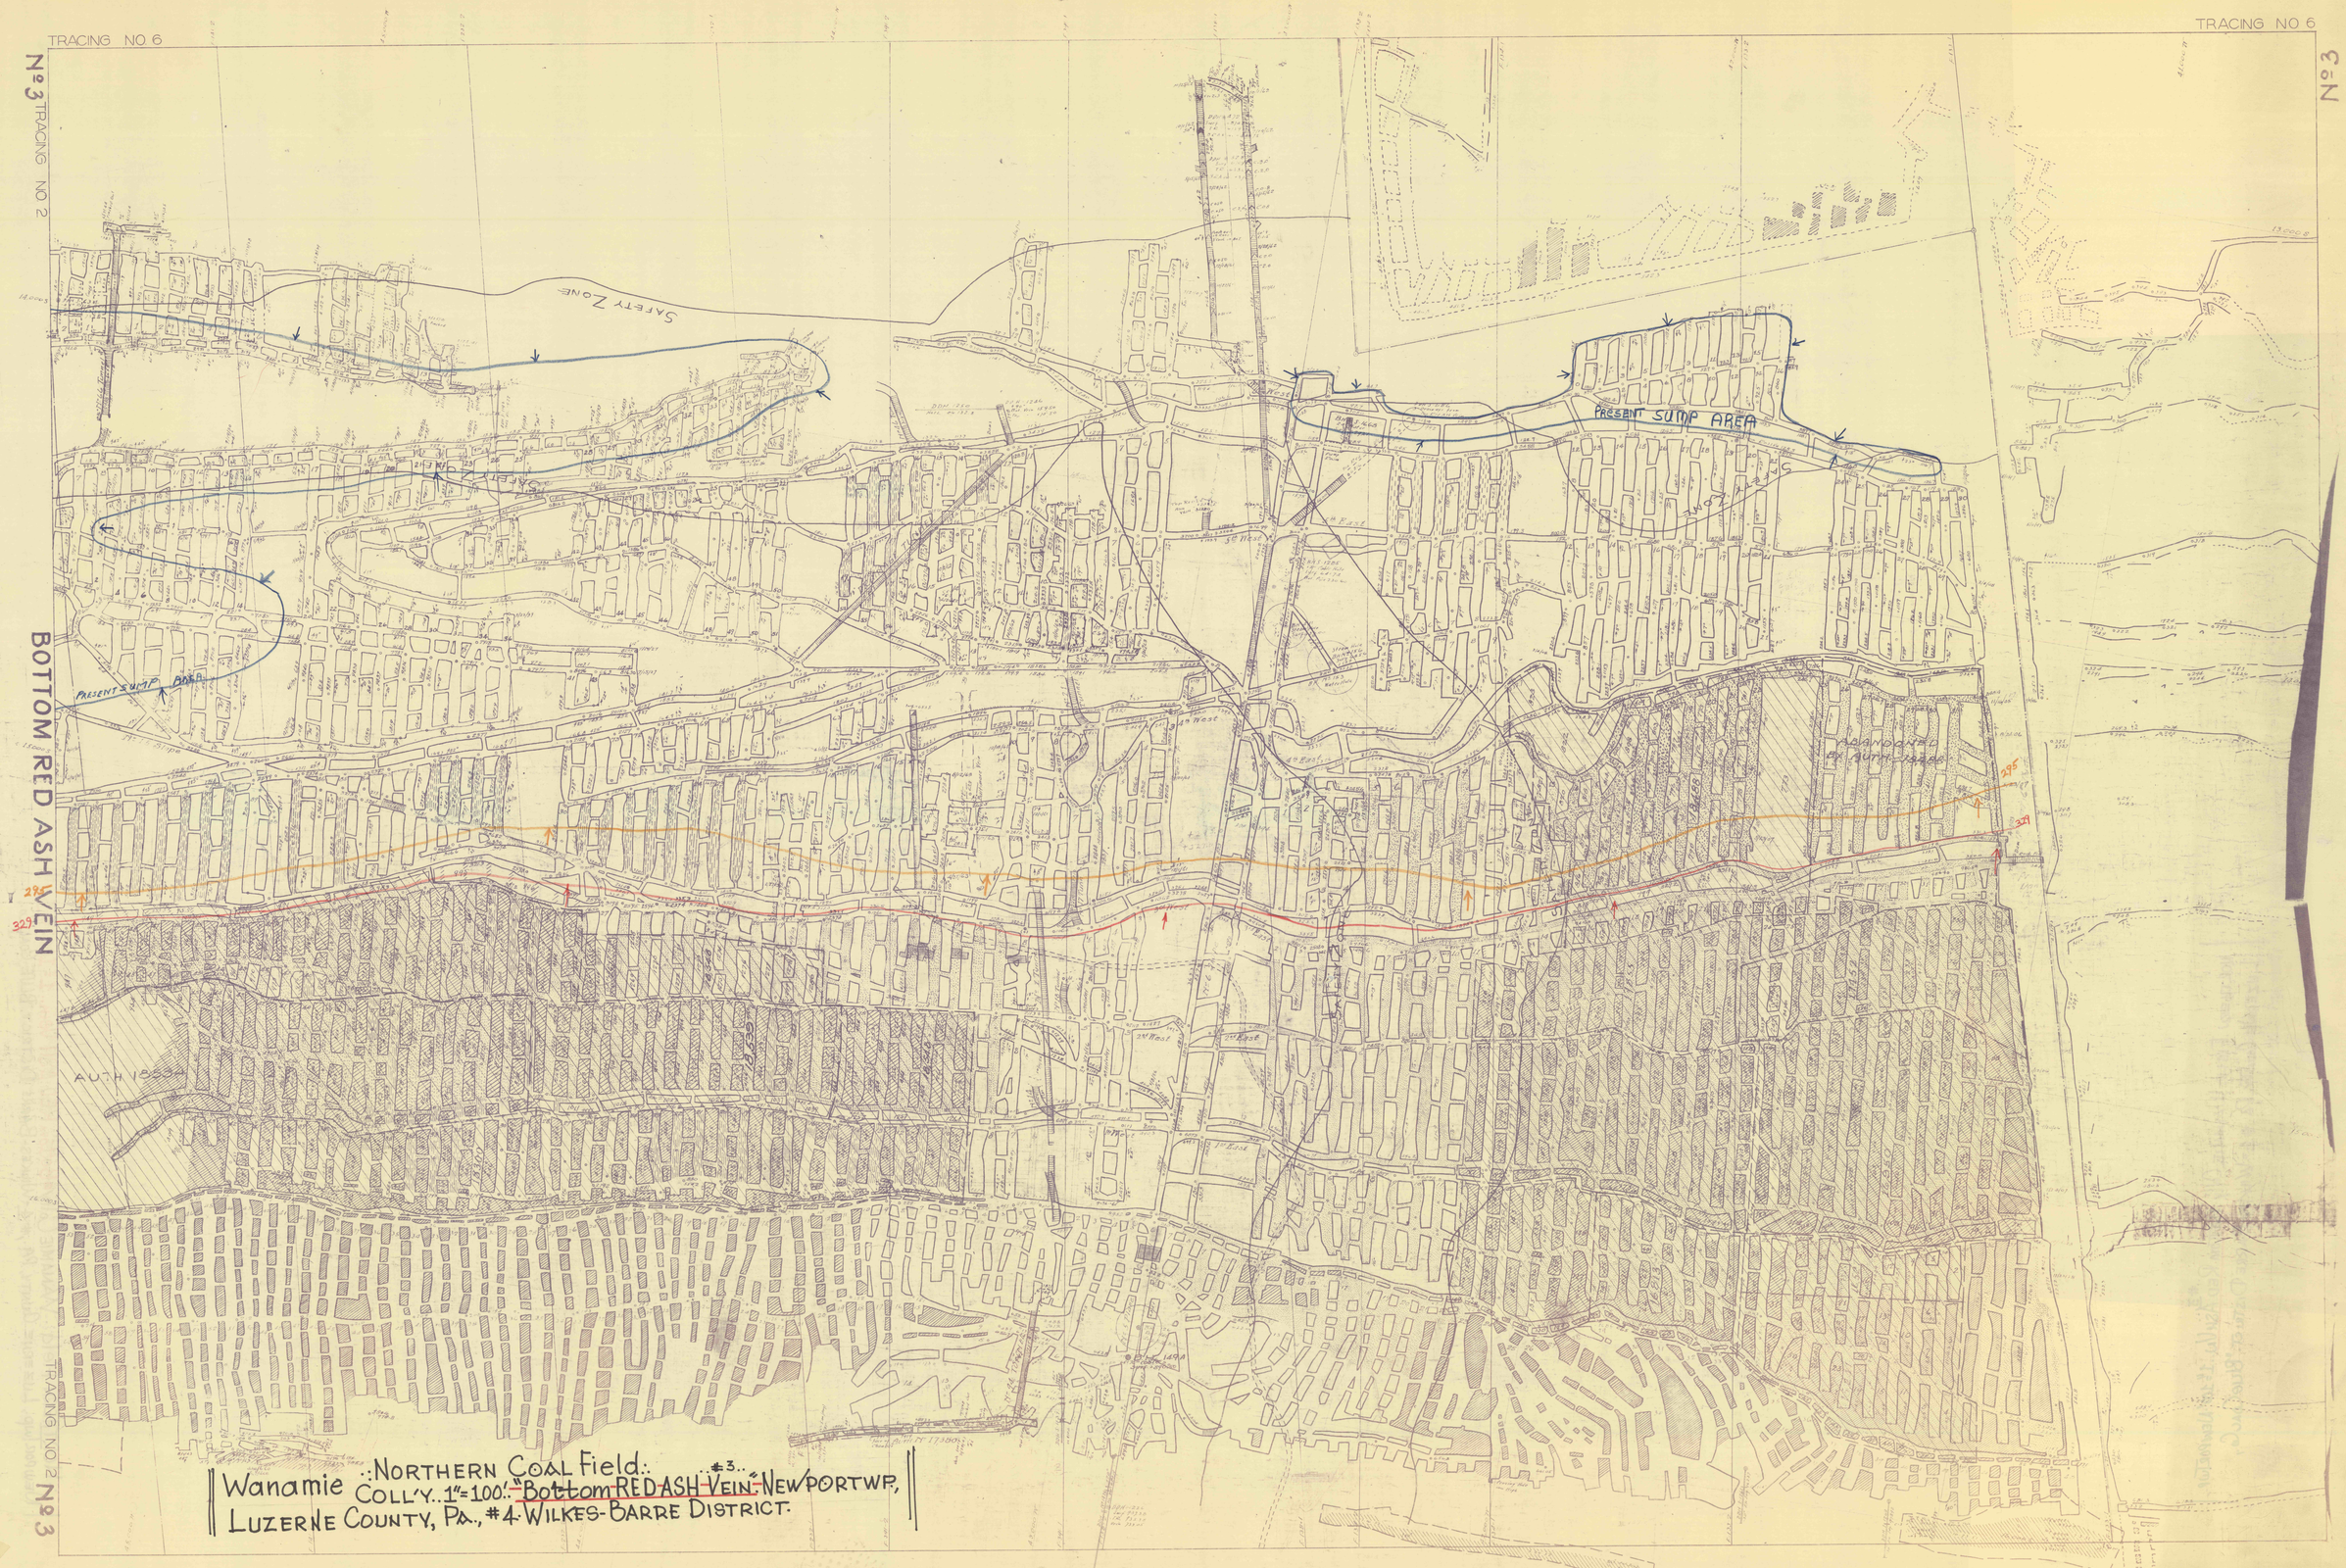
TRACING NO. 6
Nº 3 TRACING NO. 2
BOTTOM RED ASH VEIN
TRACING NO. 2 Nº 3
TRACING NO. 6
Nº 3
SAFETY ZONE
PRESENT SUMP AREA
PRESENT SUMP AREA
ABANDONED BY AUTH. 1888
AUTH 1888
Wanamie :: NORTHERN COAL Field :: ..#3.. COLL'Y.. 1"=100'.. "Bottom RED ASH VEIN" NEWPORT WP.,
LUZERNE COUNTY, PA., #4 WILKES-BARRE DISTRICT.