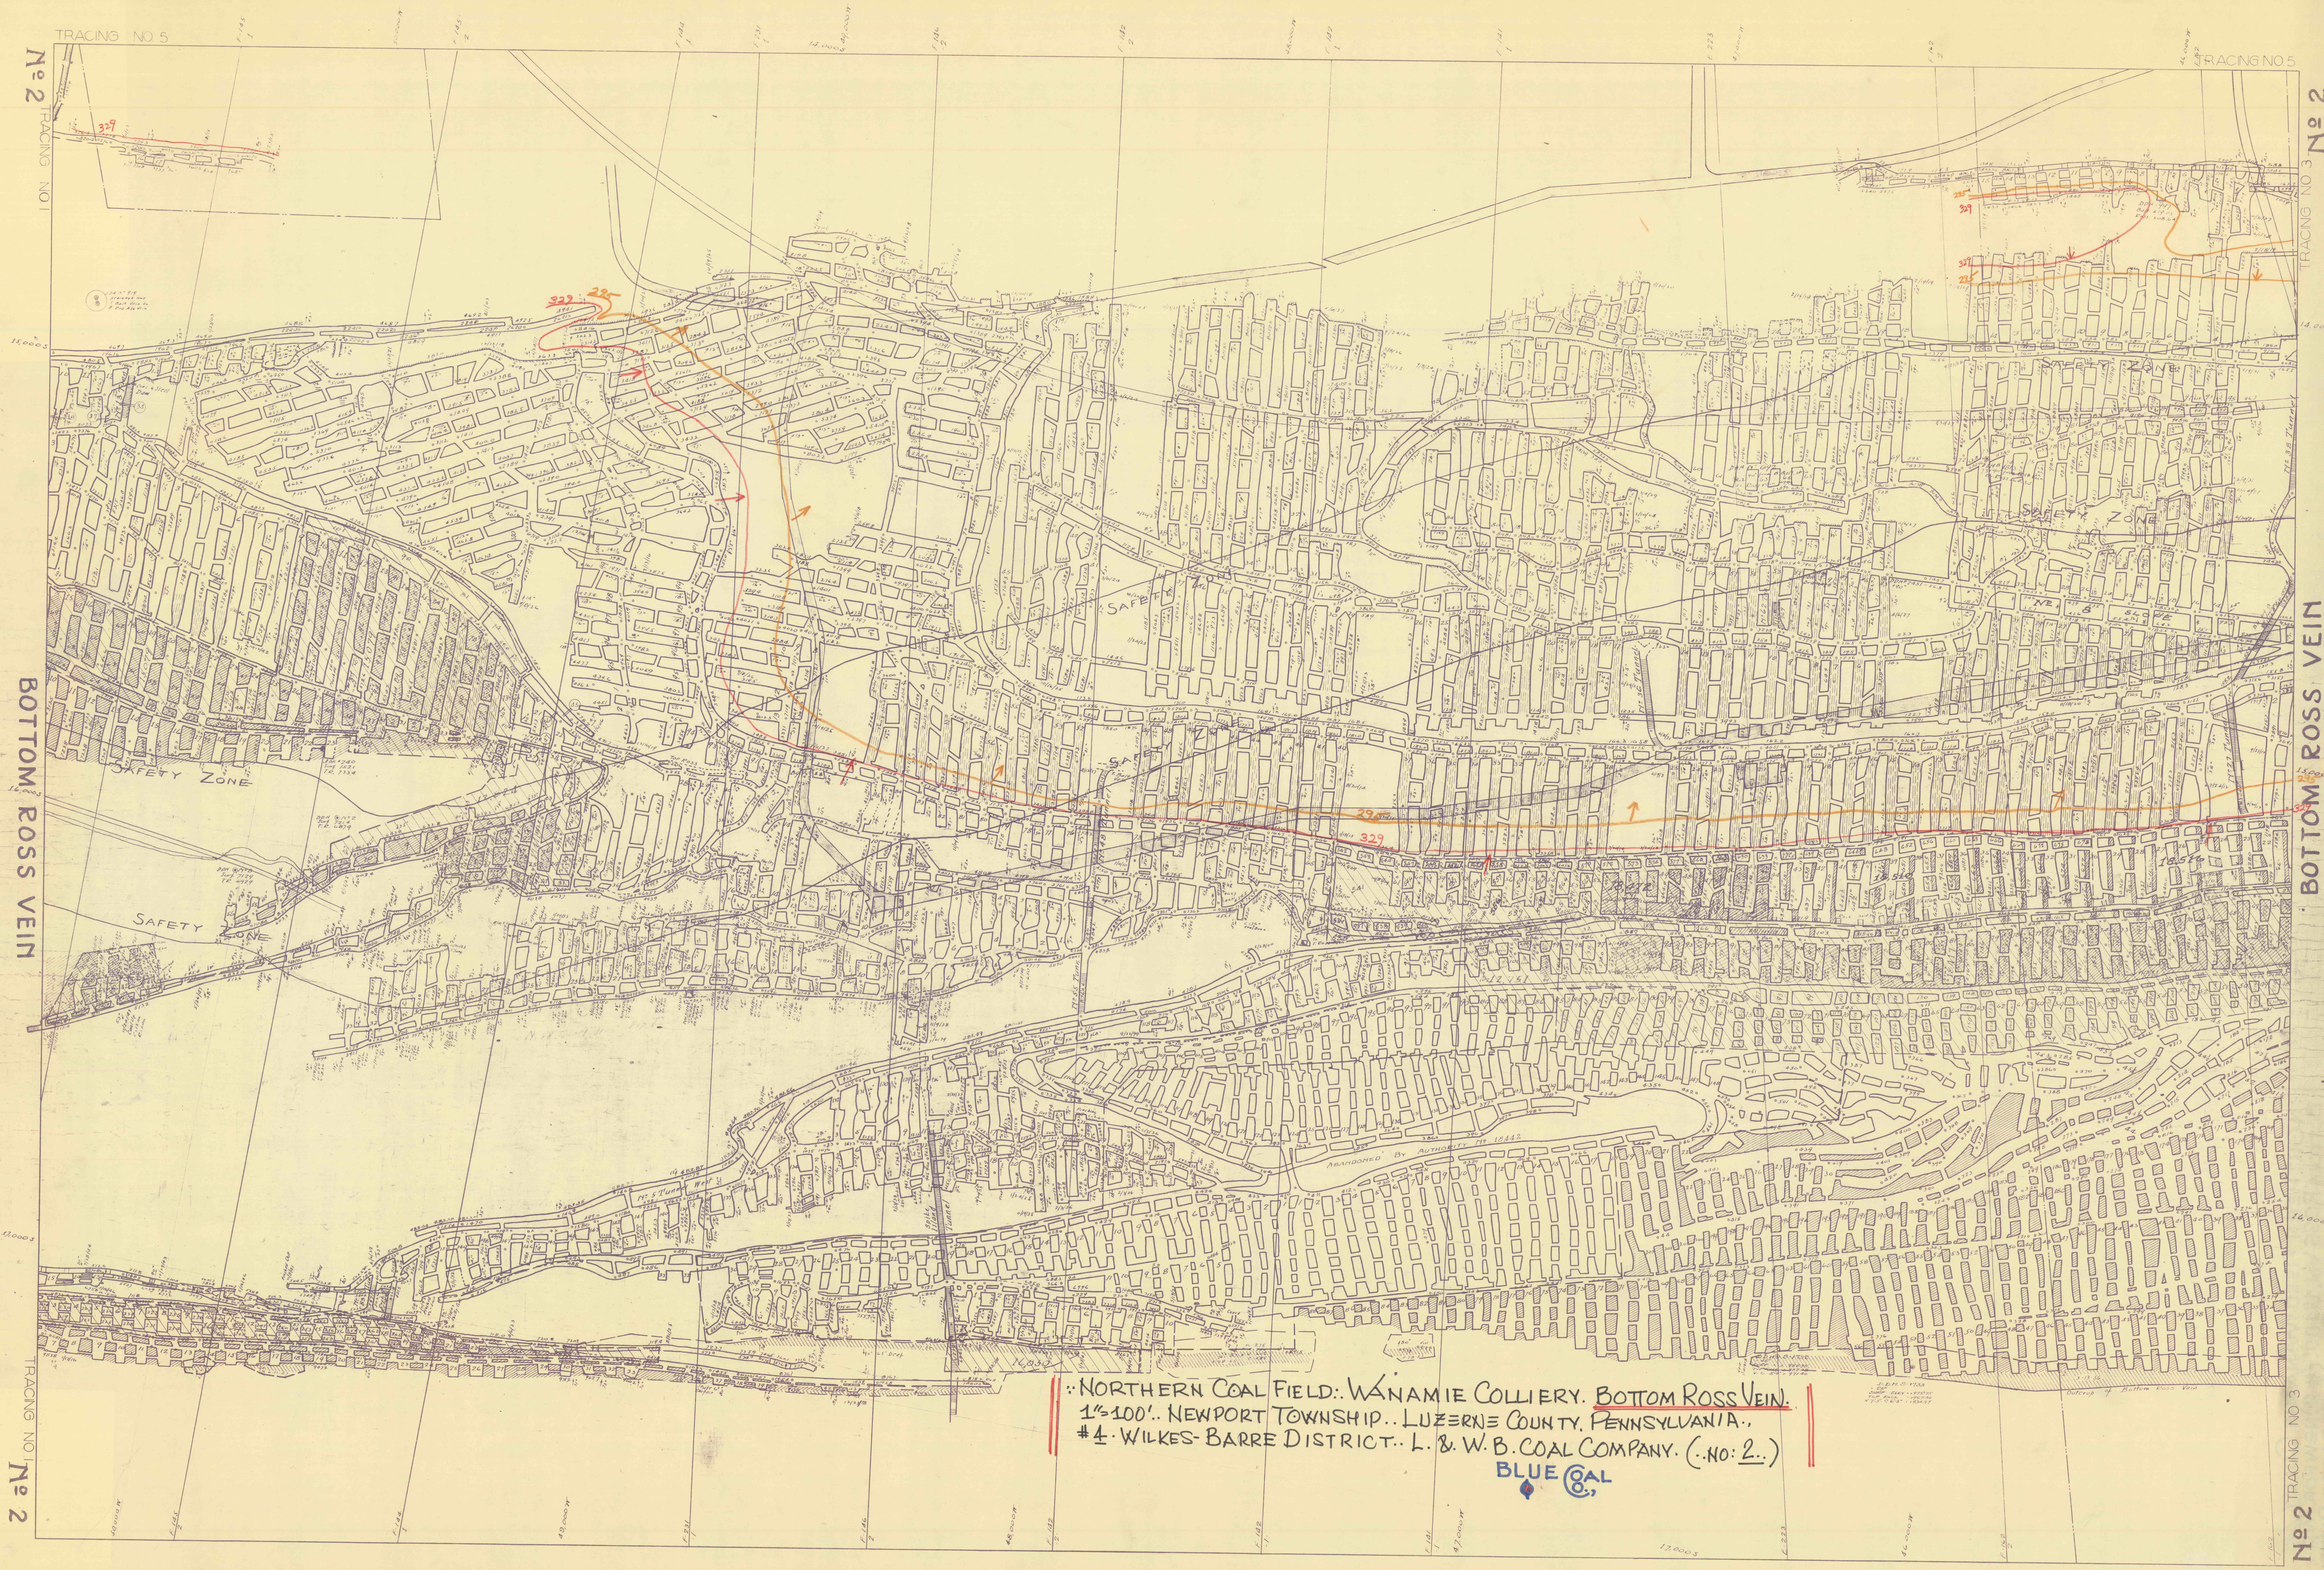

:: NORTHERN COAL FIELD :. WANAMIE COLLIERY. BOTTOM ROSS VEIN.
1" = 100' .. NEWPORT TOWNSHIP .. LUZERNE COUNTY. PENNSYLVANIA .,
#4 . WILKES-BARRE DISTRICT .. L. & W. B. COAL COMPANY. (.. NO: 2 ..)

BLUE COAL CO.,

WANAMIE COLLIERY

No 2