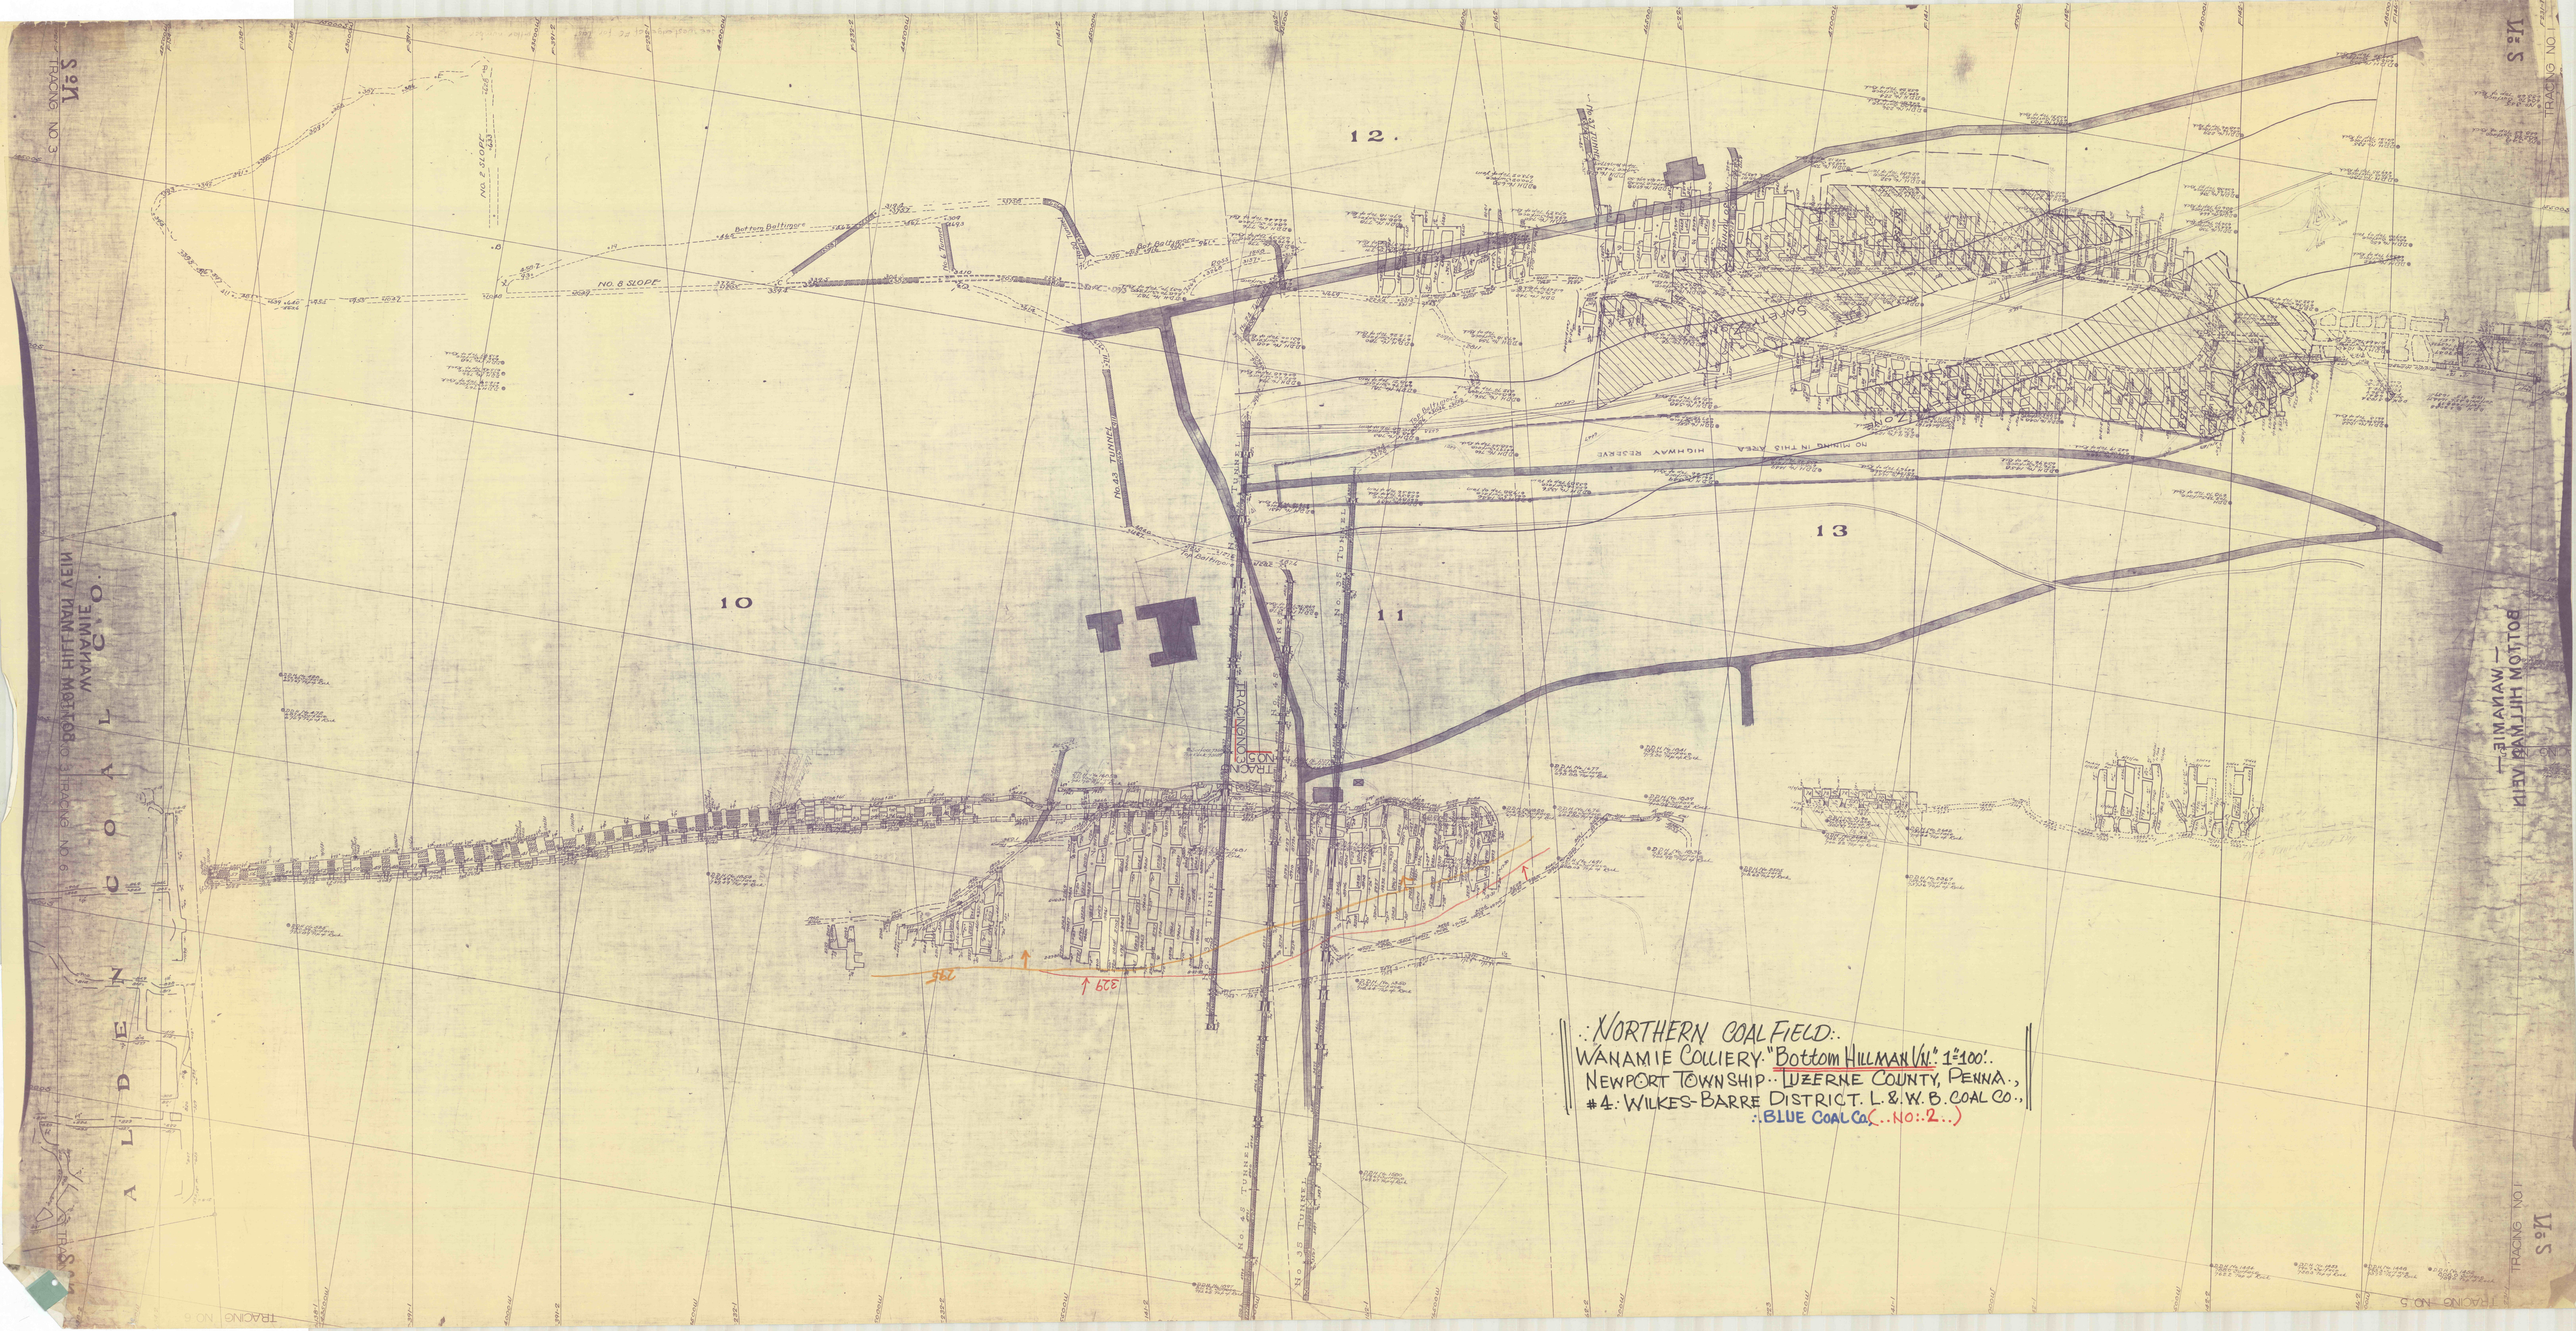

No. 2
TRACING NO 3
TRACING NO 1
TRACING NO 5
TRACING NO 6
TRACING NO 3
NO 5
ALDEN COAL CO.
12.
13
10
11
NO. 2 SLOPE
NO. 8 SLOPE
Bottom Baltimore
Bot Baltimore
Top Baltimore
Ross
No. 6 Tunnel
No. 20 Tunnel
No. 24 Tunnel
No. 43 TUNNEL
No. 38 TUNNEL
No. 45 TUNNEL
No. 35 TUNNEL
No. 37 TUNNEL
No. 30 TUNNEL
SAFETY ZONE
HIGHWAY RESERVE
NO MINING IN THIS AREA
No. 8 Tunnel East Dip
see west edge of #2 for last pillar number
295
329
42500W
43000W
43500W
44000W
44500W
45000W
45500W
46000W
46500W
47000W
47500W
48000W
48500W
15000S
14500S
15500S

.: NORTHERN COAL FIELD :.

WANAMIE COLLIERY "Bottom HILLMAN Vn." 1"=100'.

NEWPORT TOWNSHIP .. LUZERNE COUNTY, PENNA.,

#4: WILKES-BARRE DISTRICT. L. & W. B. COAL CO.,

.: BLUE COAL Co. (.. NO: 2 ..)