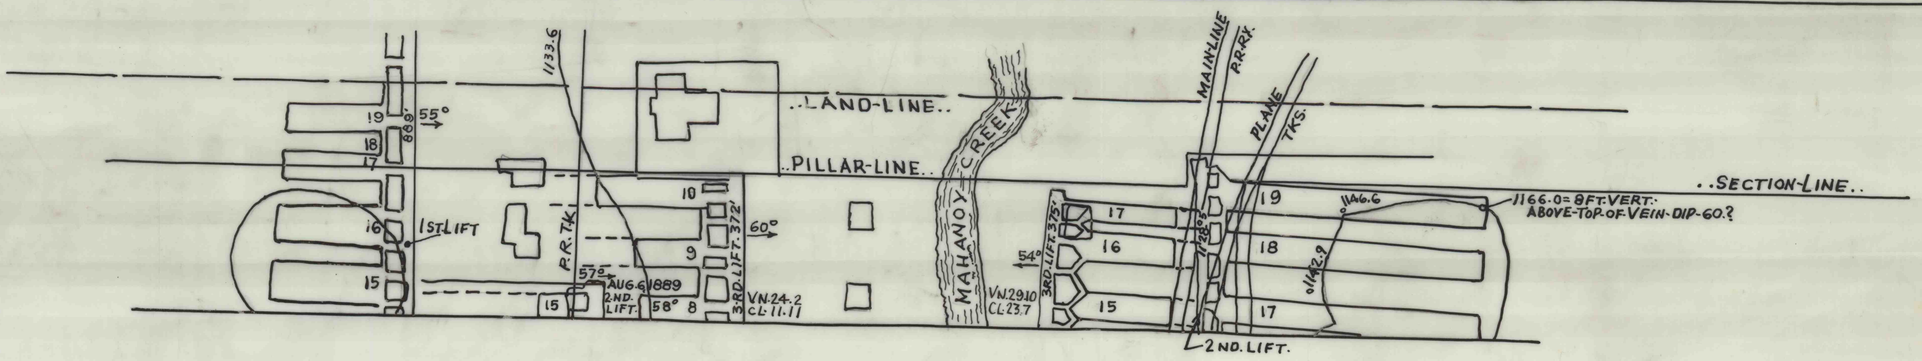

...WESTERN MIDDLE FIELD...

West BEAR RIDGE Colliery..Section-Across Basin-line-of-W. B. Ridge-East Pillar-line. 1"=100'. W. Mahanoy Twp., Schuylkill County, Pa. 11-W. Mahanoy District. Phila., Reading Coal & Iron Co., F. P. Weiser, Div., Eng'r. 24 Dec. 1909. Ashland.
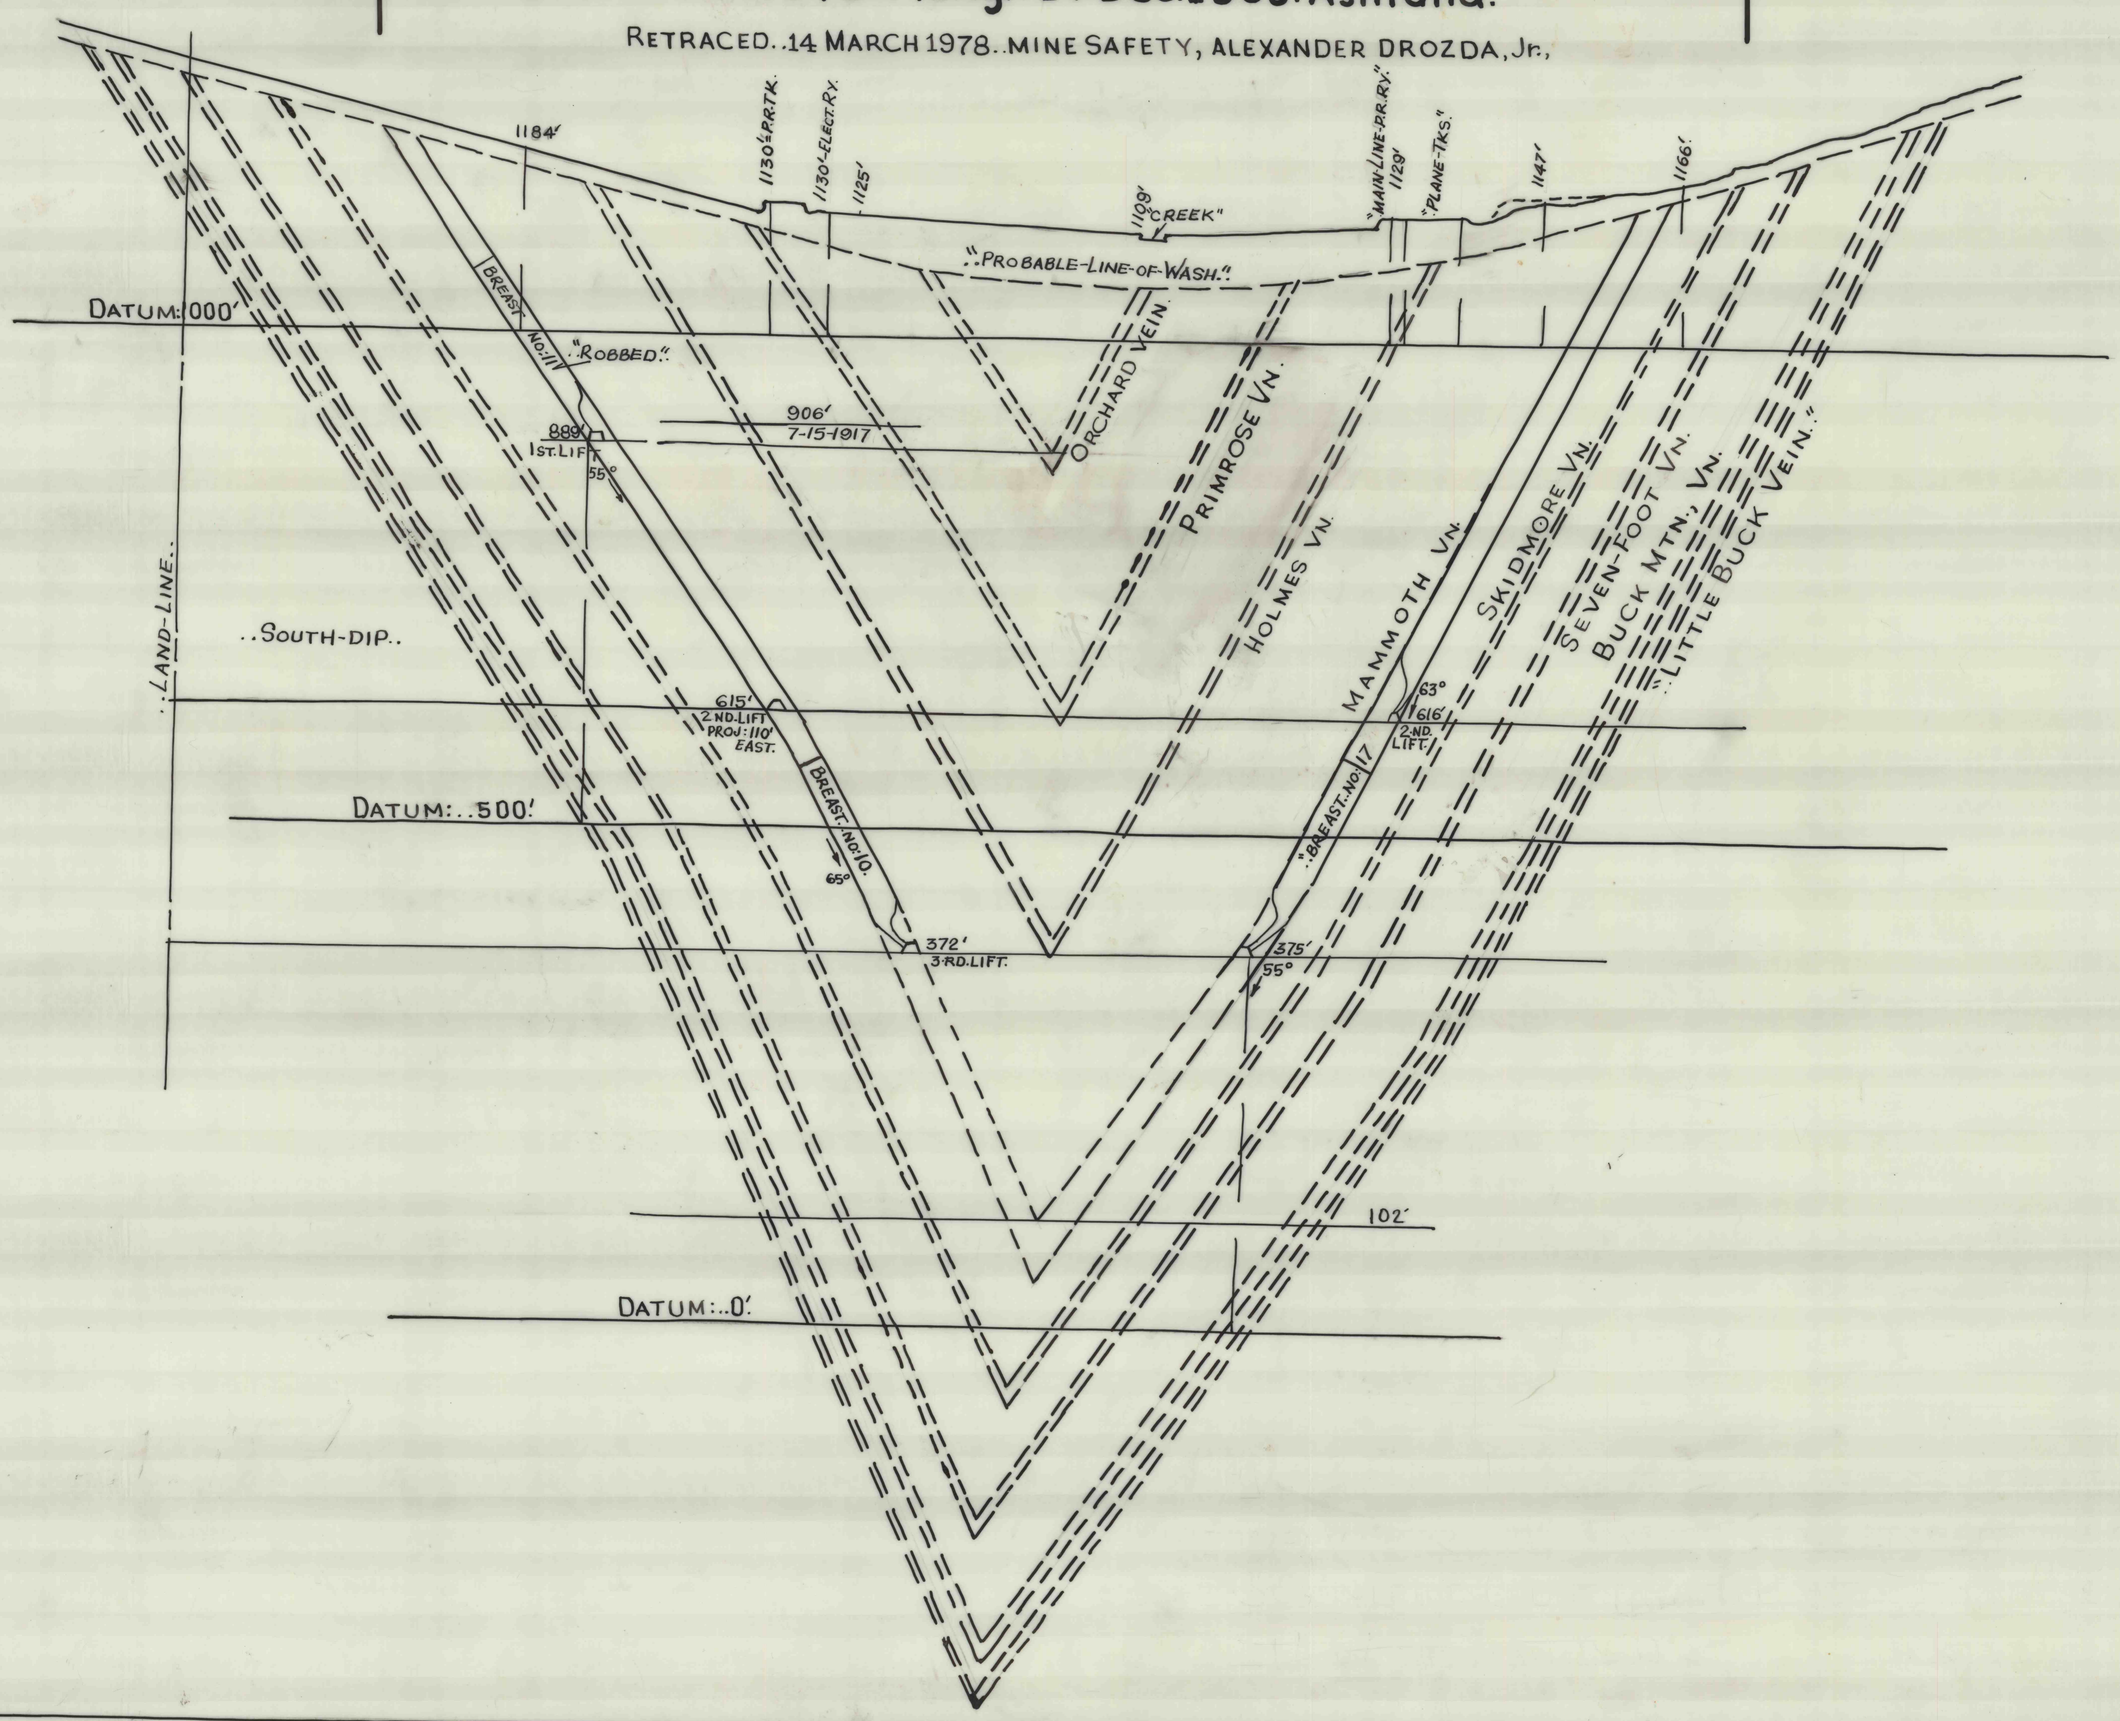
RETRACED..14 MARCH 1978..MINE SAFETY, ALEXANDER DROZDA, Jr.,