

.. Western Middle Coal Field..

CROSS SECTION: "I"
ON COORDINATE LINE EAST 1000


GIRARD COLLIERY
HAZLE BROOK COAL CO.

Scale 1"=100

Eng. Department
Hazleton, Pa.

Oct. 21, 1926

WEST MAHANOTY TOWNSHIP.
SCHUYLKILL COUNTY, 11. W. MAHANOTY DISTRICT.

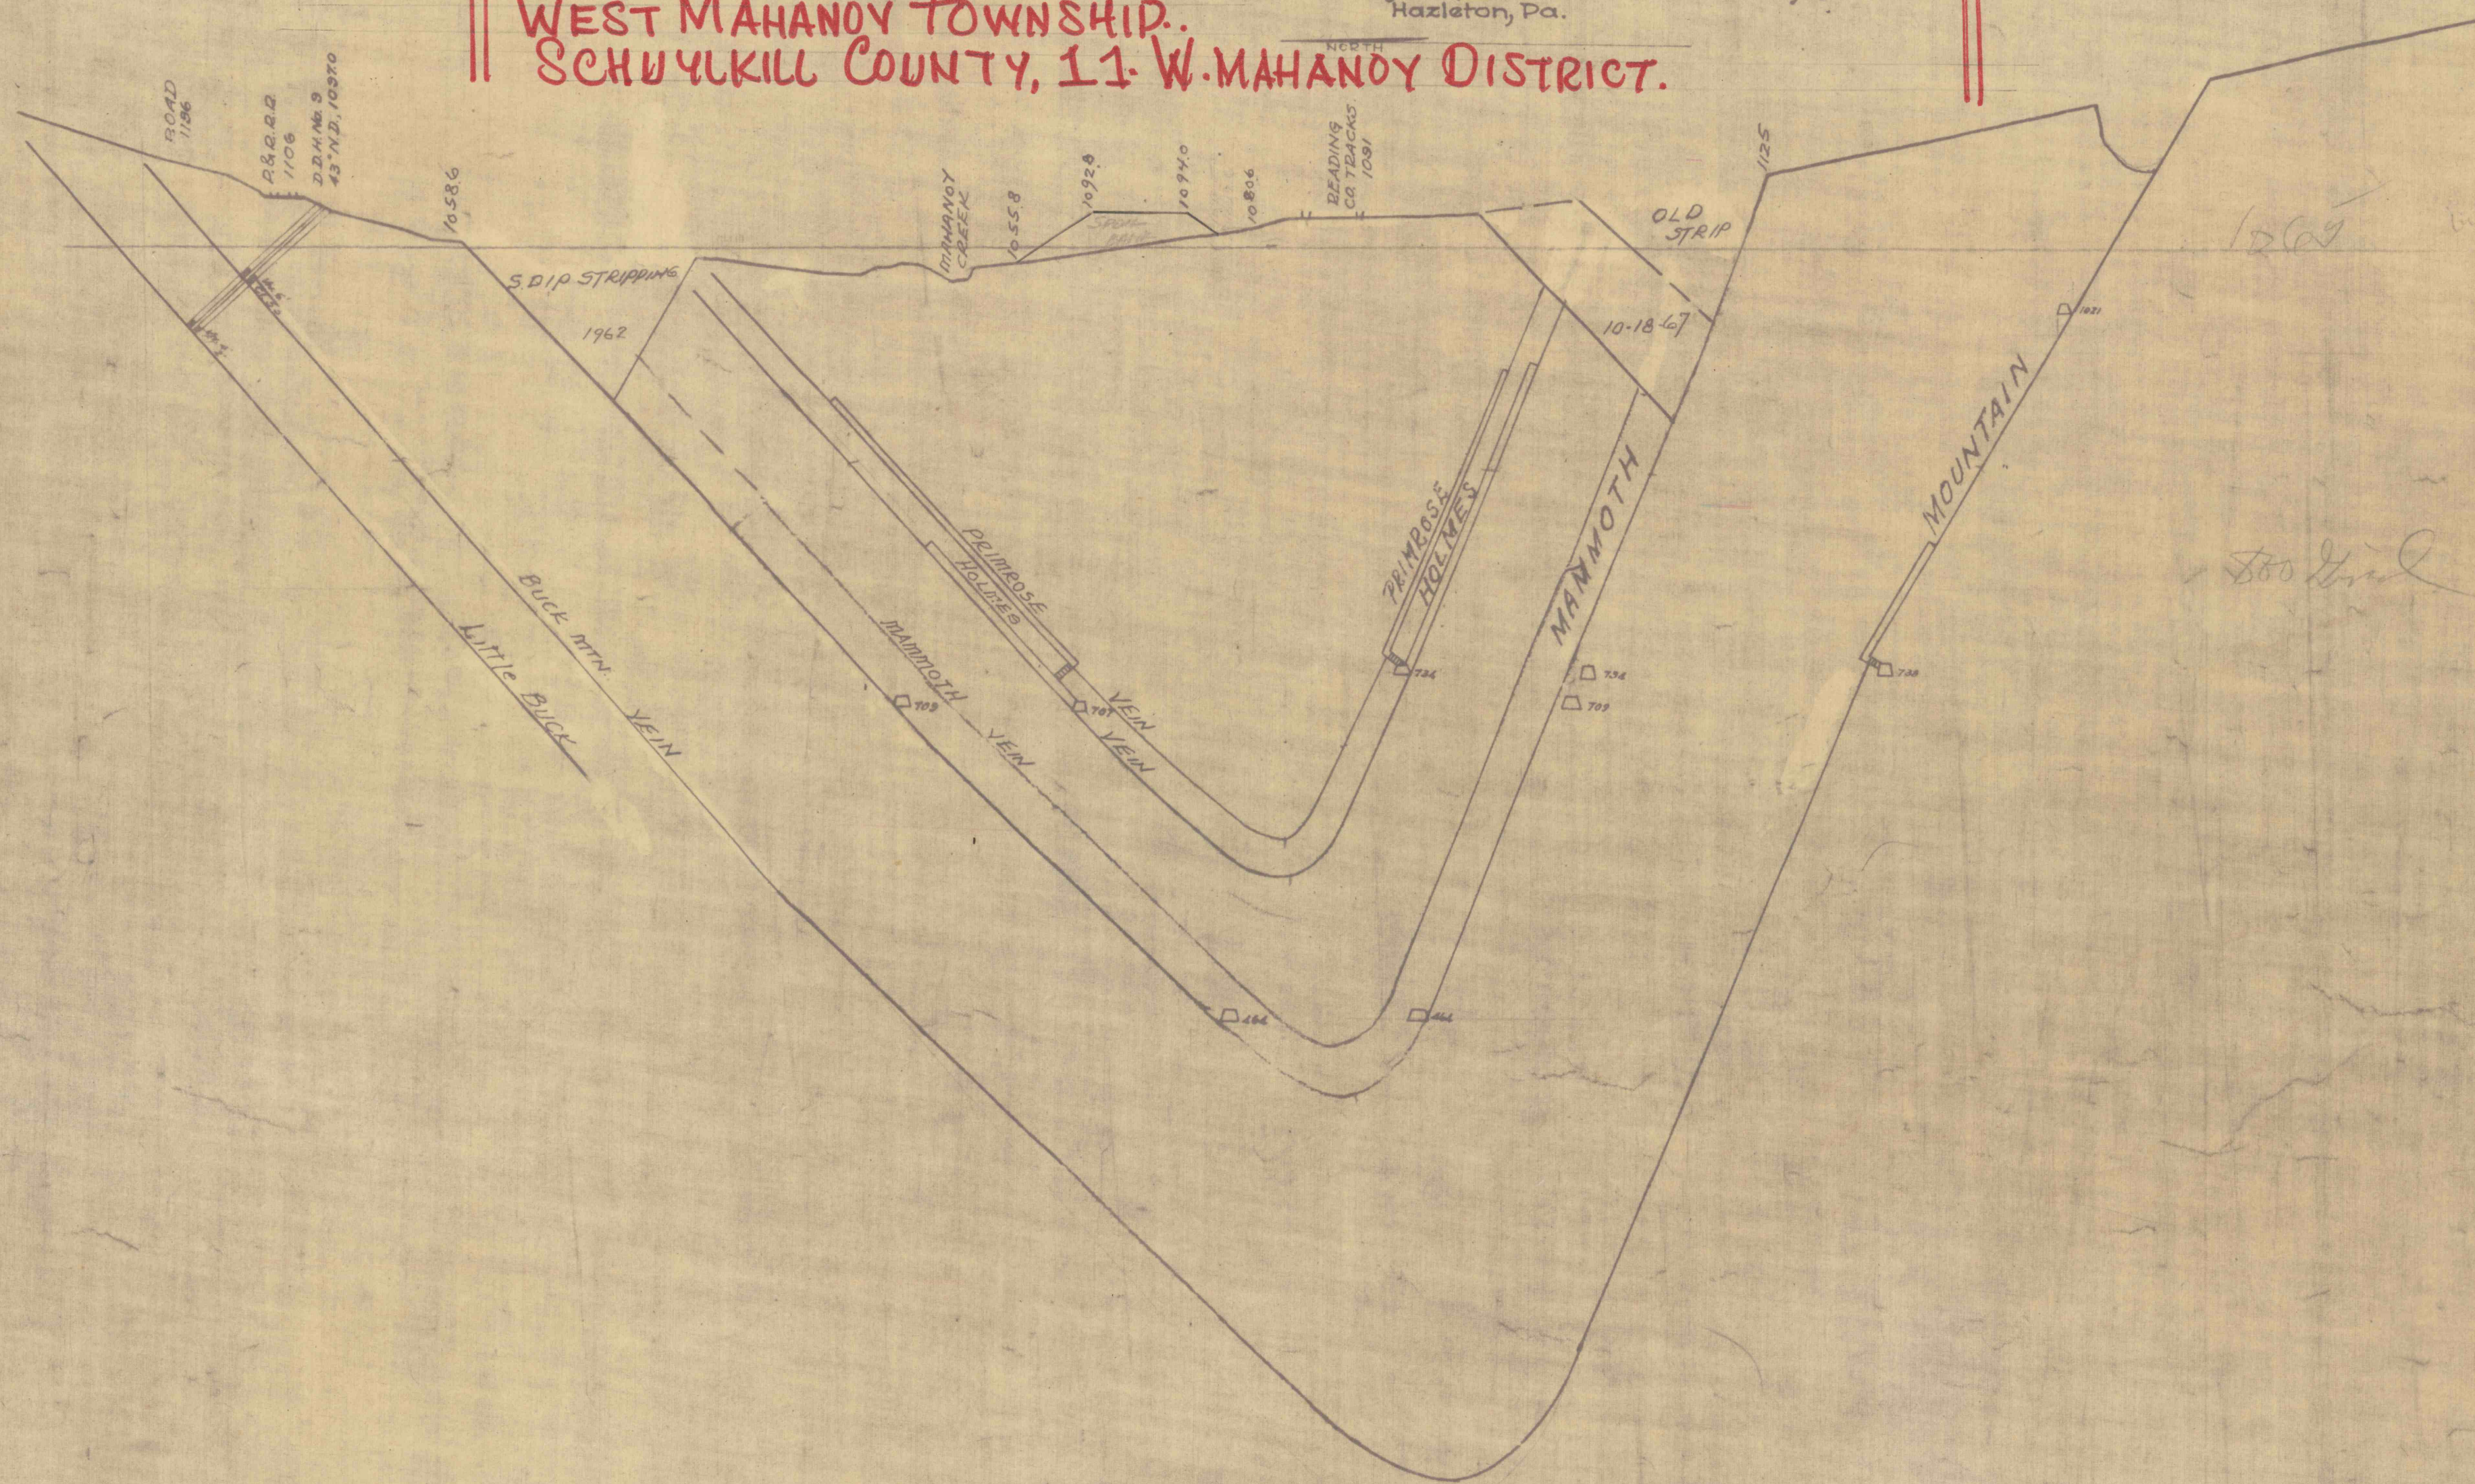

Section 300' WEST OF WEST LINE OF
W. B. RIDGE COLLY. 1"=100'

DATUM - MEAN TIDE