


LOOKING WEST

N. 

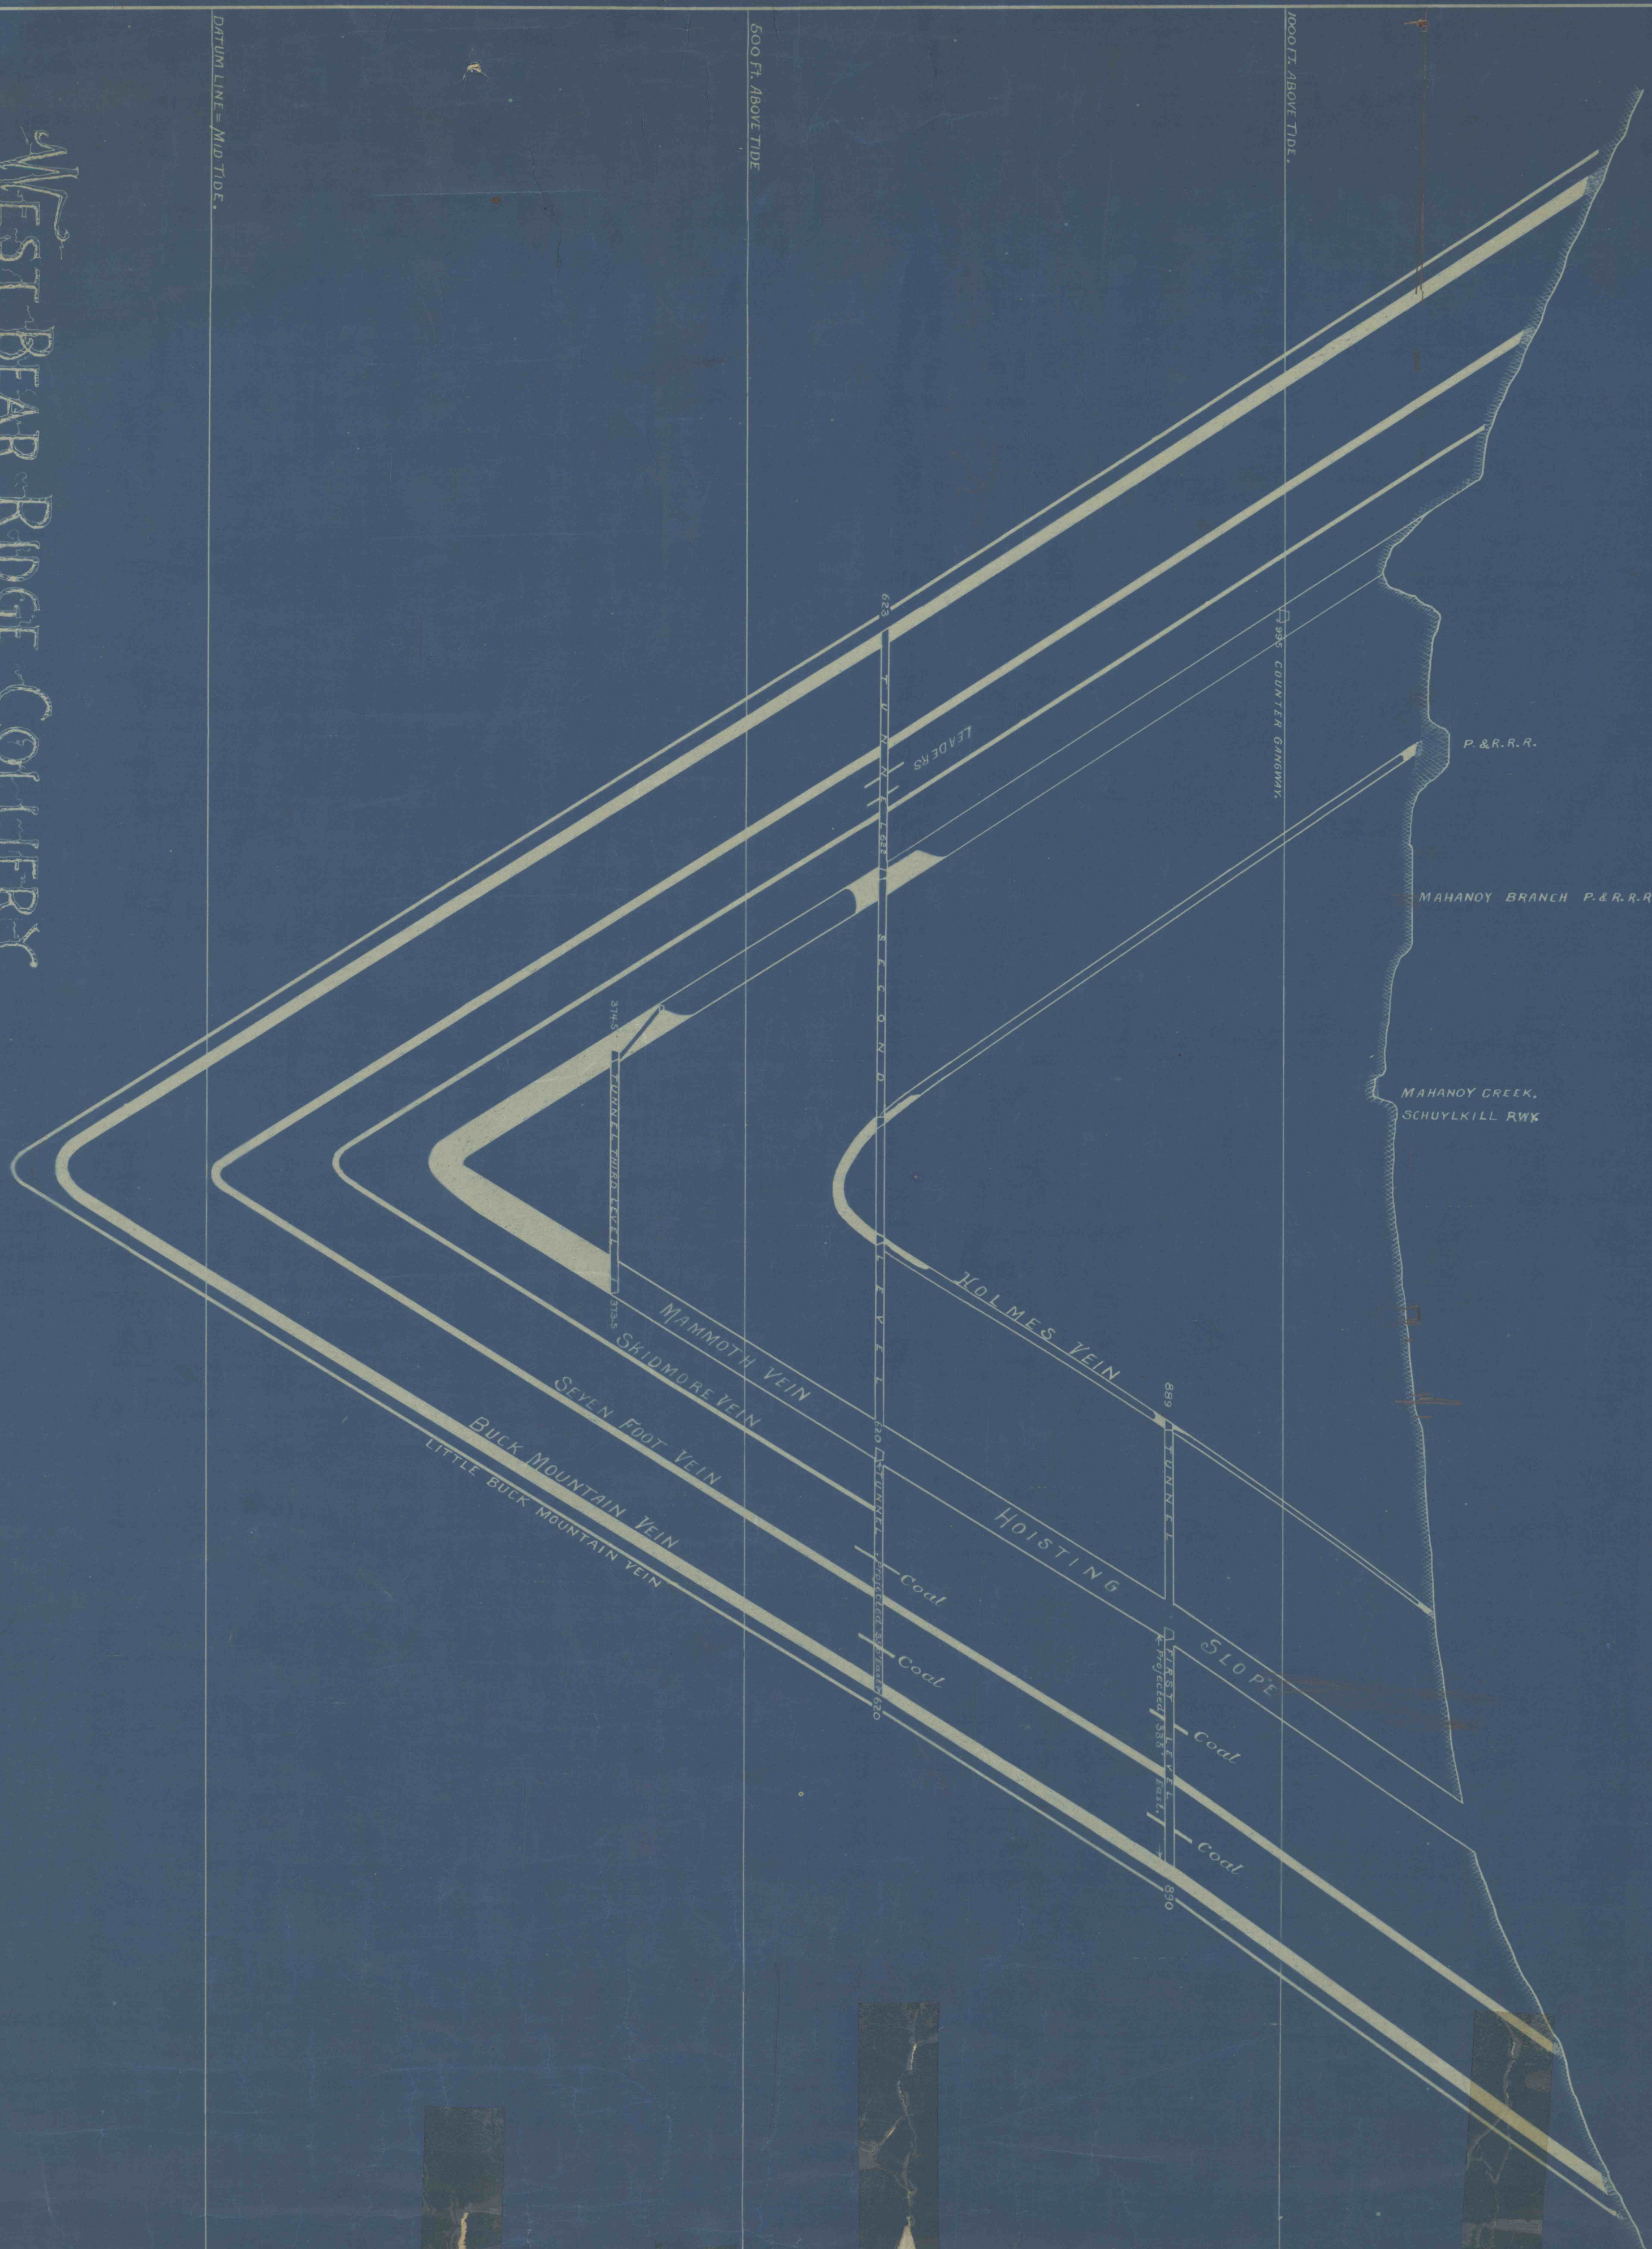

WEST BEAR RIDGE COLLIERY

SECTION ON LINE OF MAMMOTH HOISTING SLOPE.

Scale 100 ft. per inch.

Pottsville, May 15, 1906.

James Streibach Jr. MINING ENGINEER.