


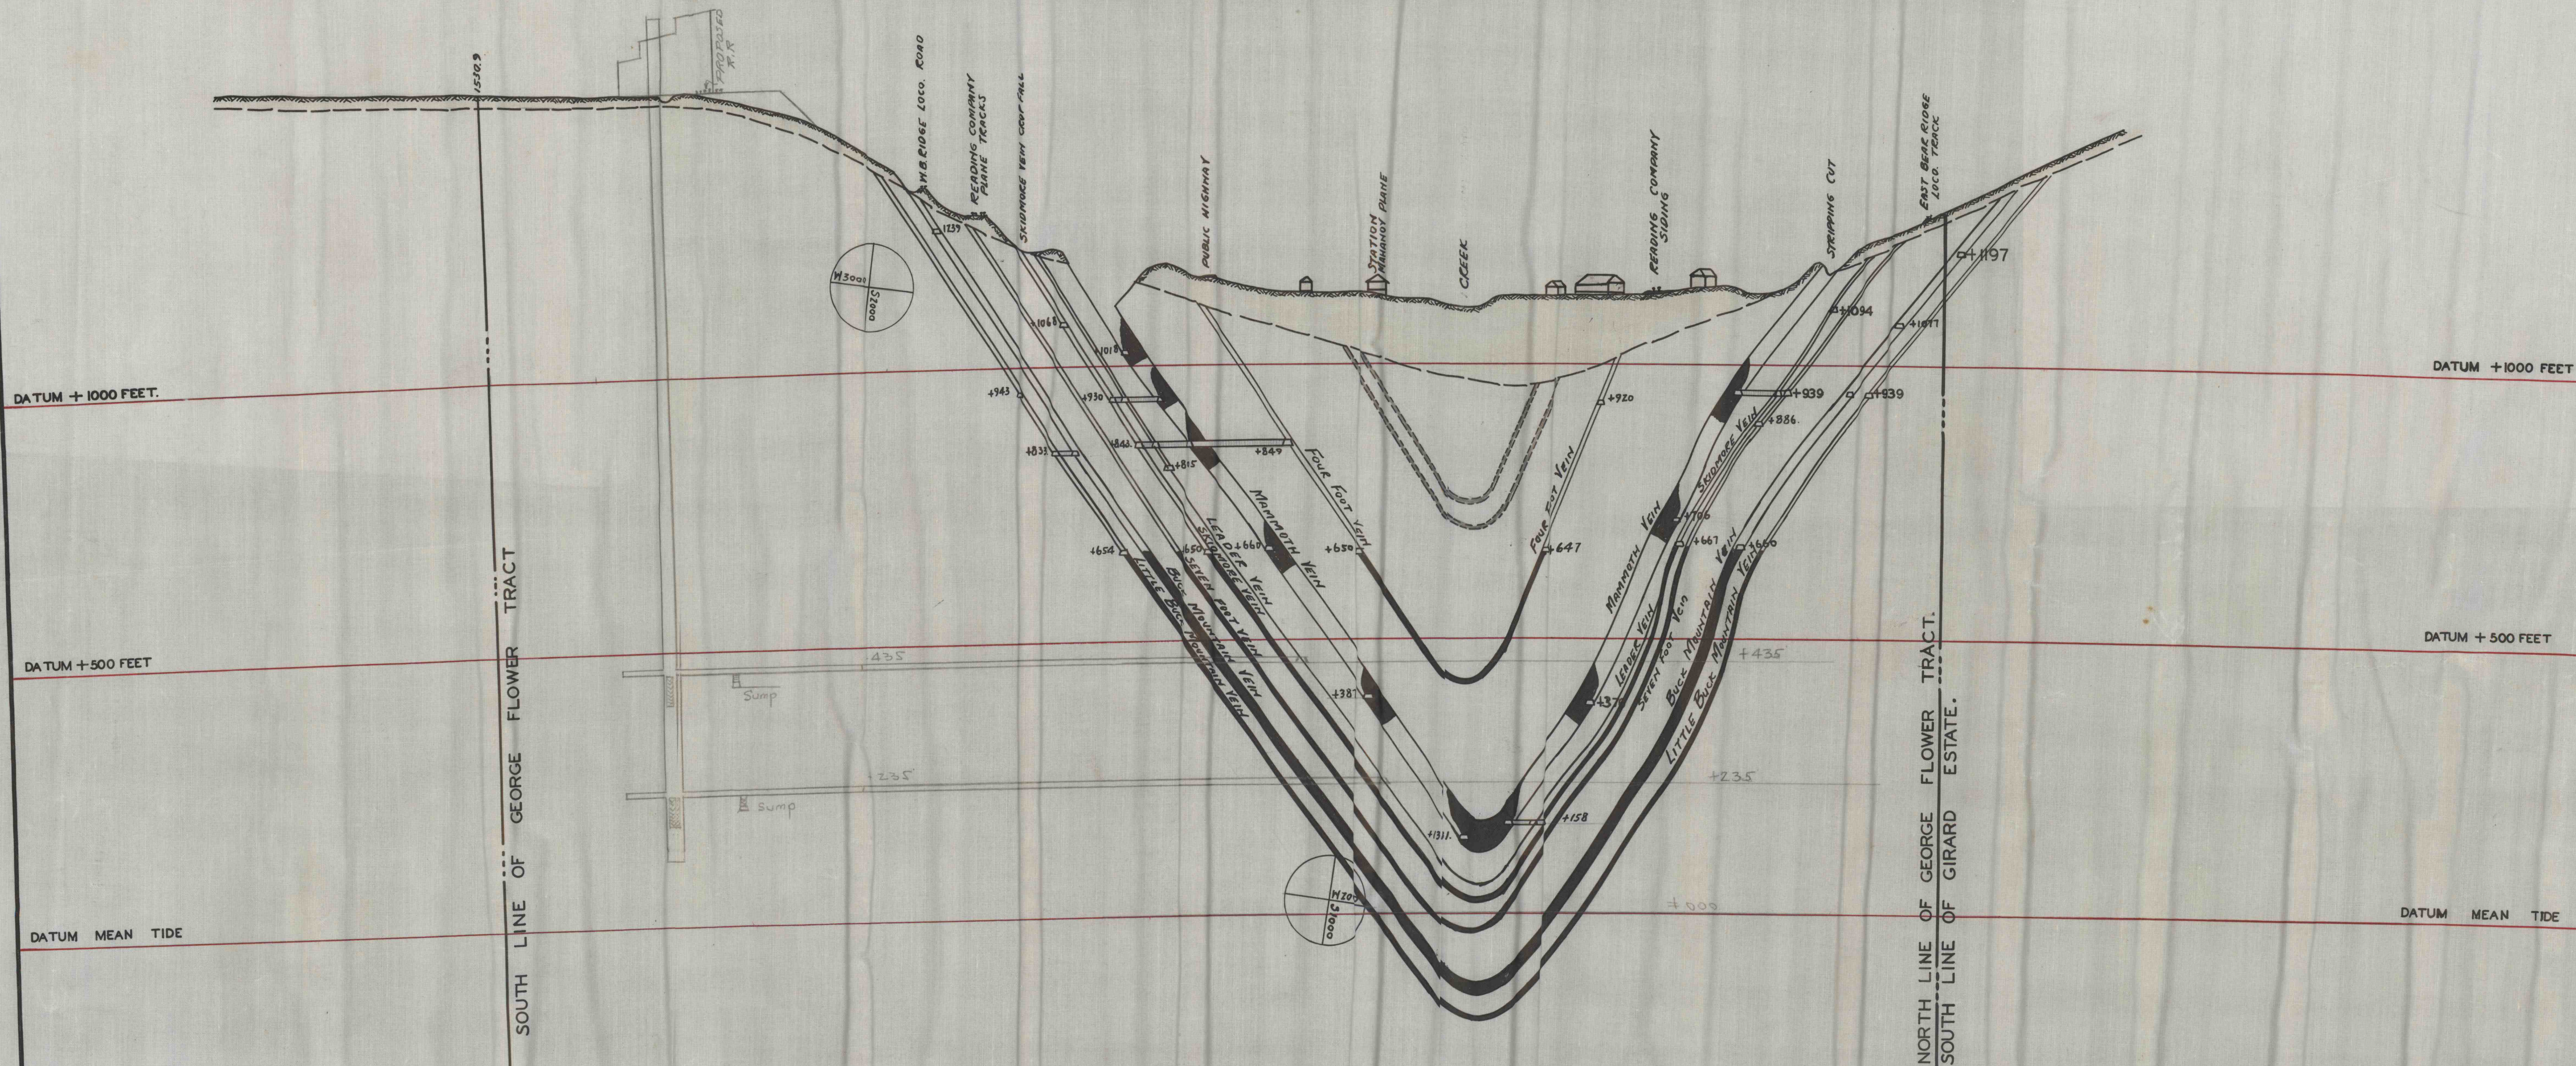

WESTERN Middle Field
 W. MAHANOE TWP., SCHUYLKILL COUNTY PA., II W. MAH., DISTRICT.
 CROSS SECTION NO-2-
 LOCATED 1150 FEET EAST OF LAND LINE
 BETWEEN LAWRENCE AND WEST BEAR RIDGE
 HARLEIGH-BROOKWOOD COAL COMPANY
 MAHANOE PLANE-PENNA.
 SCALE 1-INCH=200 FT. SEPT-21-1936