



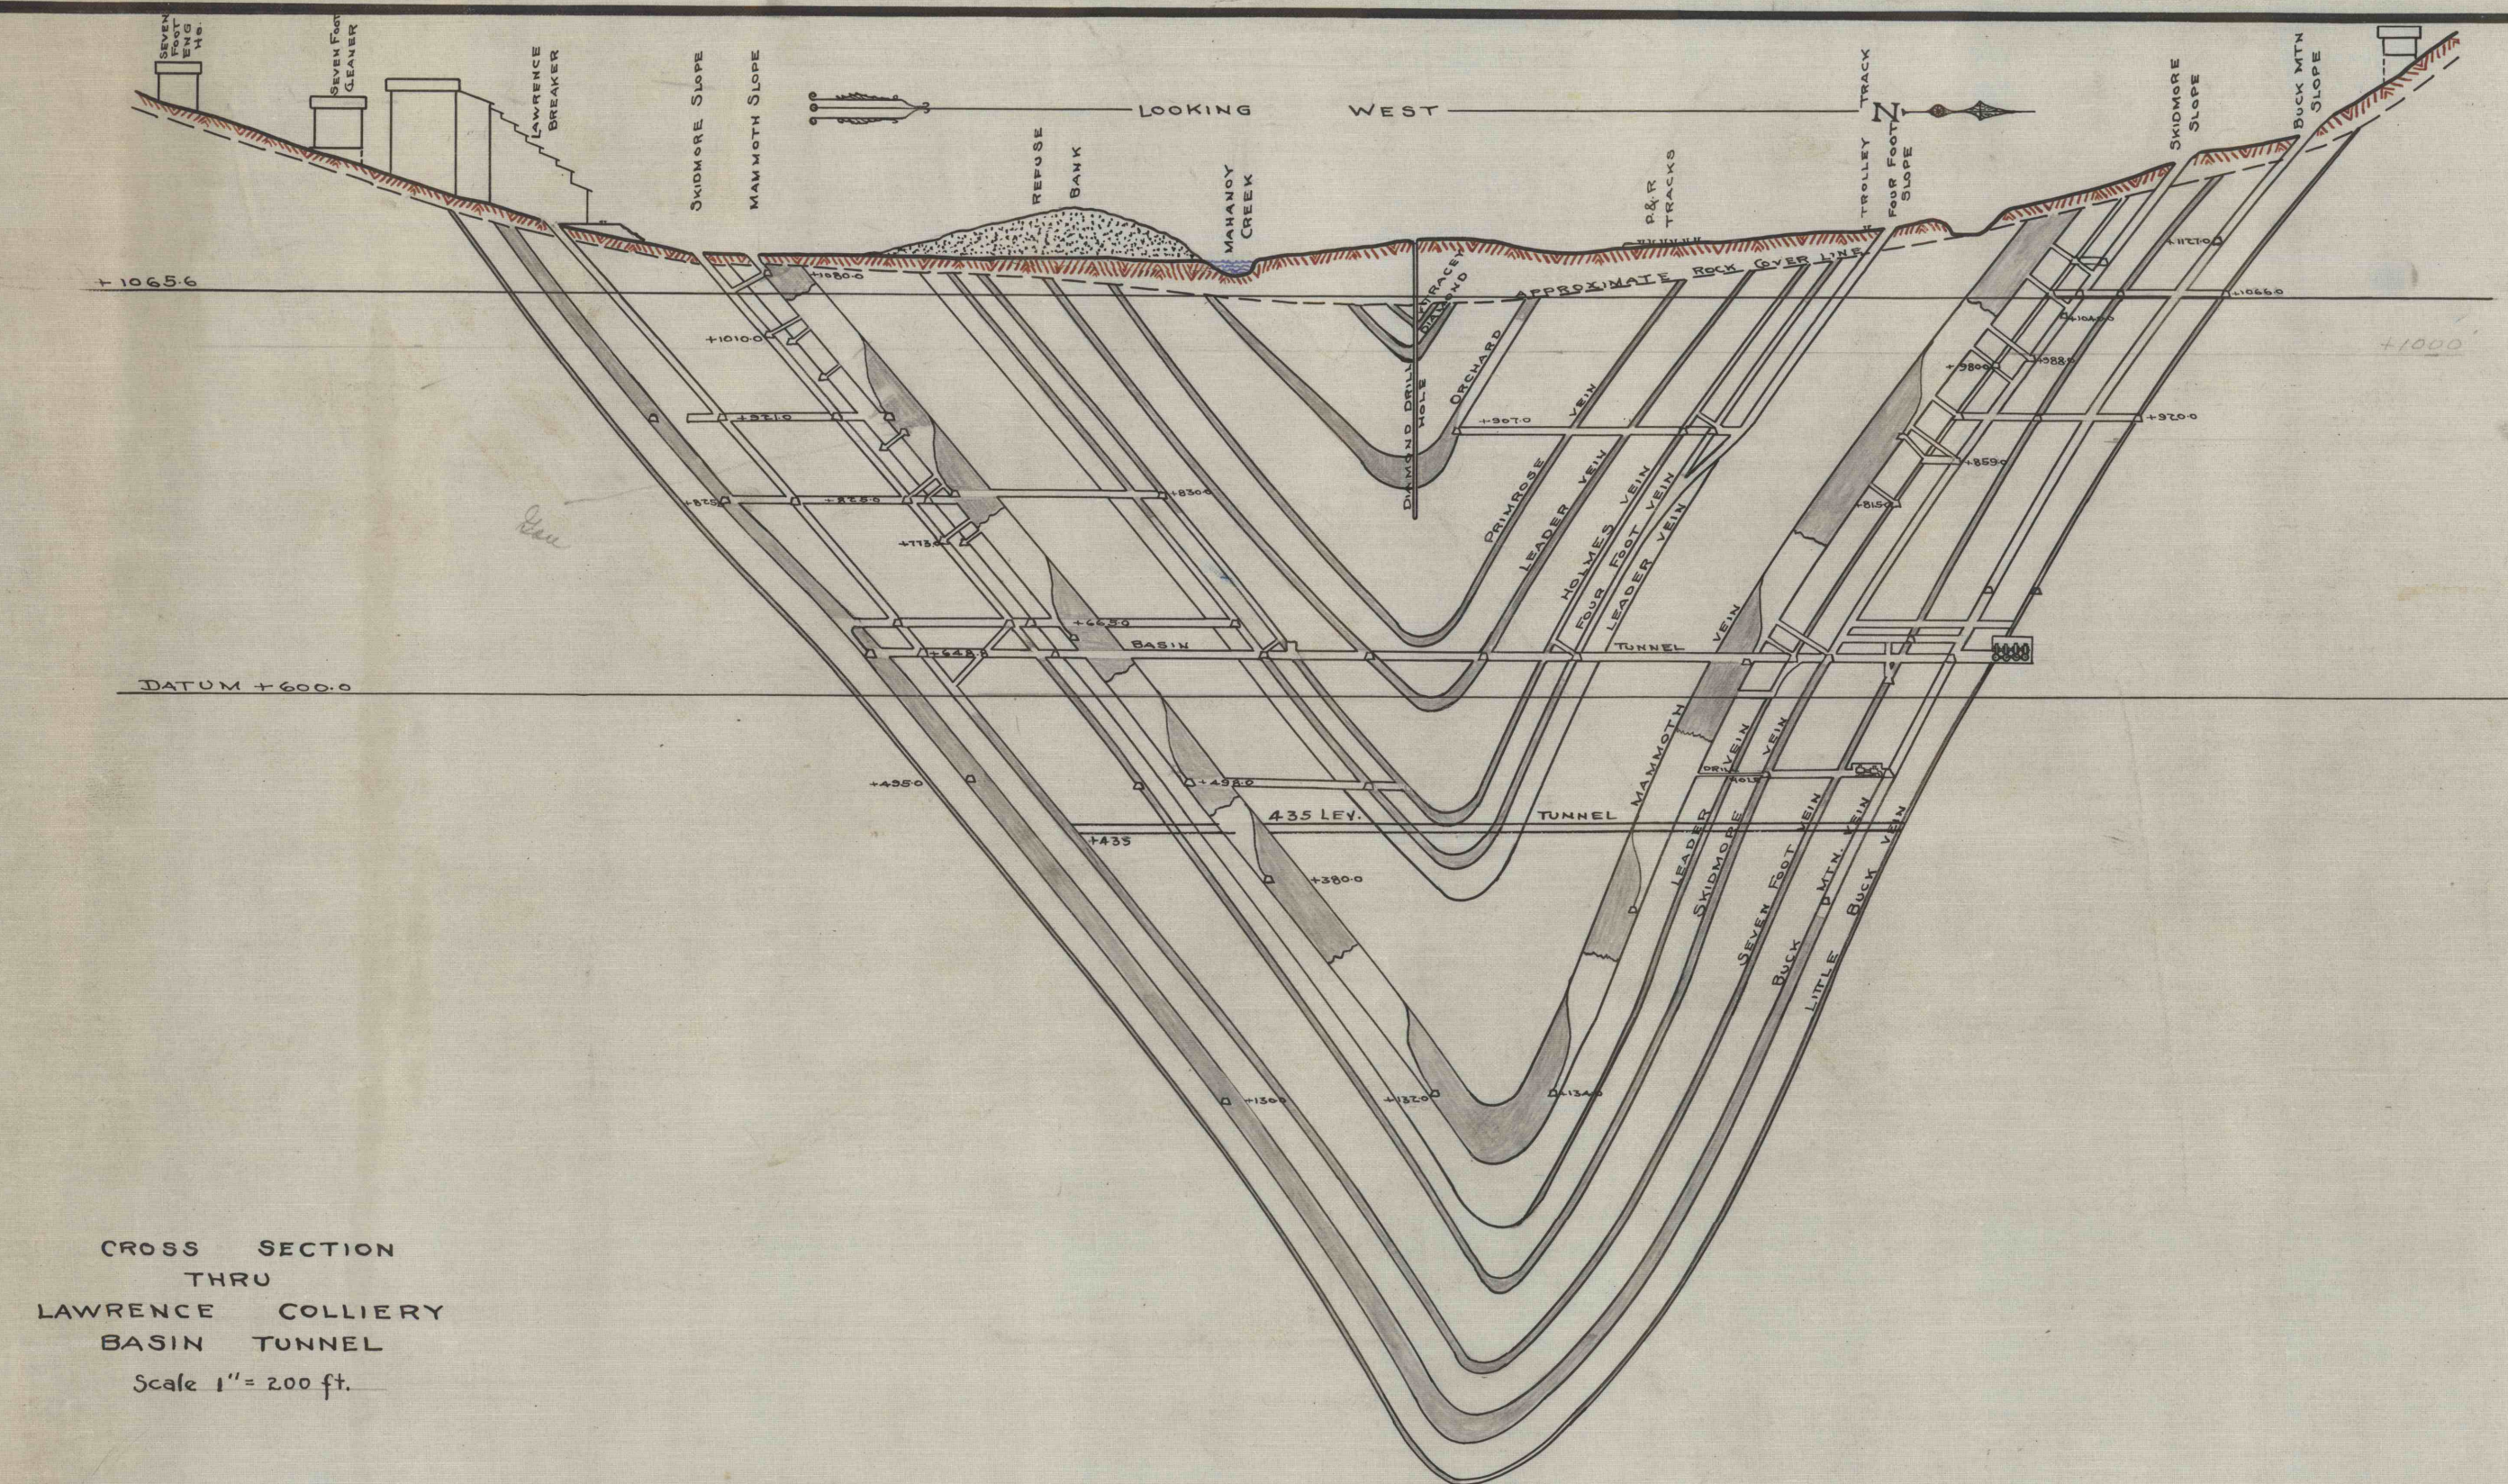

WESTERN MIDDLE Coal Field.
W. MAHANOT TWP, SCHUYLKILL
CROSS SECTION
THRU
COUNTY PA.,
WEST BEAR RIDGE COLLIERY.
BASIN TUNNEL
11. W. MAHANOT DISTRICT

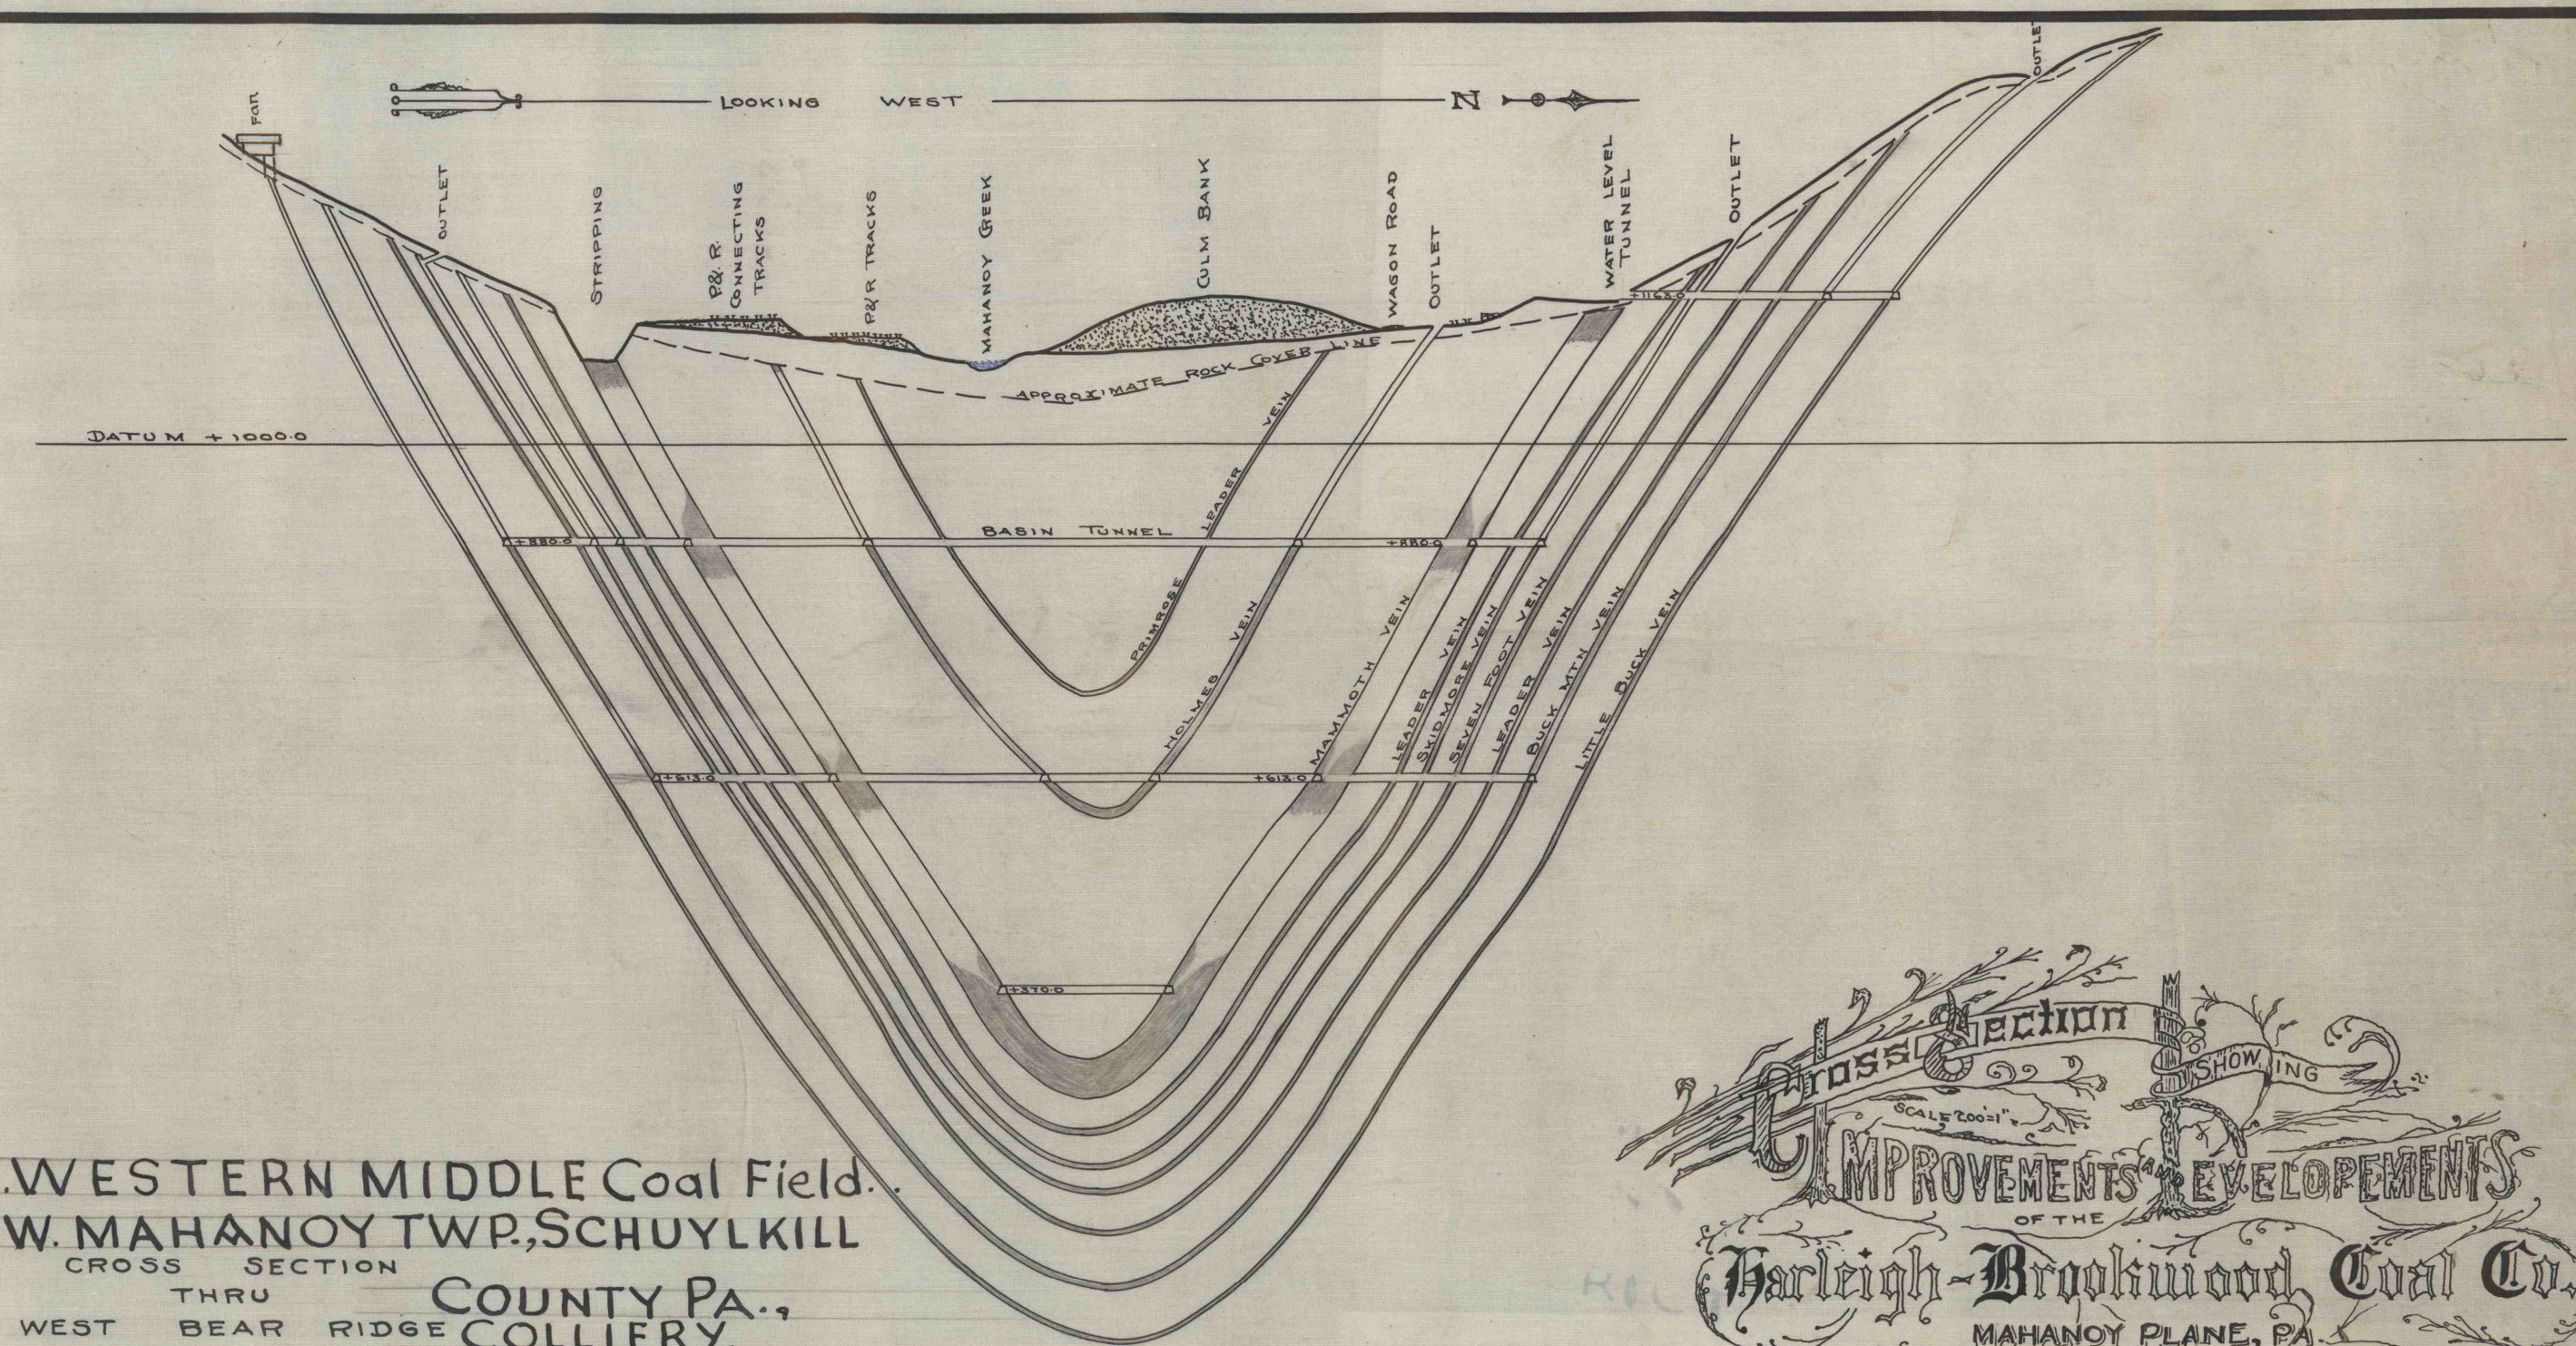

Cross Section
SHOWING
IMPROVEMENTS & DEVELOPMENTS
OF THE
Harleigh-Brookwood Coal Co.
MAHANOT PLANE, PA.
JUNE 1915