



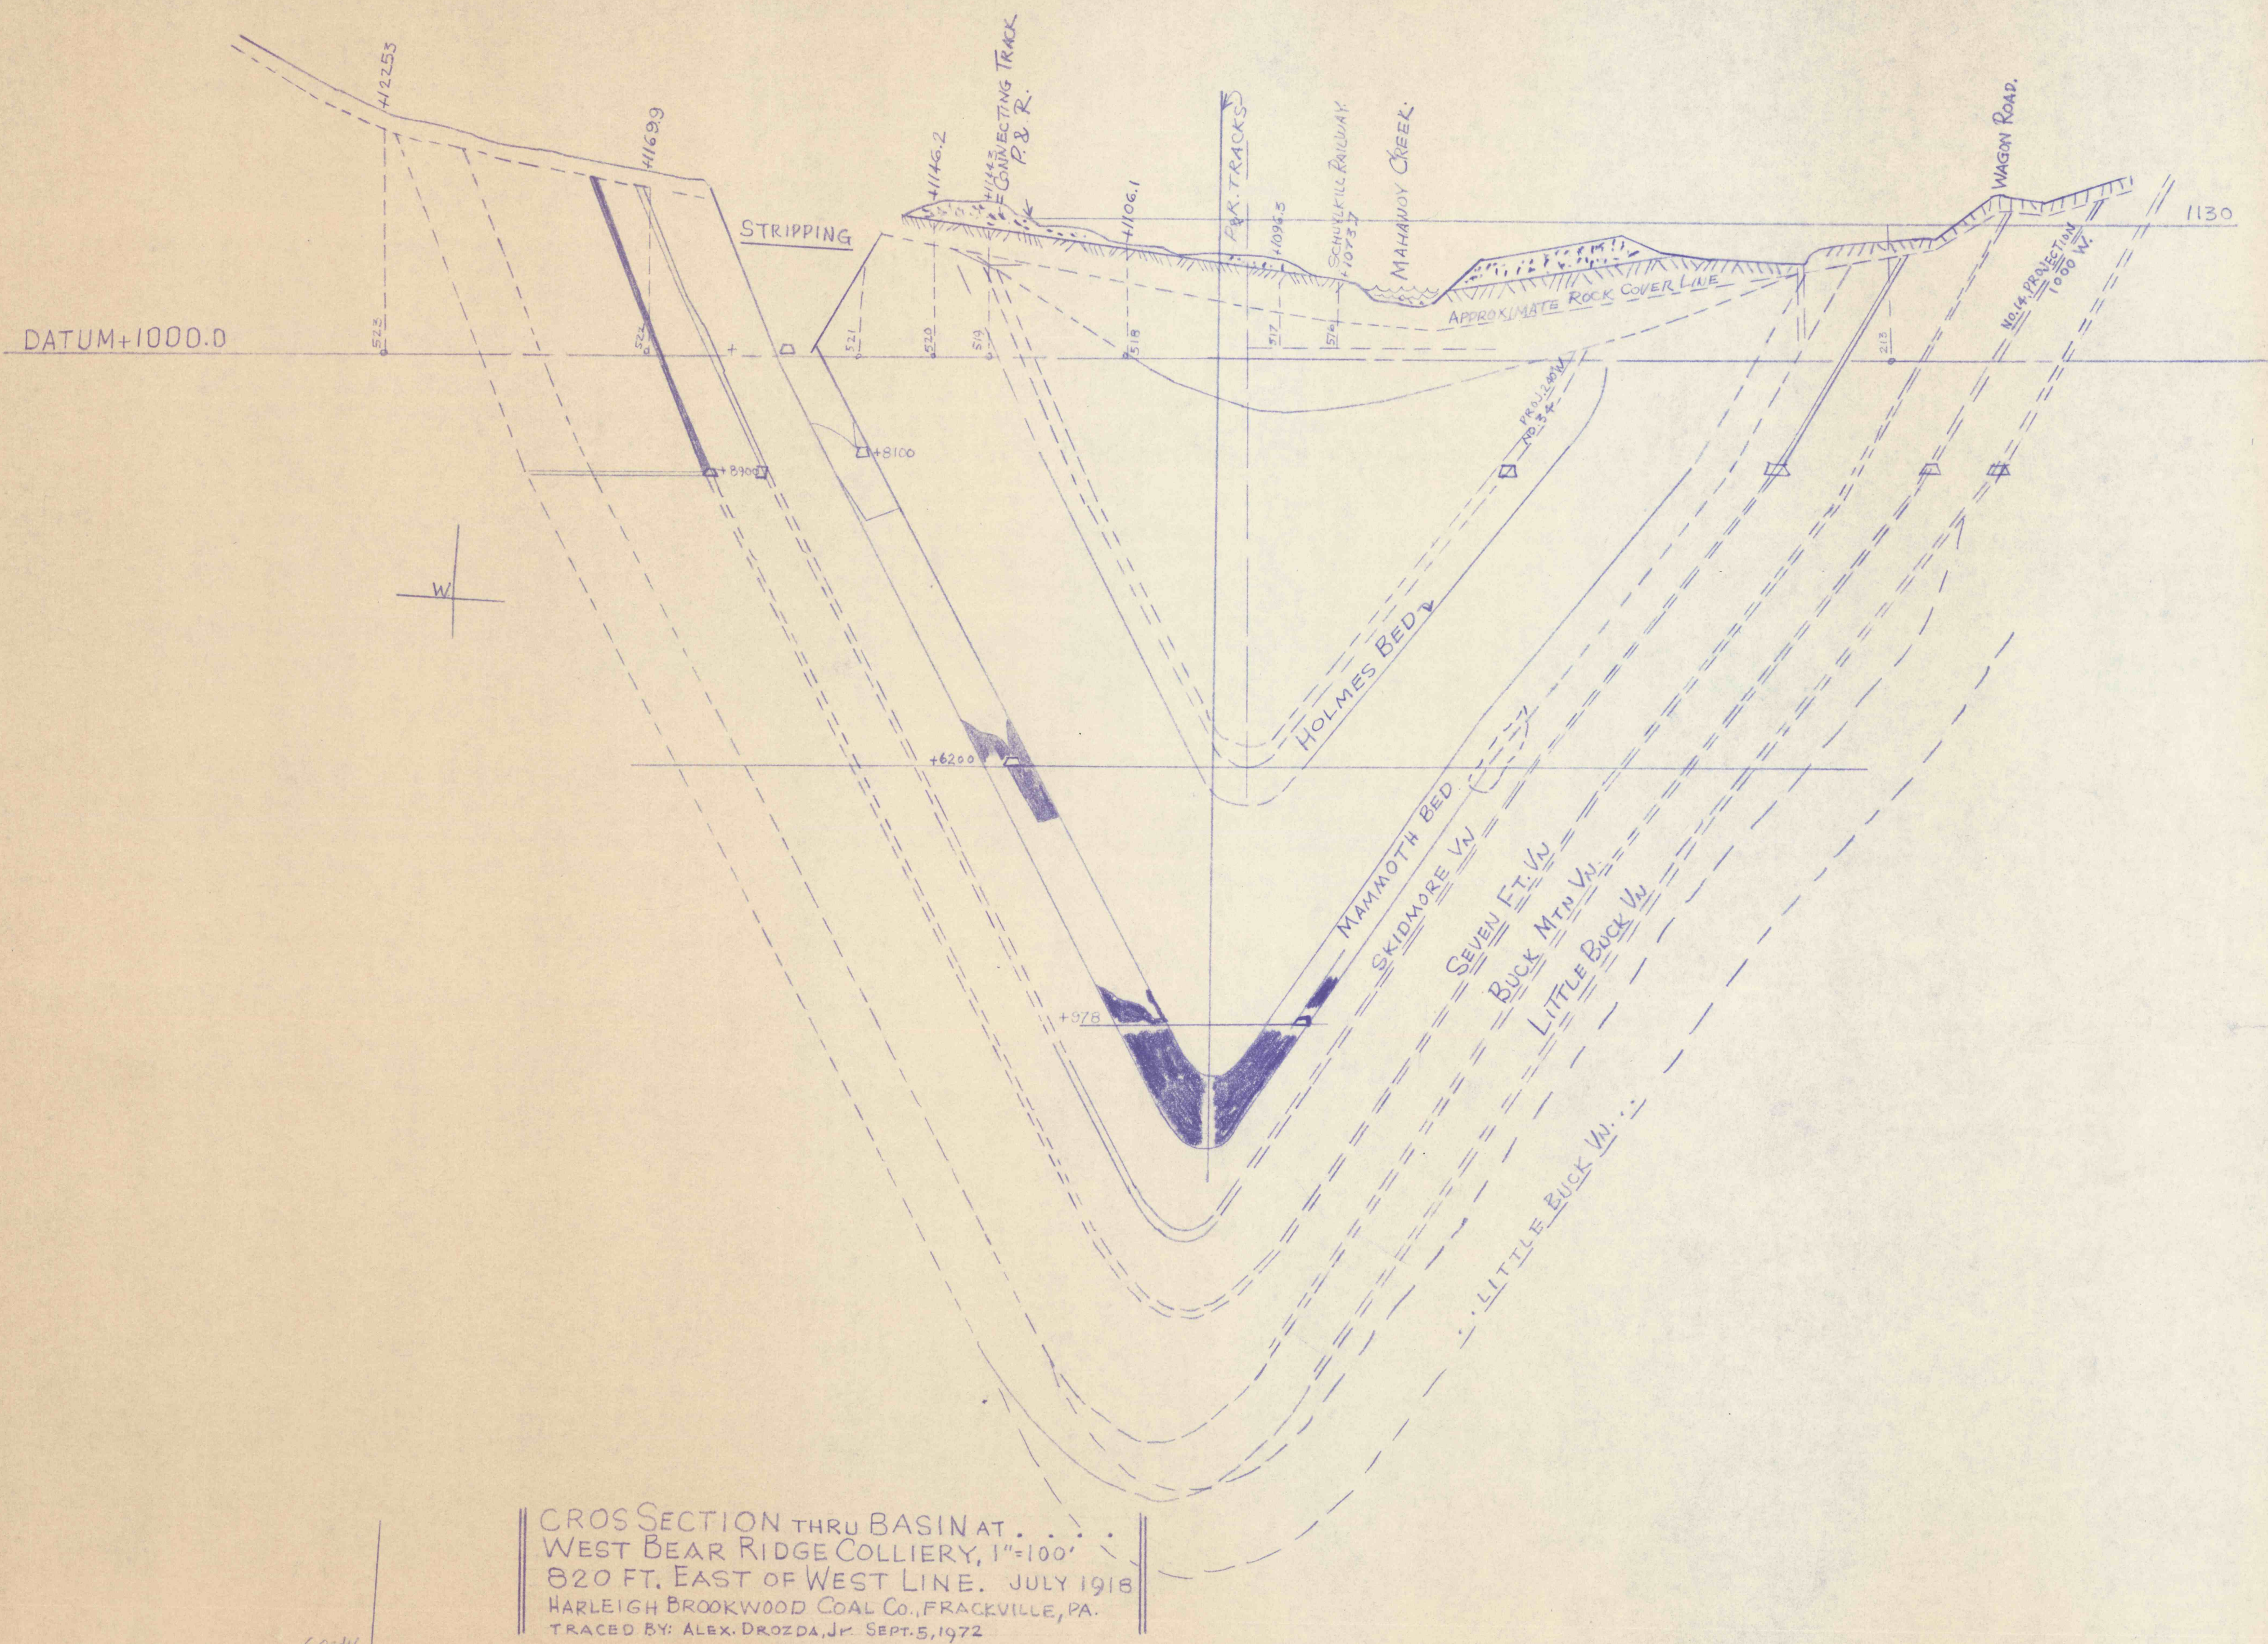

Section 300' WEST of
 WEST LINE of WEST BEAR RIDGE
 Colliery.

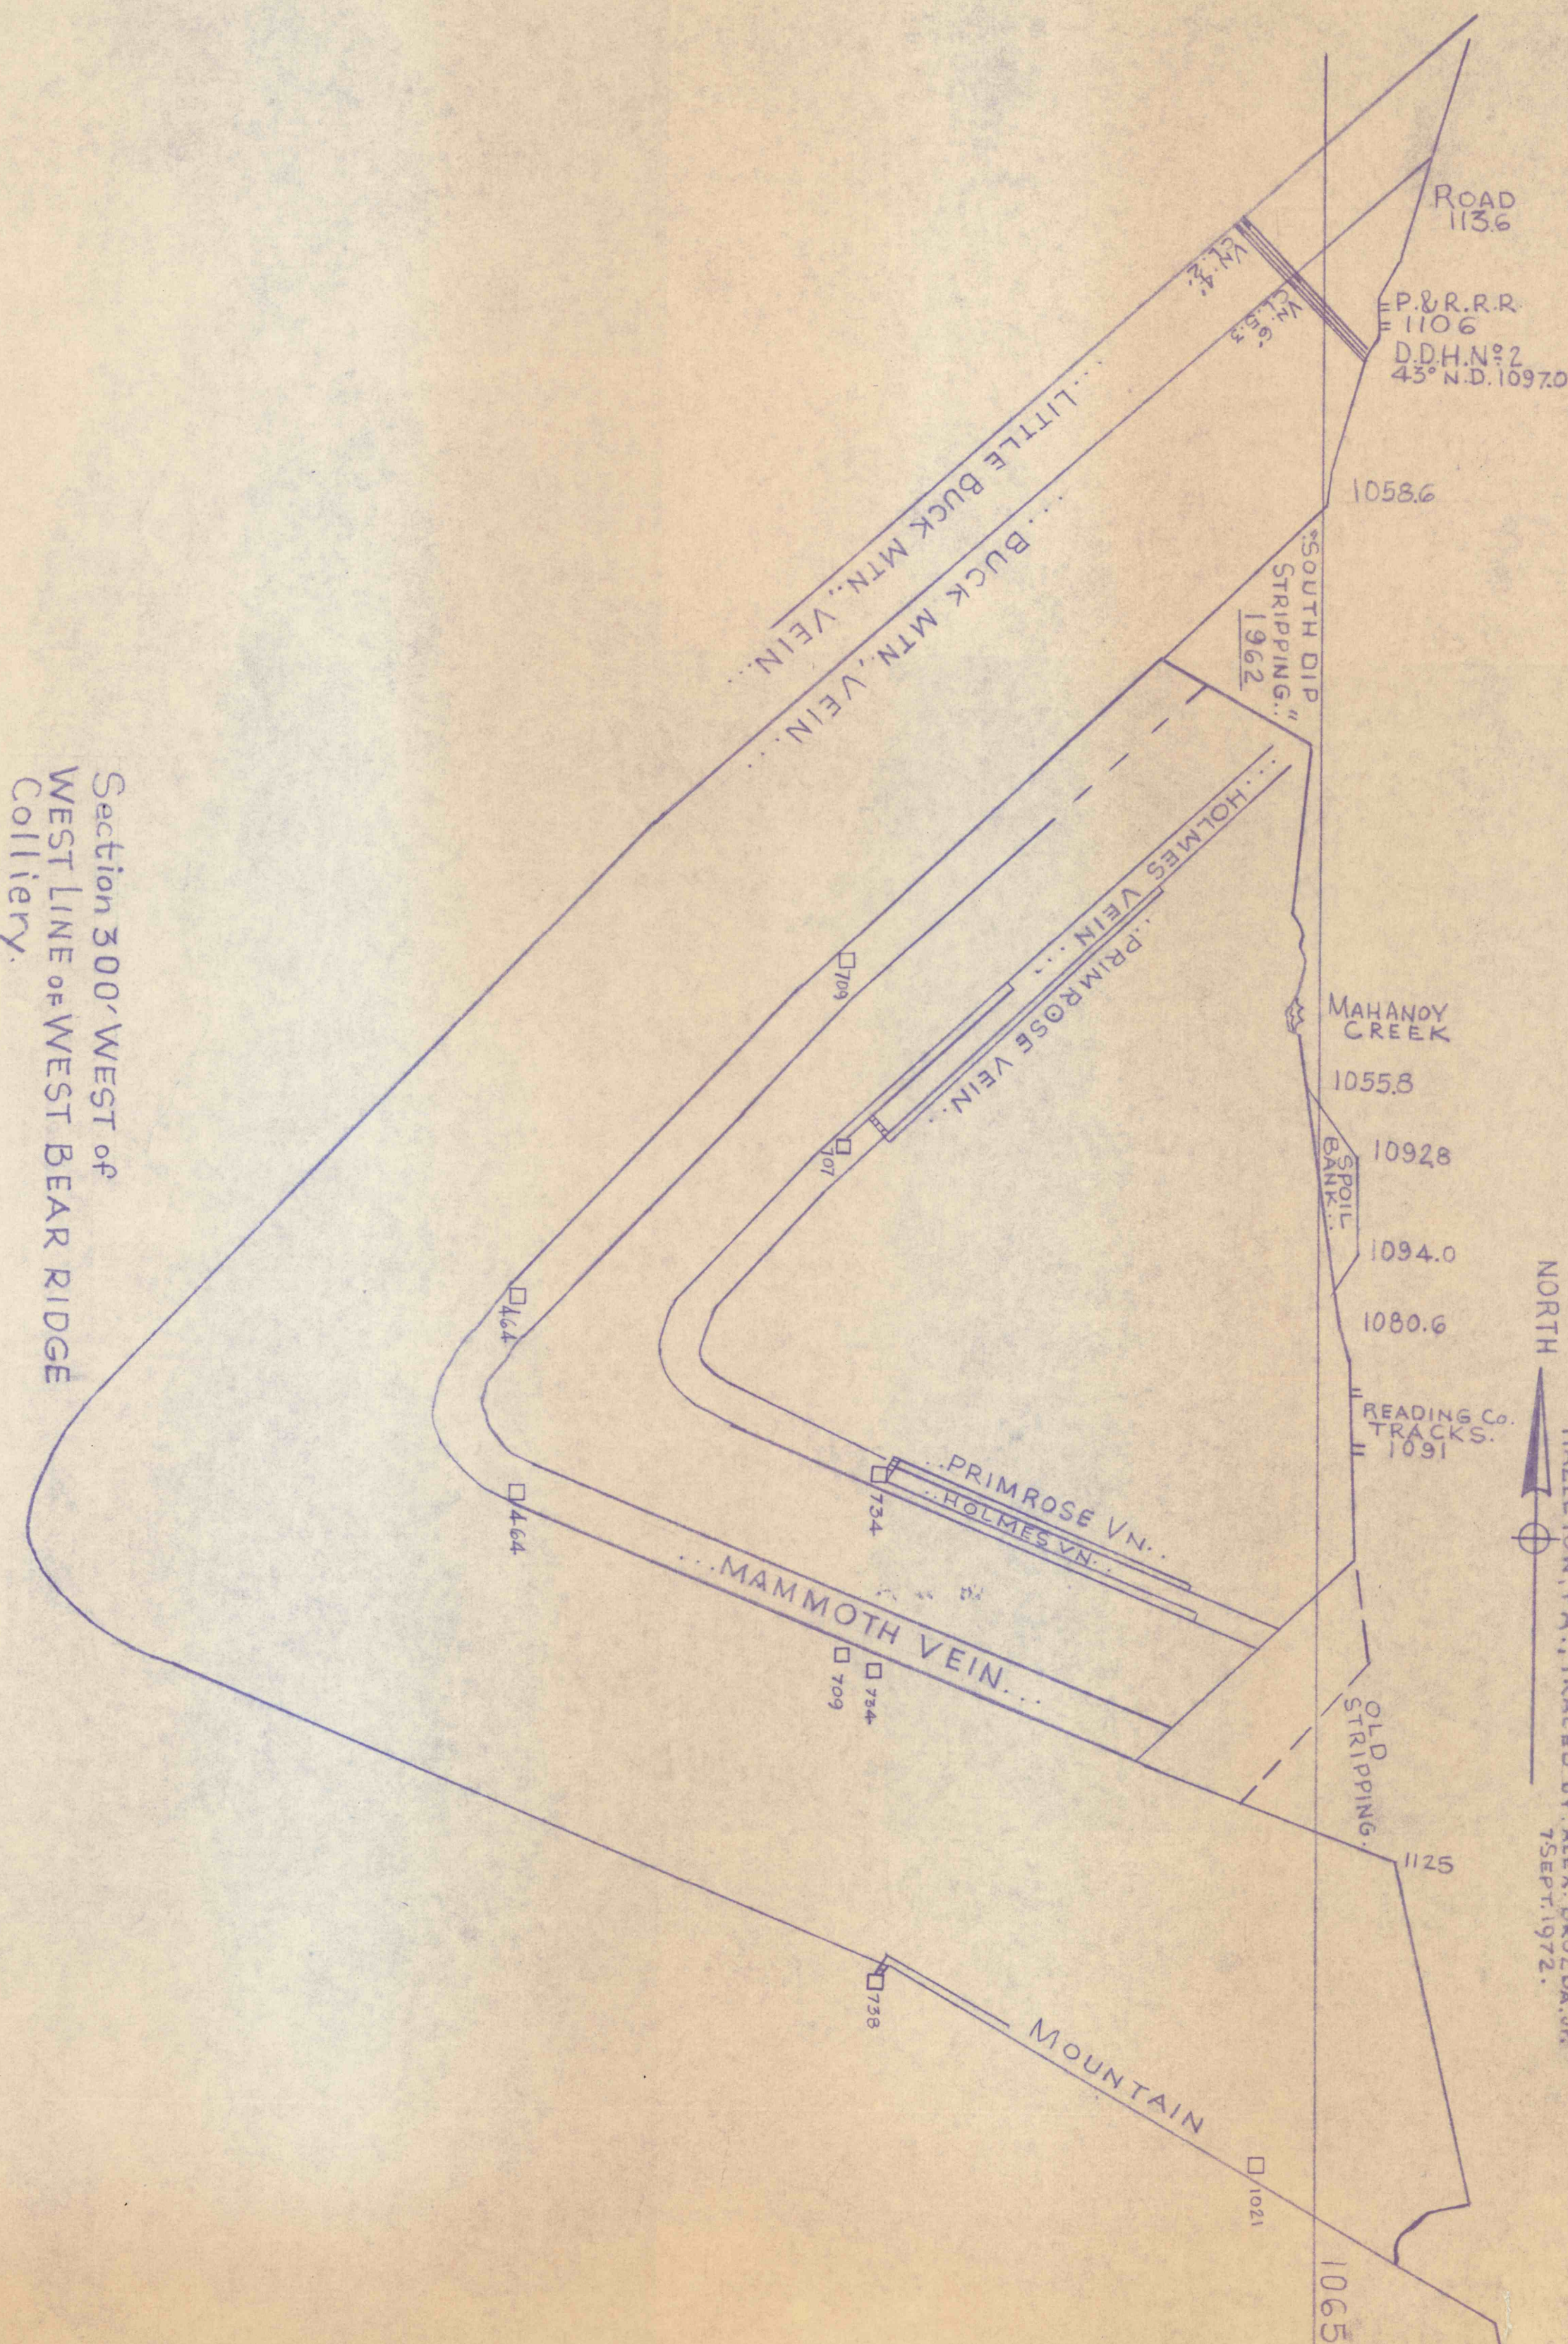

ON COORDINATE LINE, EAST 1000
 GIRARD COLLIERY
 HAZLE BROOK COAL CO.
 ENG. DEPARTMENT
 HAZLETON, PA., TRACED BY: ALEX. DROZDA, JR.
 OCT. 21, 1926
 SCALE: 1"=100'
 NORTH
 SEPT. 1972