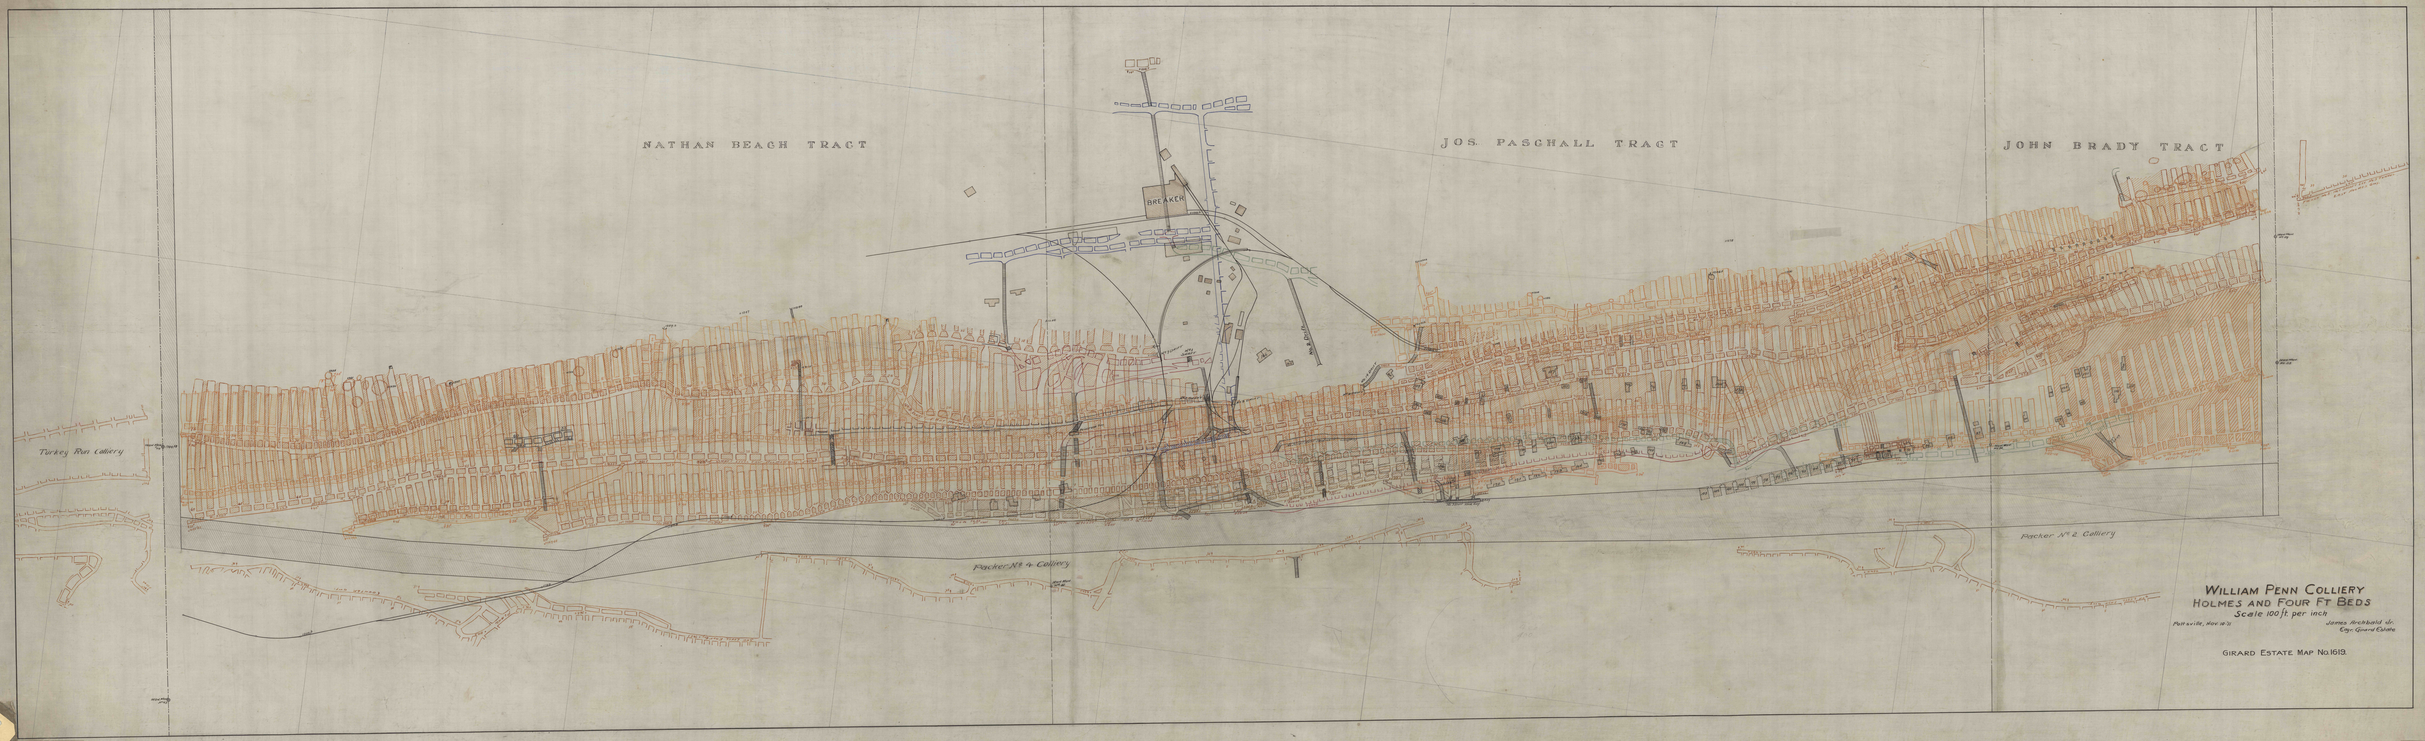

WILLIAM PENN COLLIERY
HOLMES AND FOUR FT BEDS
Scale 100 ft. per inch

Pottsville, Nov 19 '71

James Archbald Jr.
Engr. Girard Estate

GIRARD ESTATE MAP No. 1619.