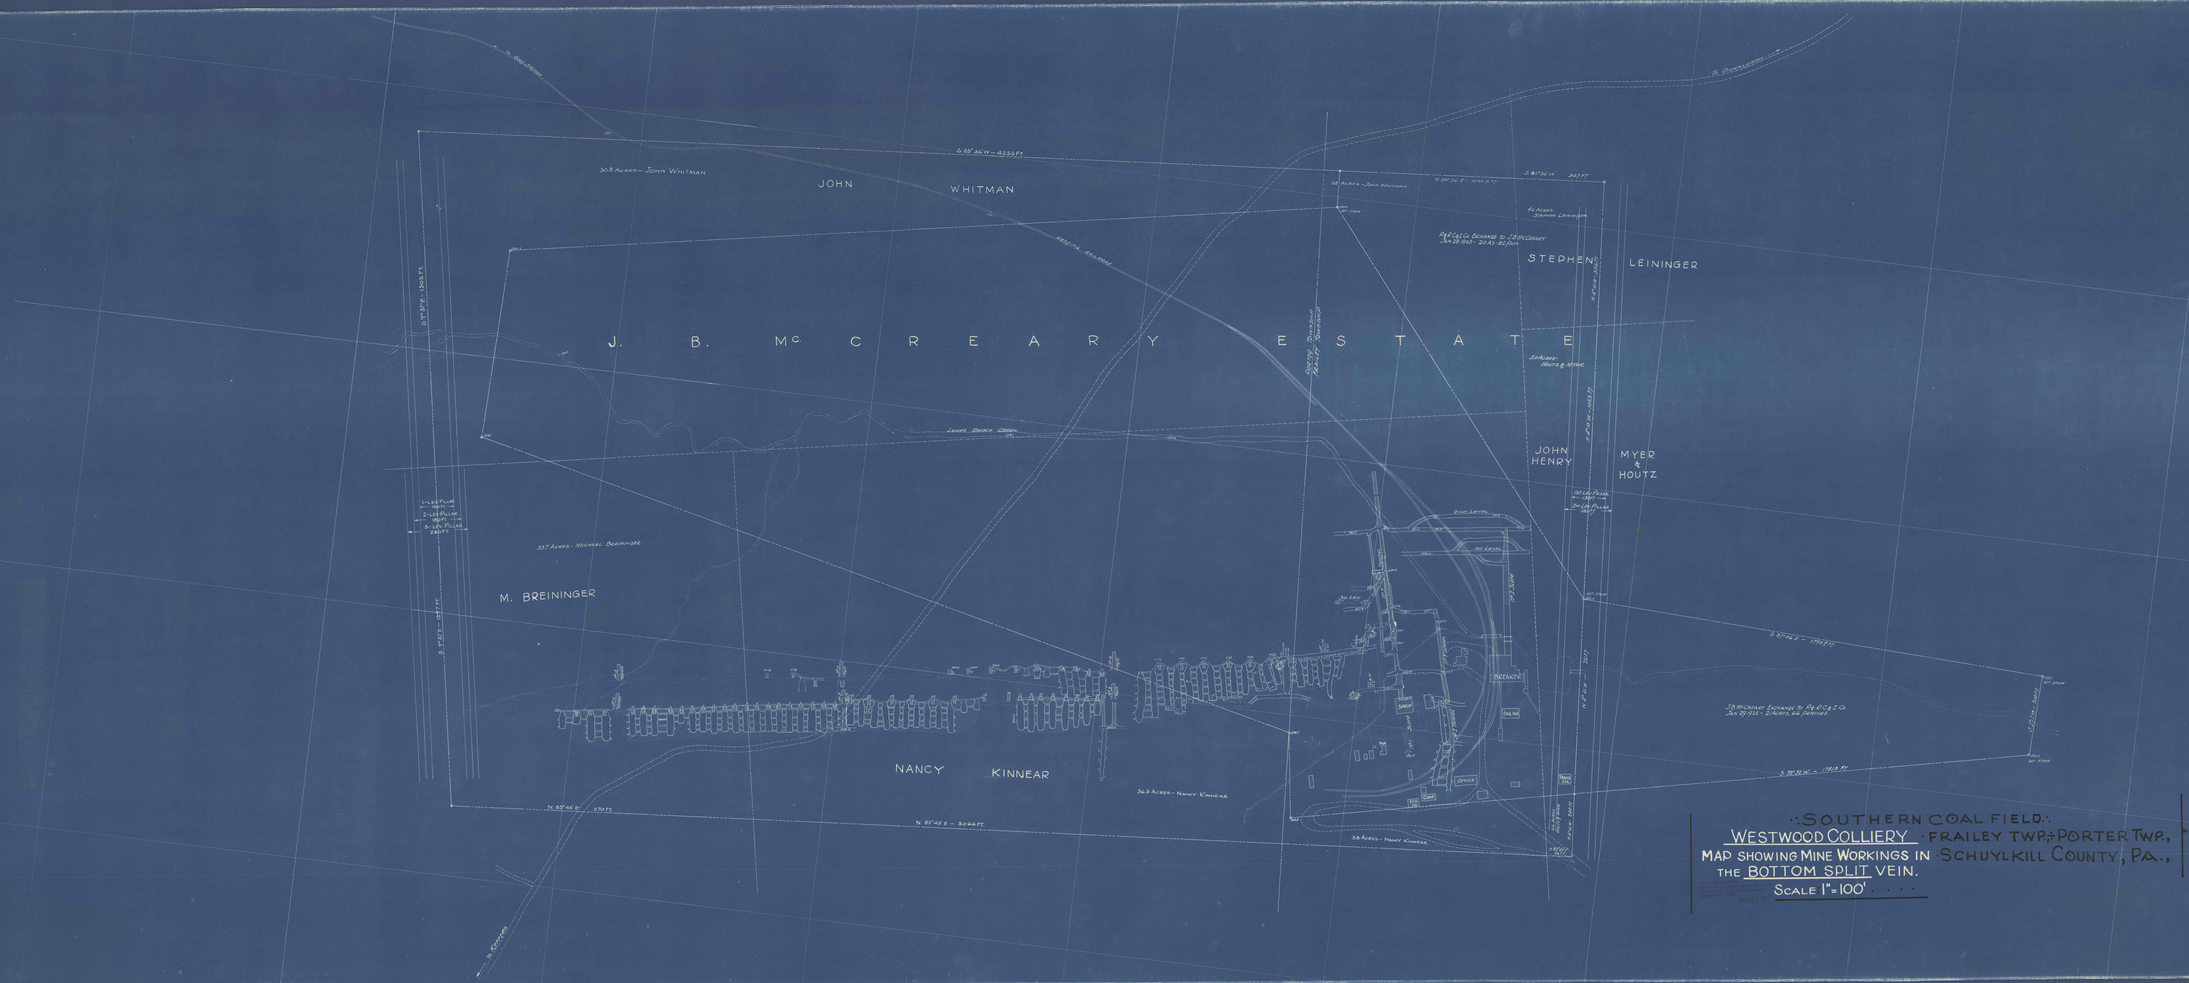


SOUTHERN COAL FIELD.

WESTWOOD COLLIERY · FRAILEY TWP. & PORTER TWP.,

MAP SHOWING MINE WORKINGS IN SCHUYLKILL COUNTY, PA.,

THE BOTTOM SPLIT VEIN.

SCALE 1" = 100'