


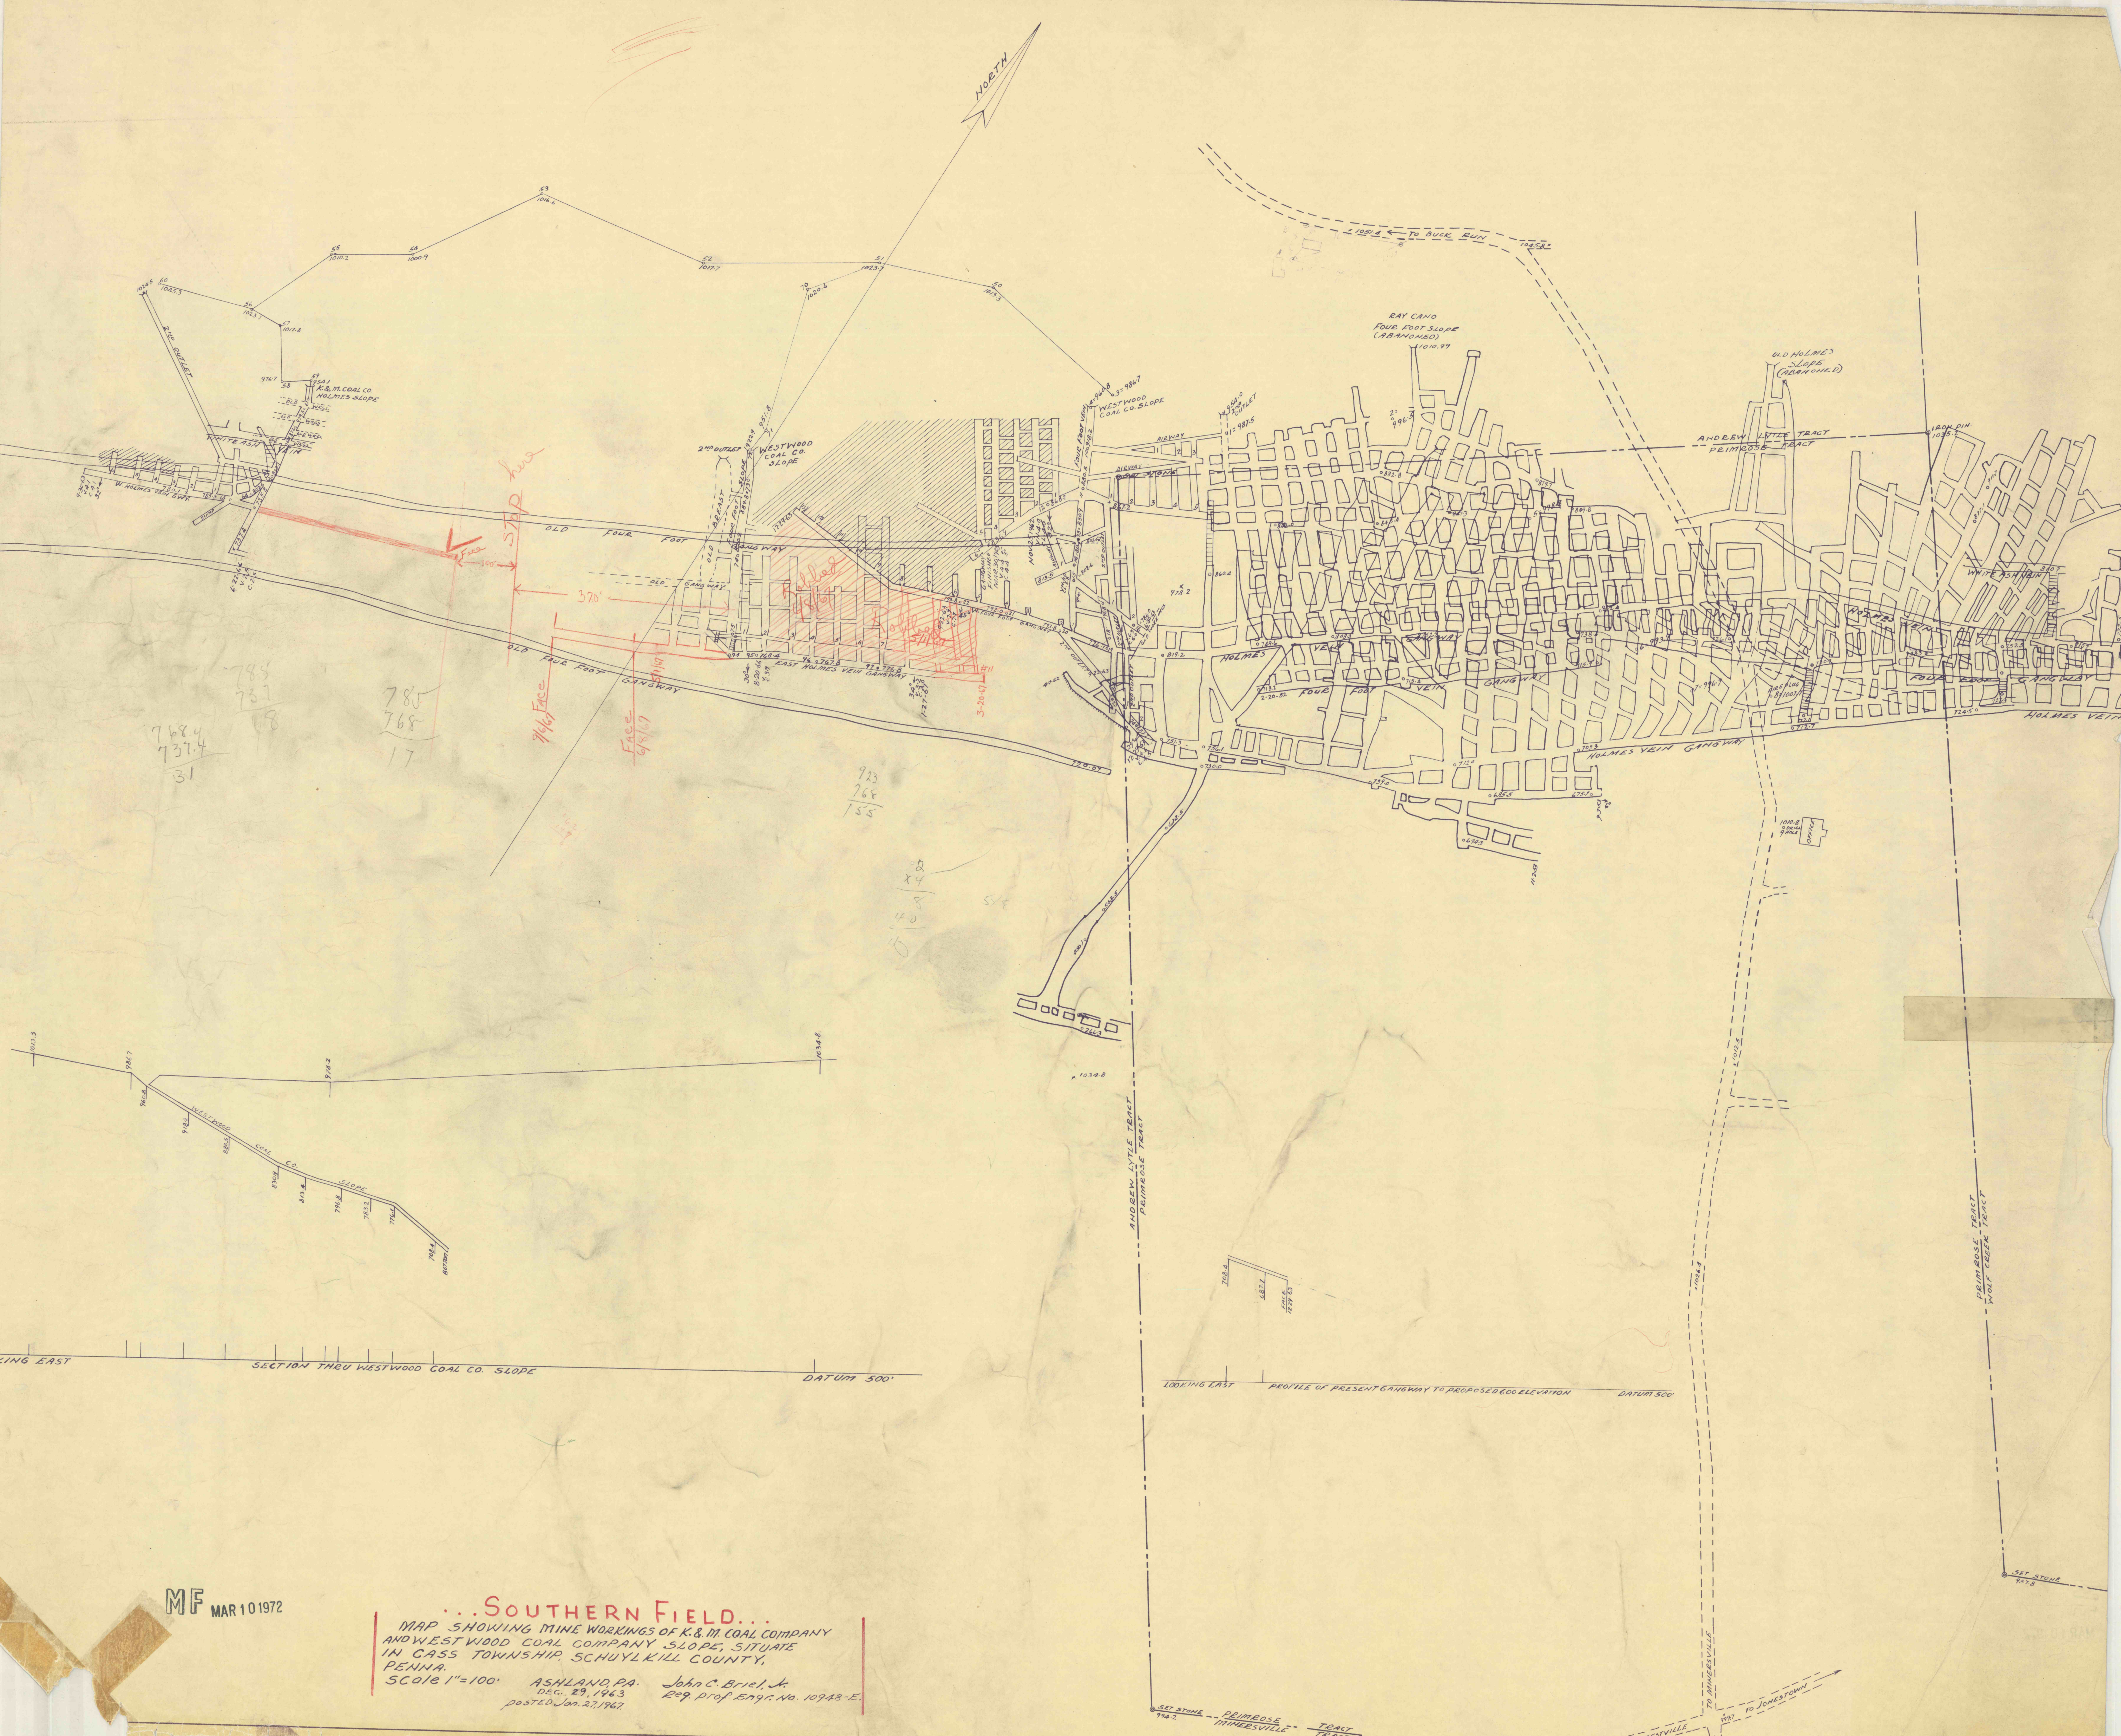

MF MAR 10 1972

...SOUTHERN FIELD...  
MAP SHOWING MINE WORKINGS OF K. & M. COAL COMPANY  
AND WESTWOOD COAL COMPANY SLOPE, SITUATE  
IN CASS TOWNSHIP SCHUYLKILL COUNTY,  
PENNA.  
Scale 1"=100' ASHLAND, PA. John C. Bruel, Jr.  
Dec. 29, 1963 Reg. Prof. Eng'g No. 10948-E.  
POSTED Jan. 27, 1967