


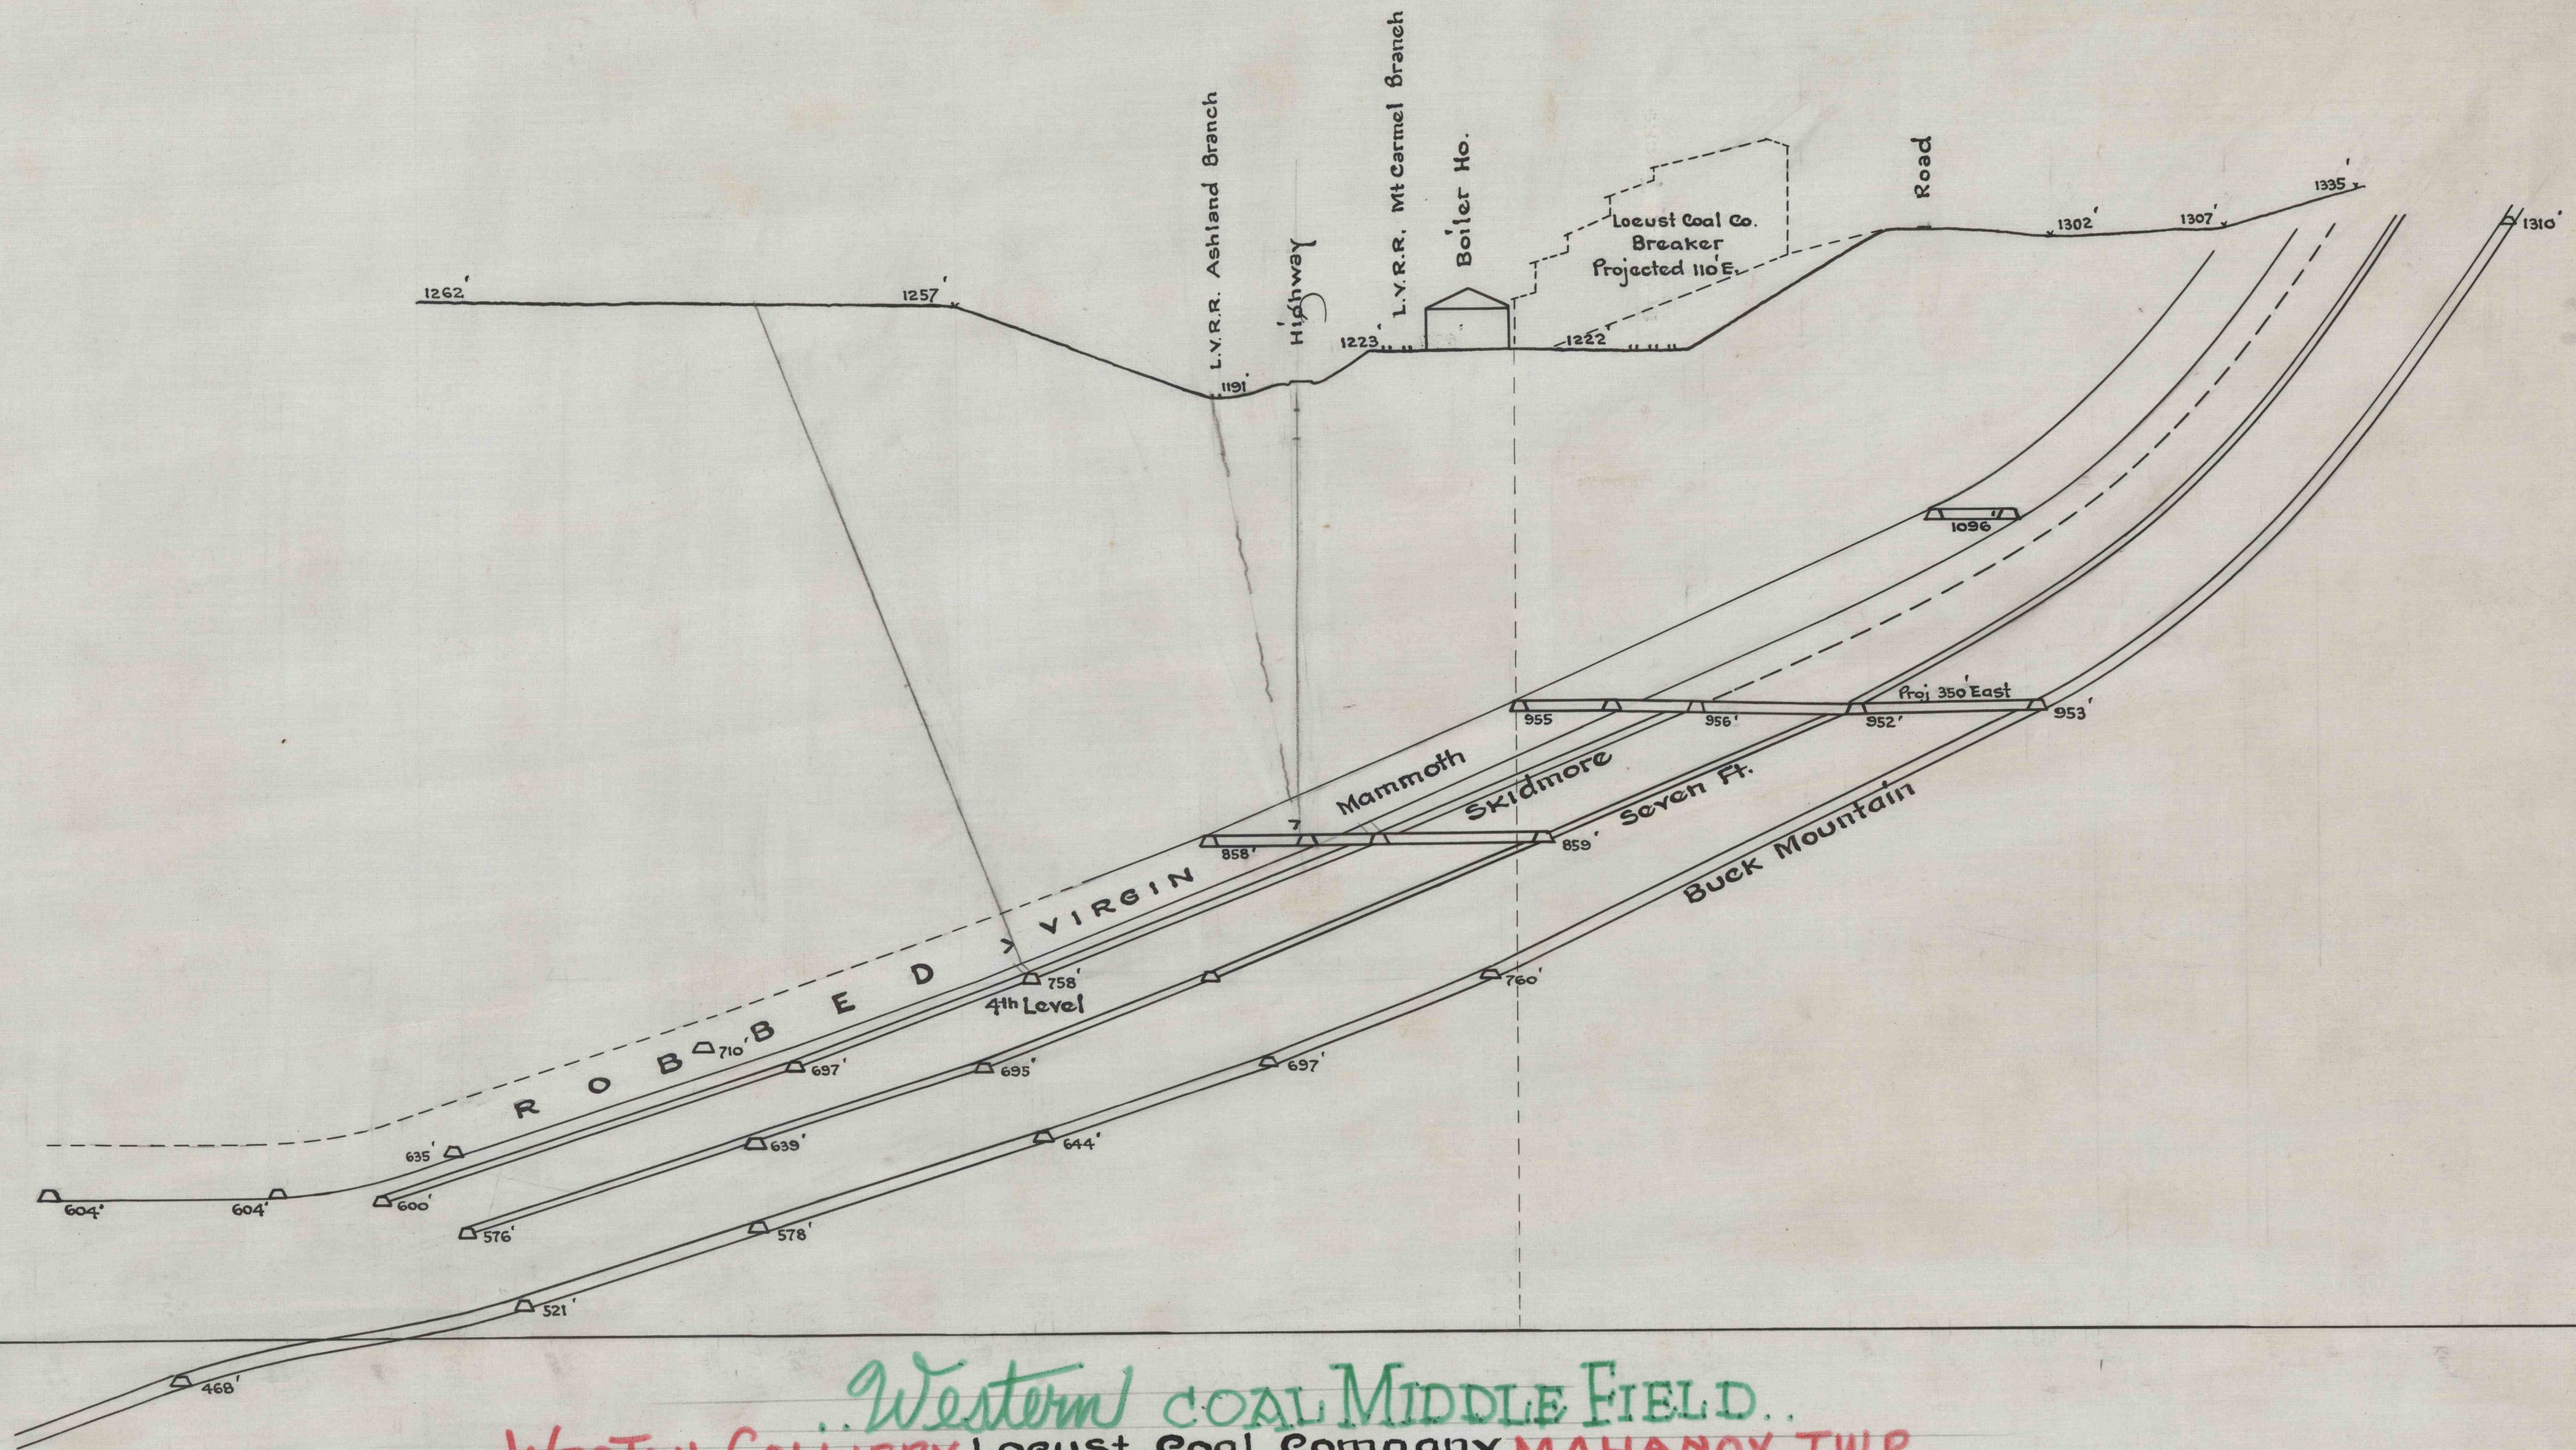

..Western COAL MIDDLE FIELD..
 WESTON COLLIERY, Loeust Coal Company MAHANOTW P.,
 Cross Section Thro. #9 Rock Hole and Pillar Hole
 East Fourth Level Mammoth No. 3
 • scale 100' = 1" Apr. 5, 1940 Eng. Dept. Loeust Coal Co.
 WEST MAHANOTW DISTRICT.. SCHUYLKILL COUNTY, PA.,
 ..Cross Section "C"