


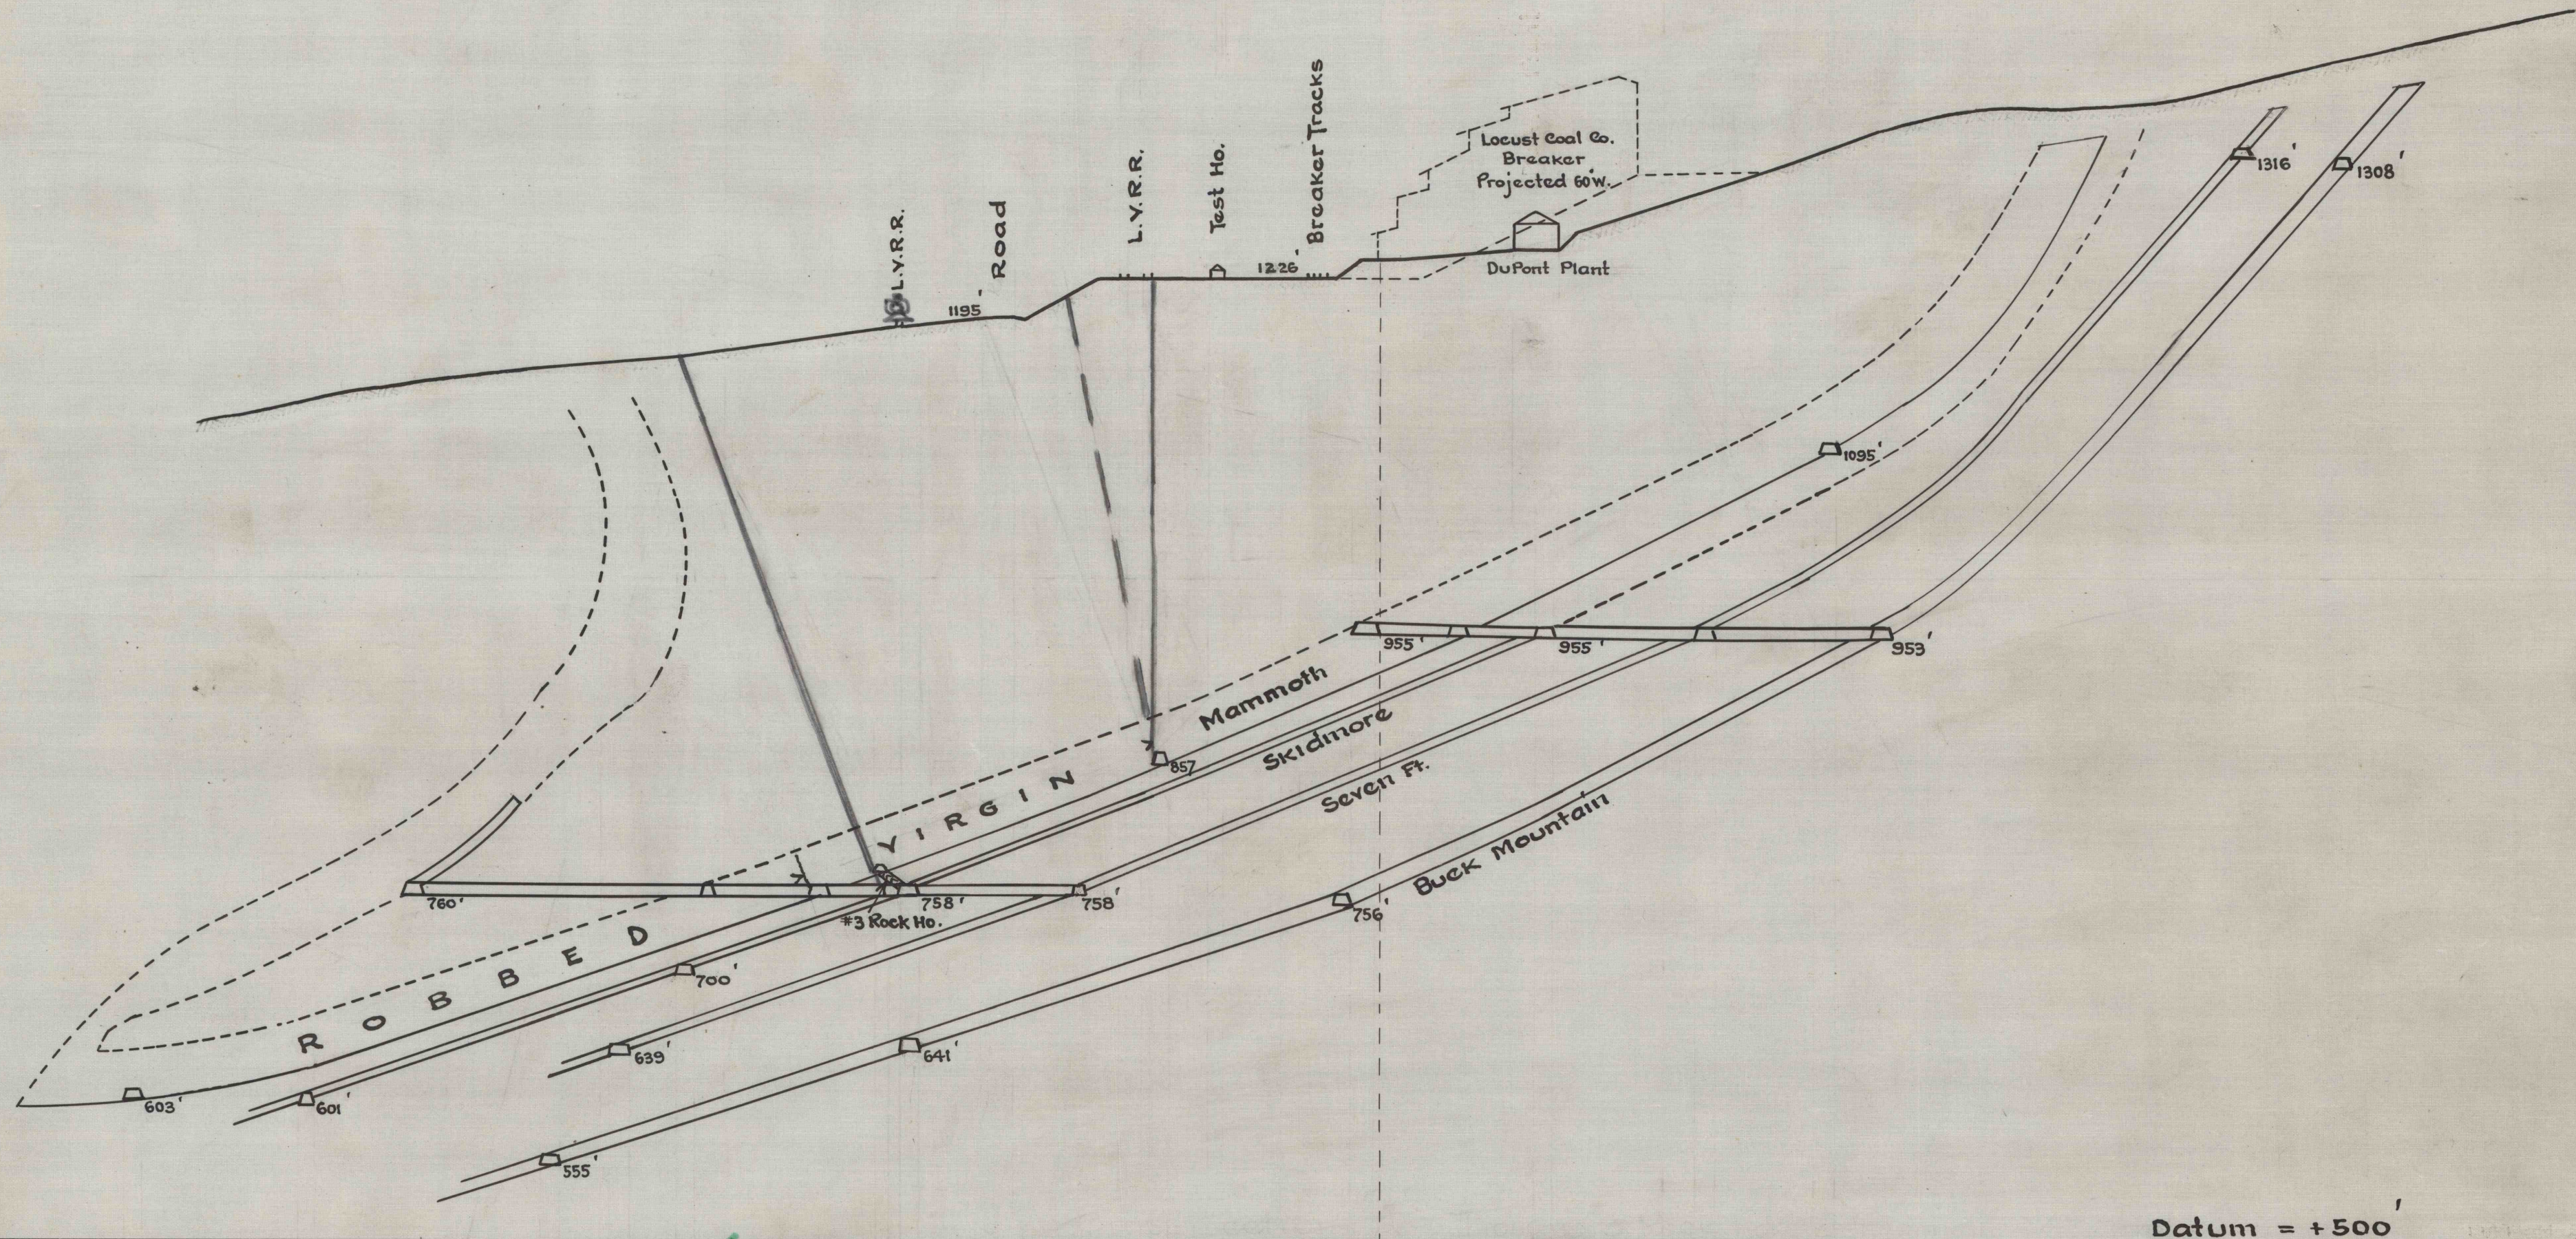

Western Middle Field
WESTON COLLIERY, Locust coal company MAHANOTWY TWP.,
 Cross Section Thro. #3 Rock Hole and Pillar Hole
 East Fourth Level Mammoth - No. 3
 • scale 100' = 1" • Apr. 5, 1940, Eng. Dept. Locust Coal Co.
WEST MAHANOTWY DISTRICT, SCHUYLKILL COUNTY, PA.,
cross section "A"