
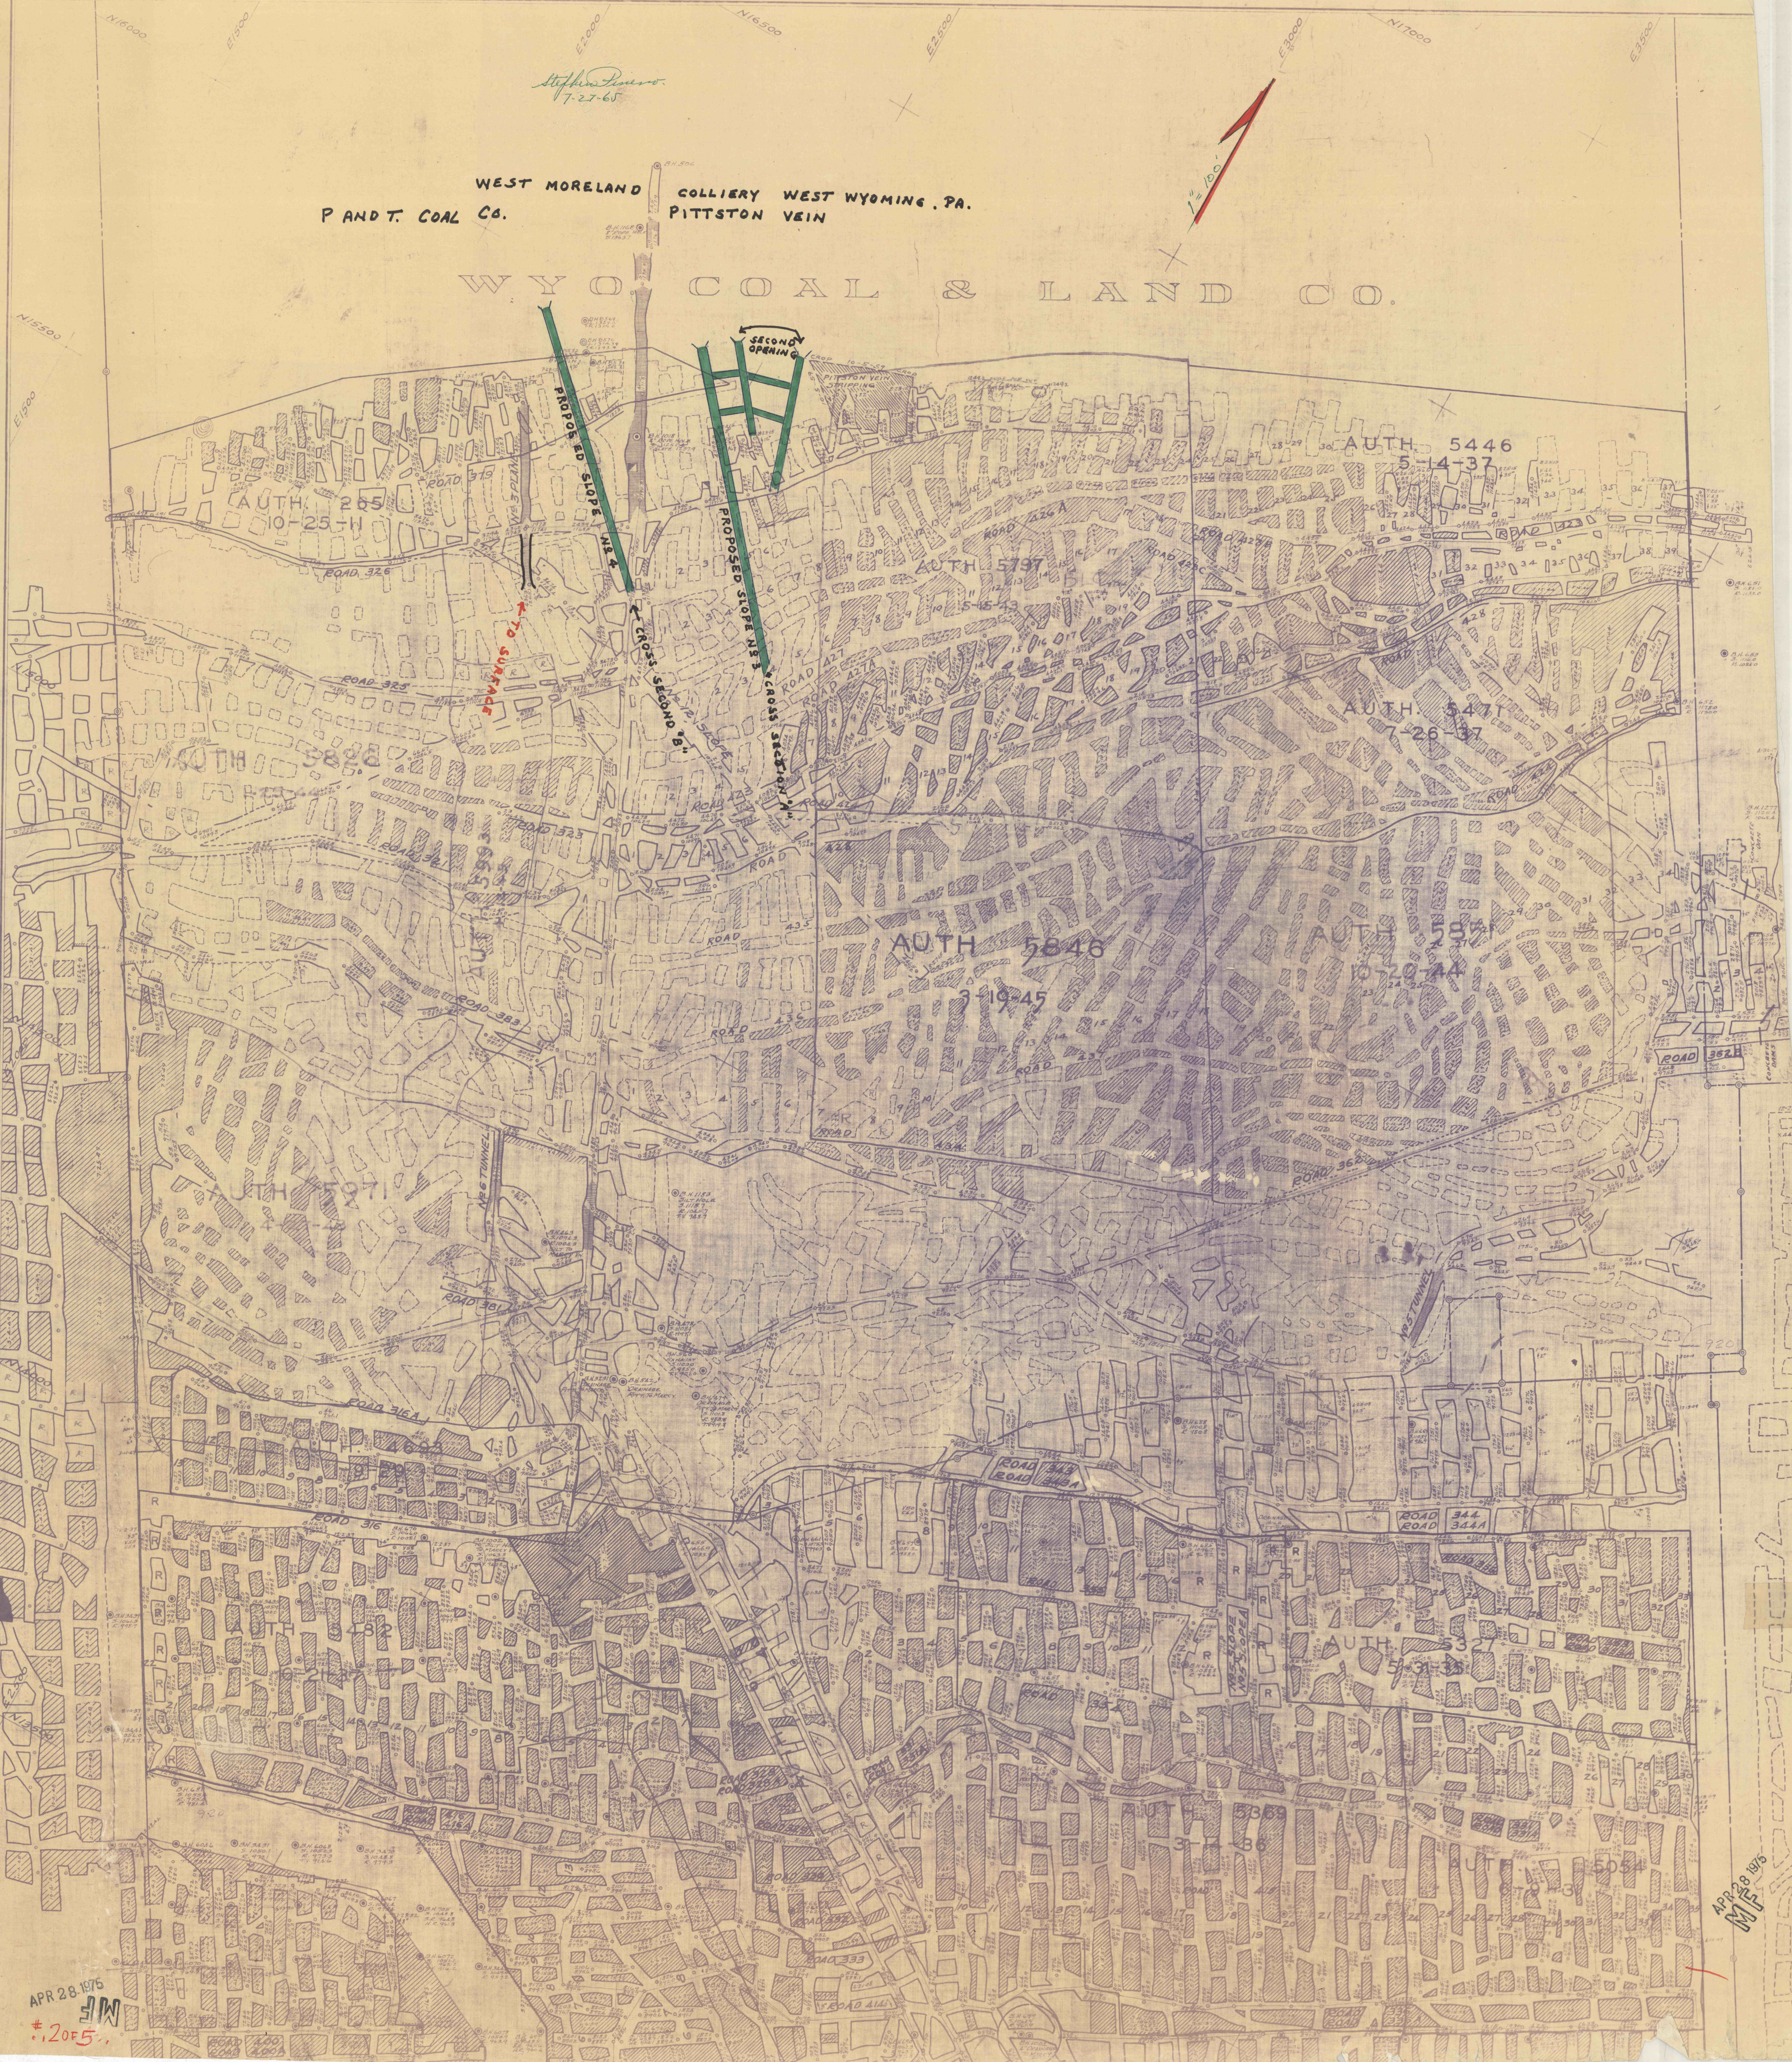


WEST MORELAND
P AND T. COAL CO.

COLLIERY WEST WYOMING, PA.

WYO COAL & LAND CO.

Stephen D. ...
7-27-65

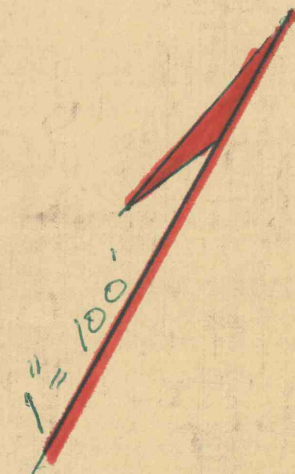


MF