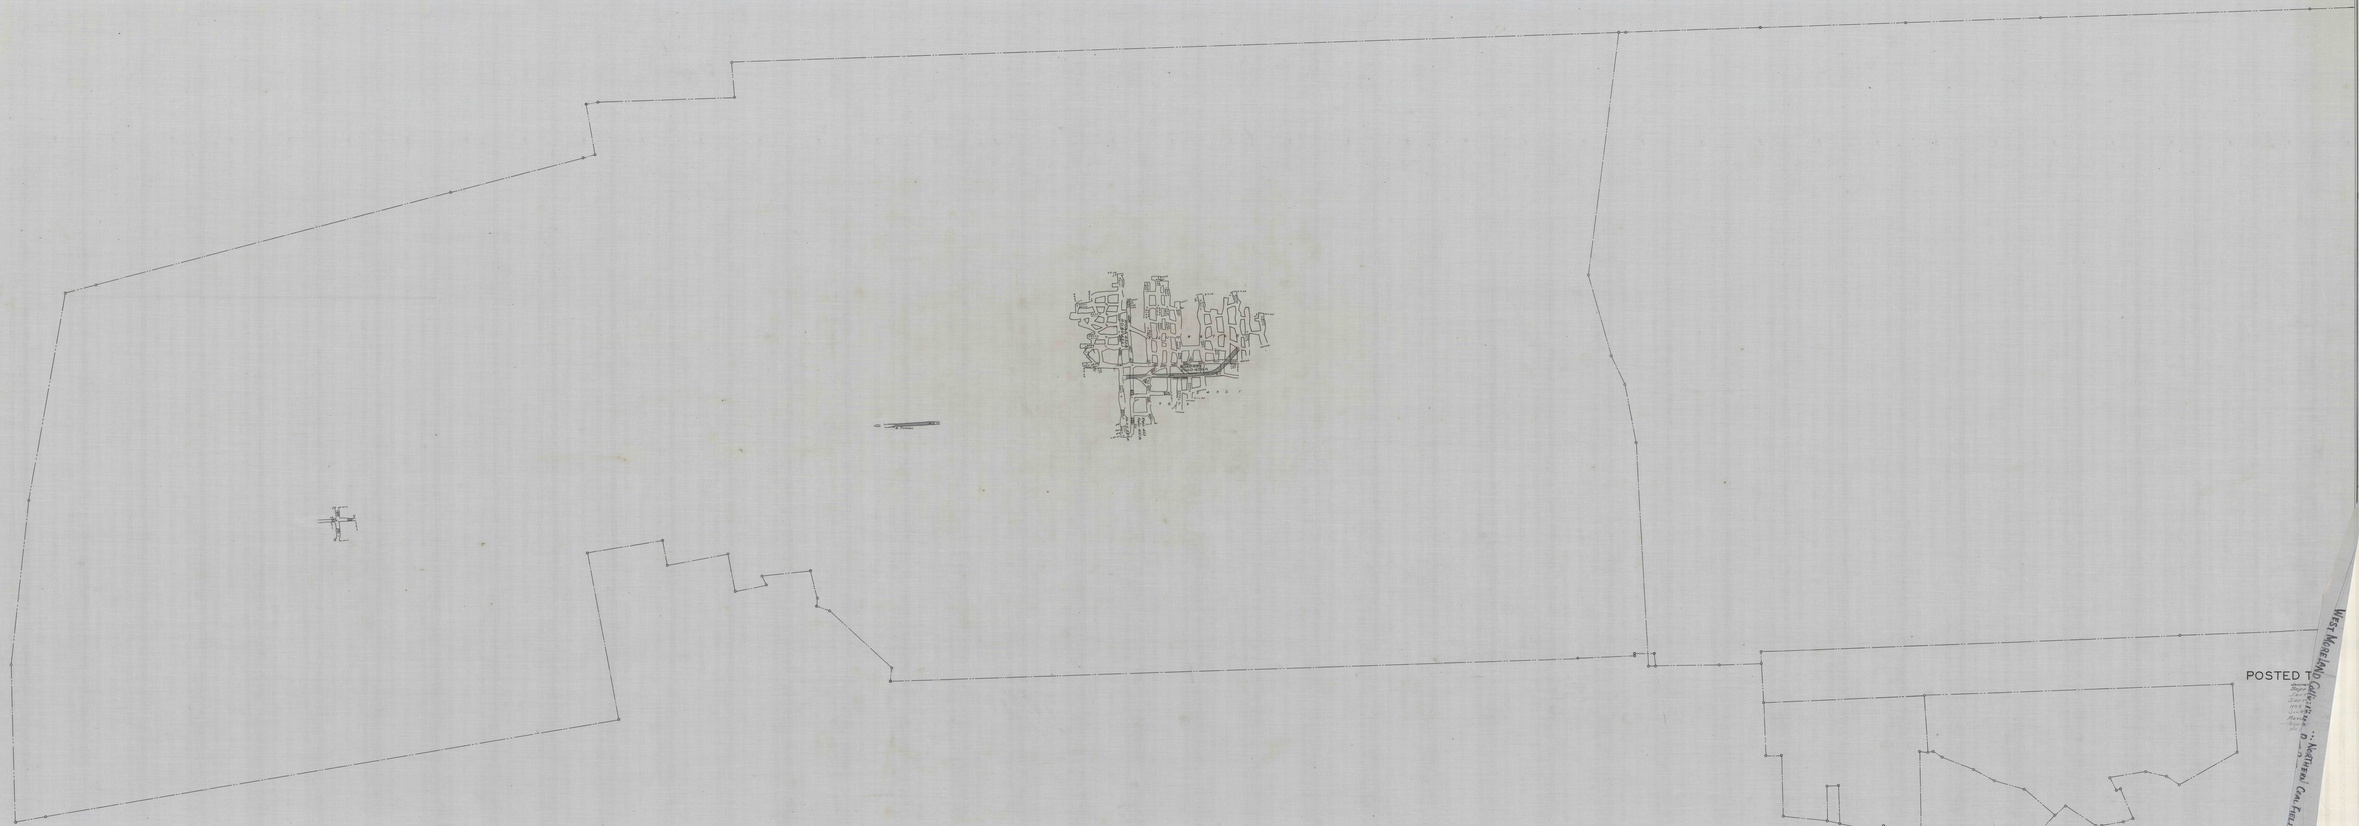

POSTED T

WESTMORELAND

BOTT PITTSTON VI

Scale 1" to 100' Datum 500' Below Tid

MINE INSPECTOR'S TRAC

West Moreland Coal Co. - Natural Gas Fields