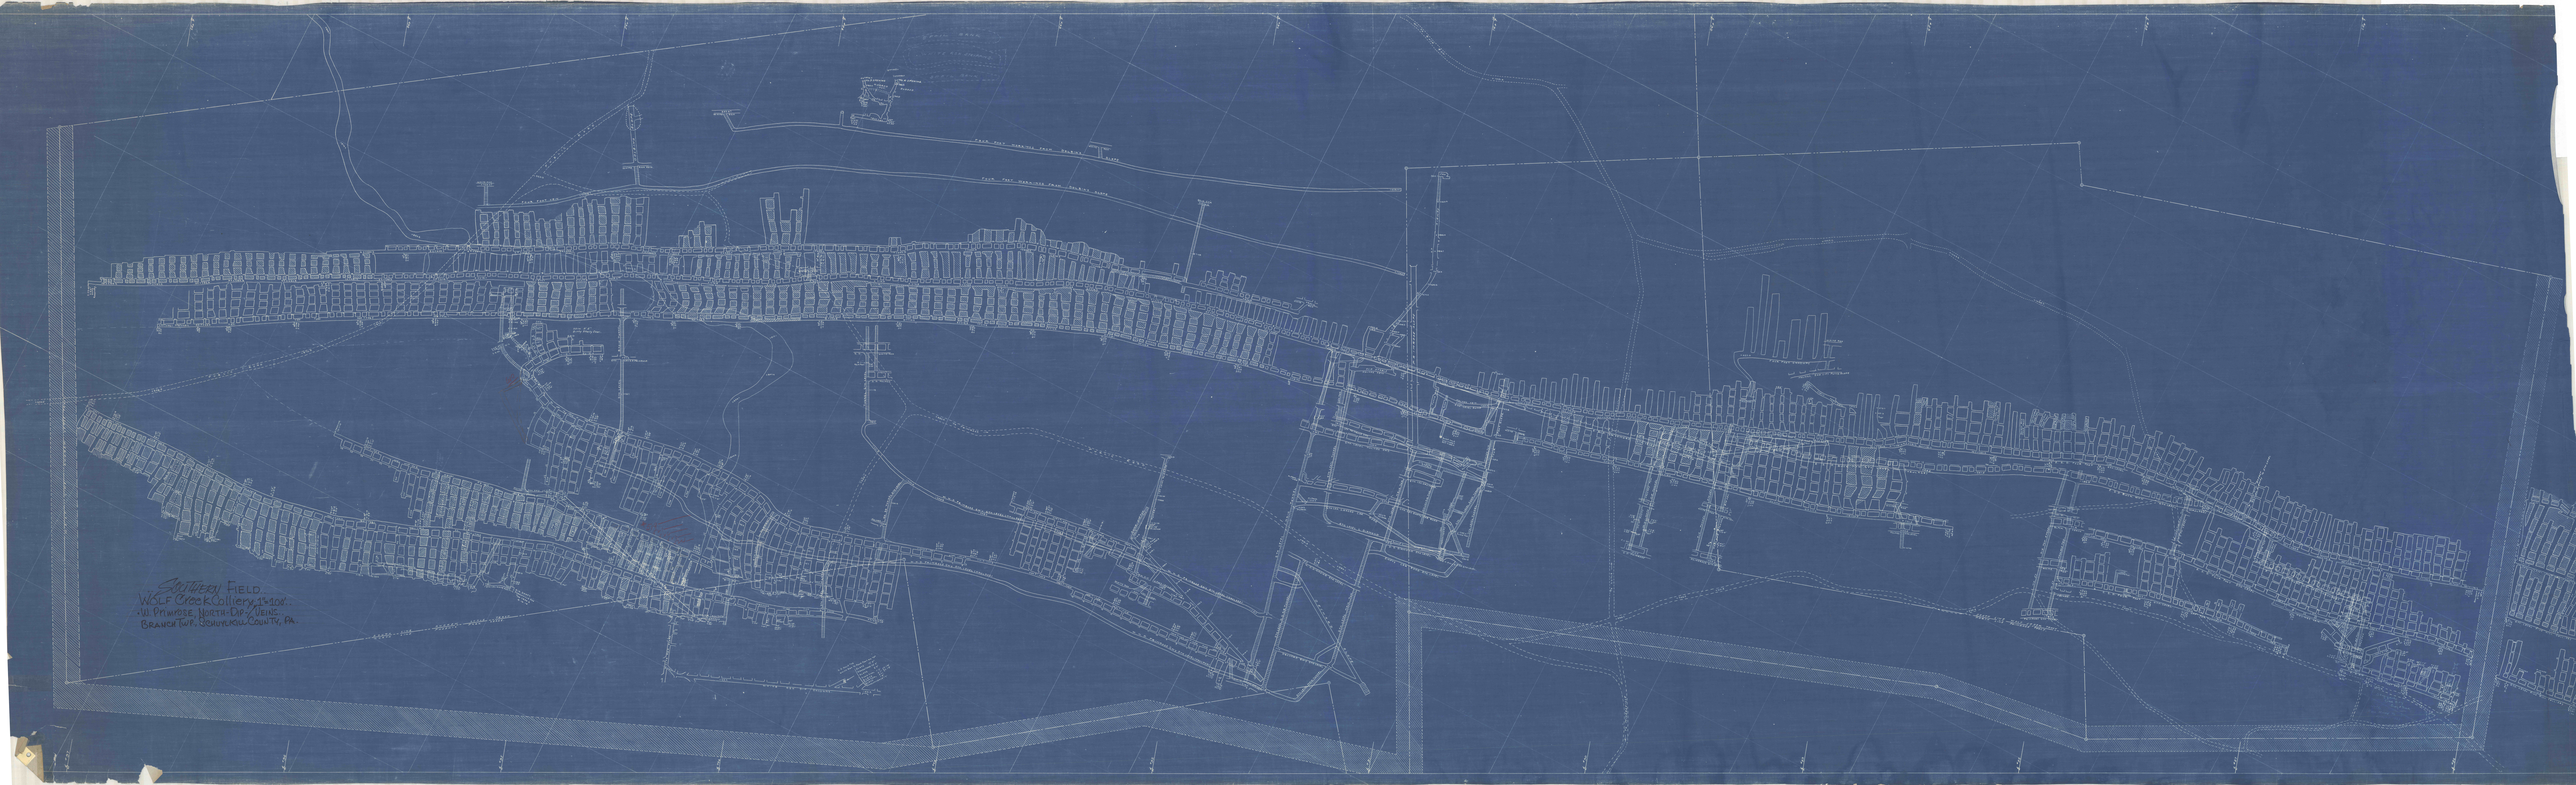

WOLF CREEK COLLIERY 1"=100'
W. PRIMROSE NORTH-DIP SECTS.
BRANCH TWP. SCHUYLKILL COUNTY, PA.