

20
TOP RED ASH -

WOODWARD

LANCE COLLIERY.

SECTION "L"


SOUTH WILKES-BARRE COLLIERY.

SECTION "K"

SECTION "J"

.. NORTHERN COAL FIELD..
WOODWARD Colliery: 1st 100'.
TOP RED ASH VEIN..
PLYMOUTH TWP. PA.,
LUZERNE COUNTY.. MARCH 1954..
.. GLEN ALDEN COAL CO.,

.. LEGEND..
→ TRAVEL ROUTE
XXX CAVE AND FALLS
/// JUNCTION

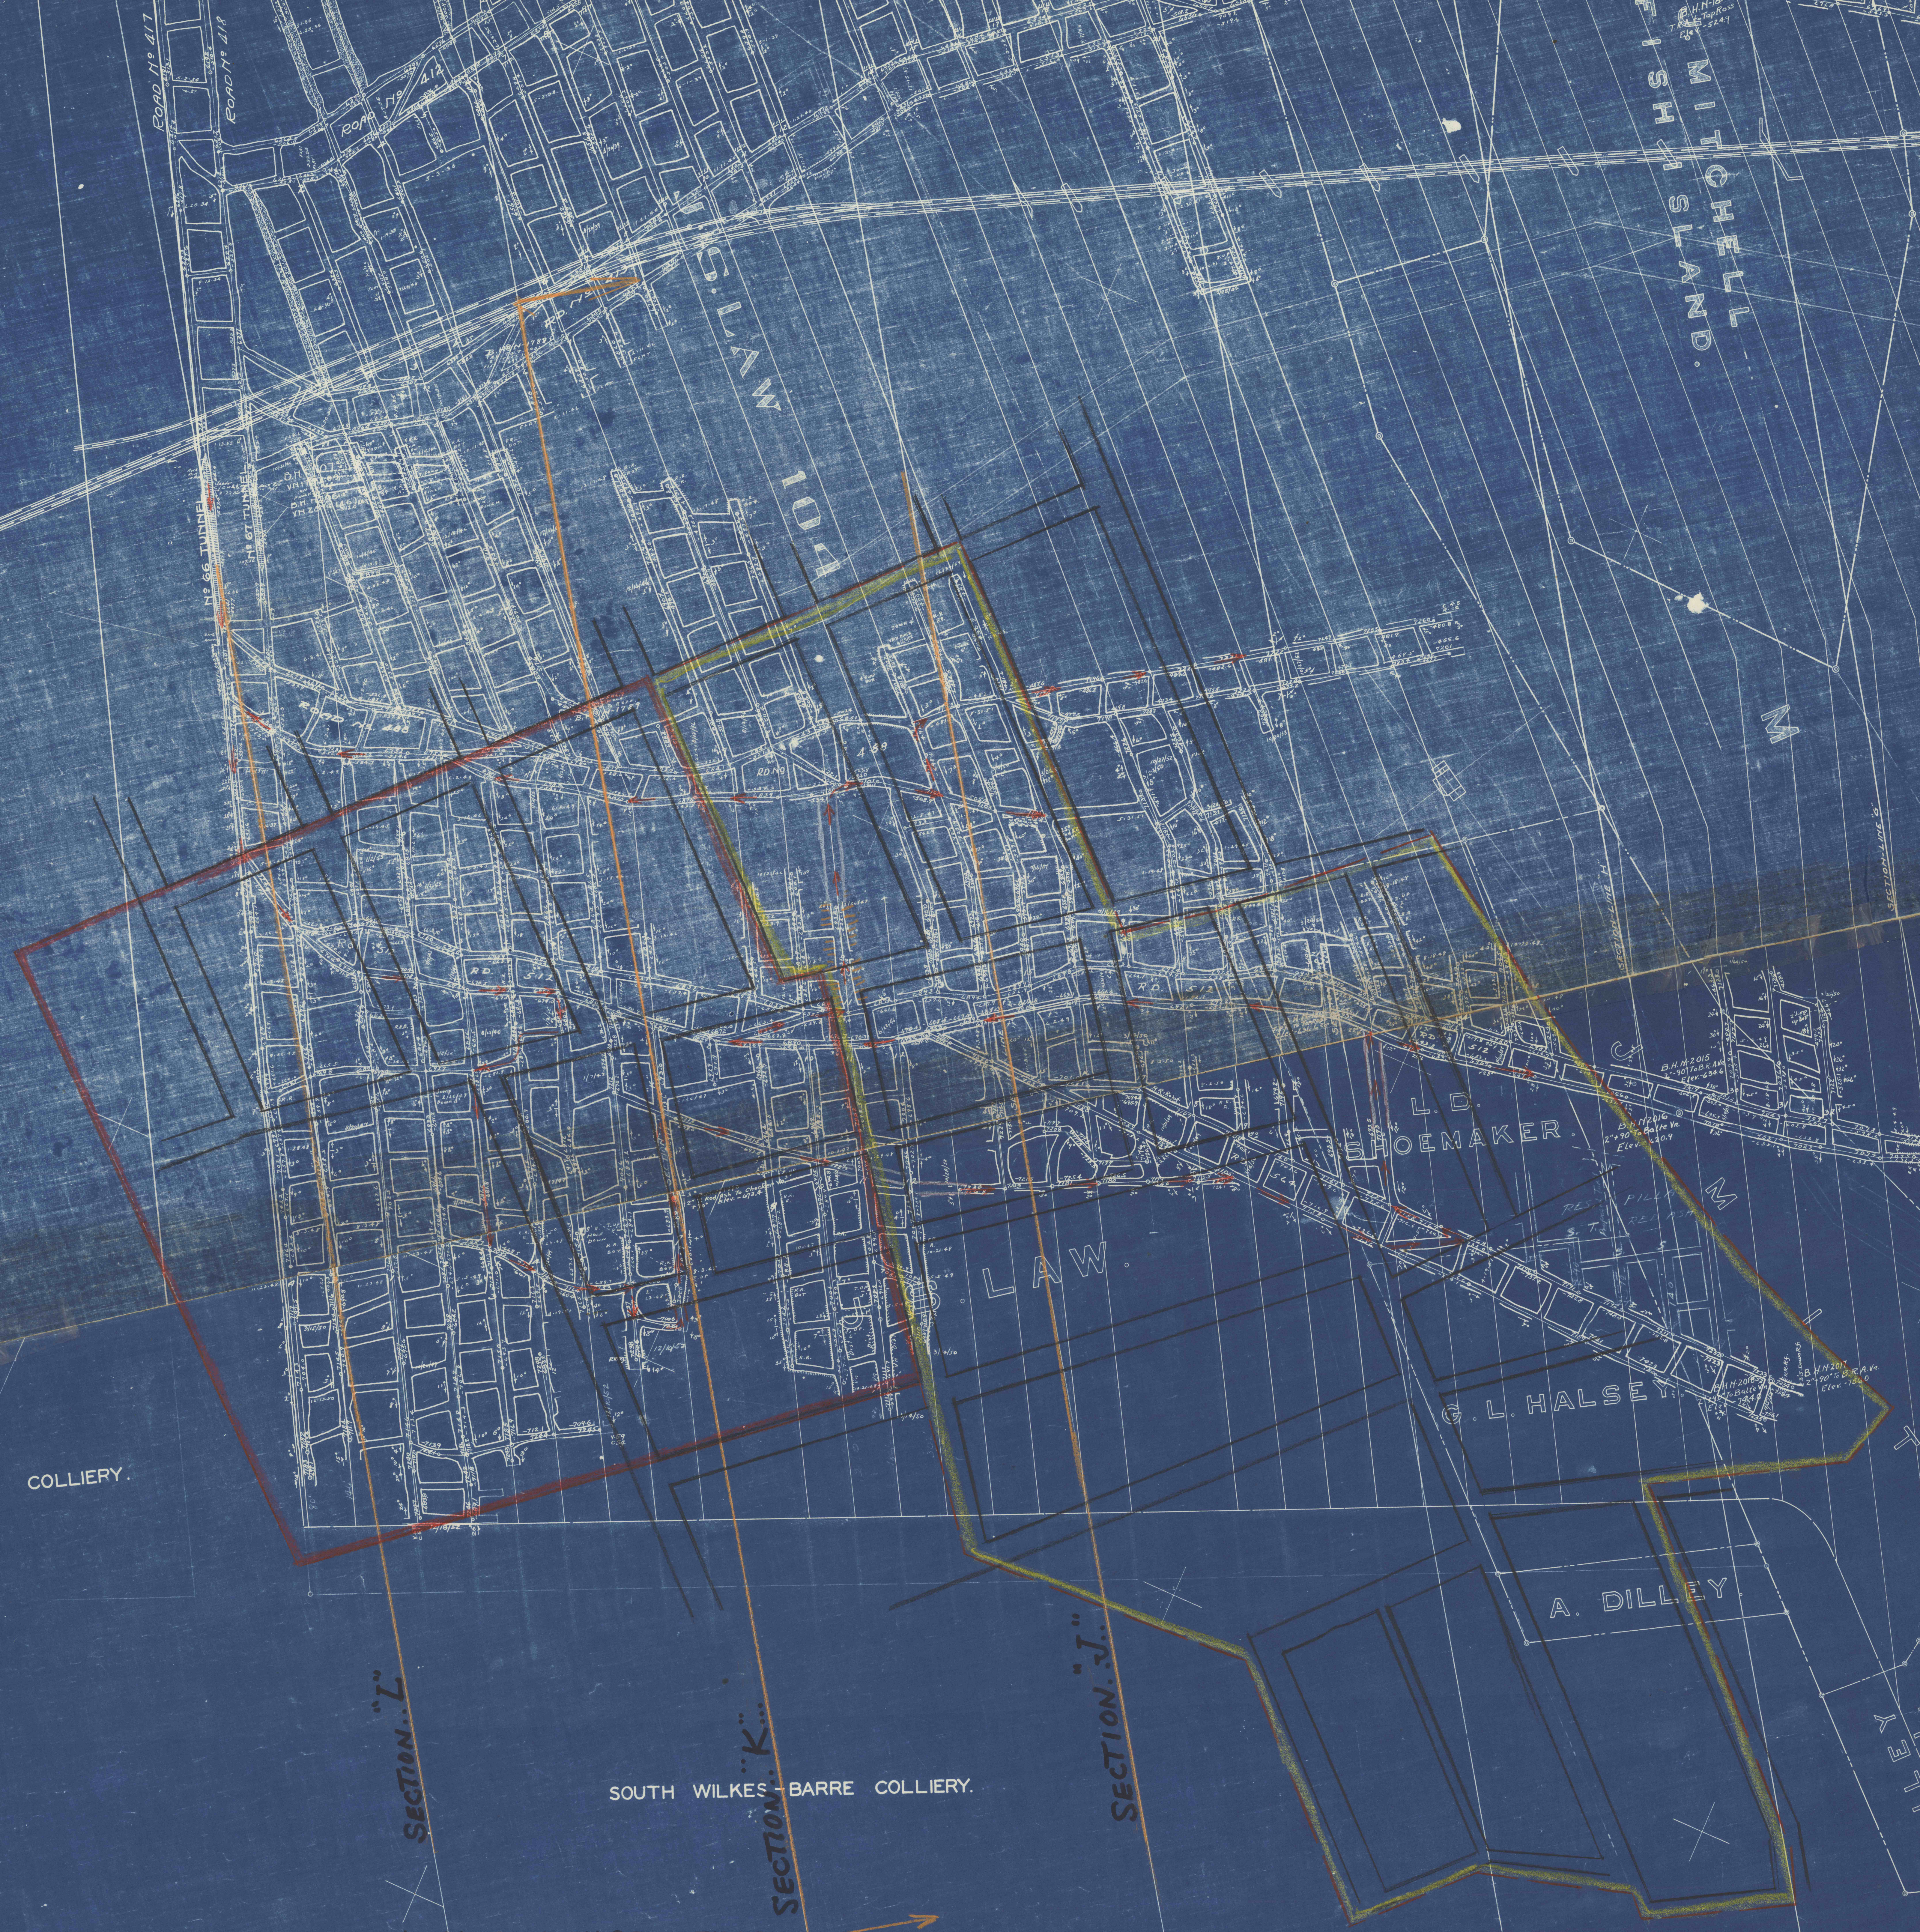

MITCHELL
FISH ISLAND.

104
ST. CLAW

LAW

BAILEY

G. LOVELAND