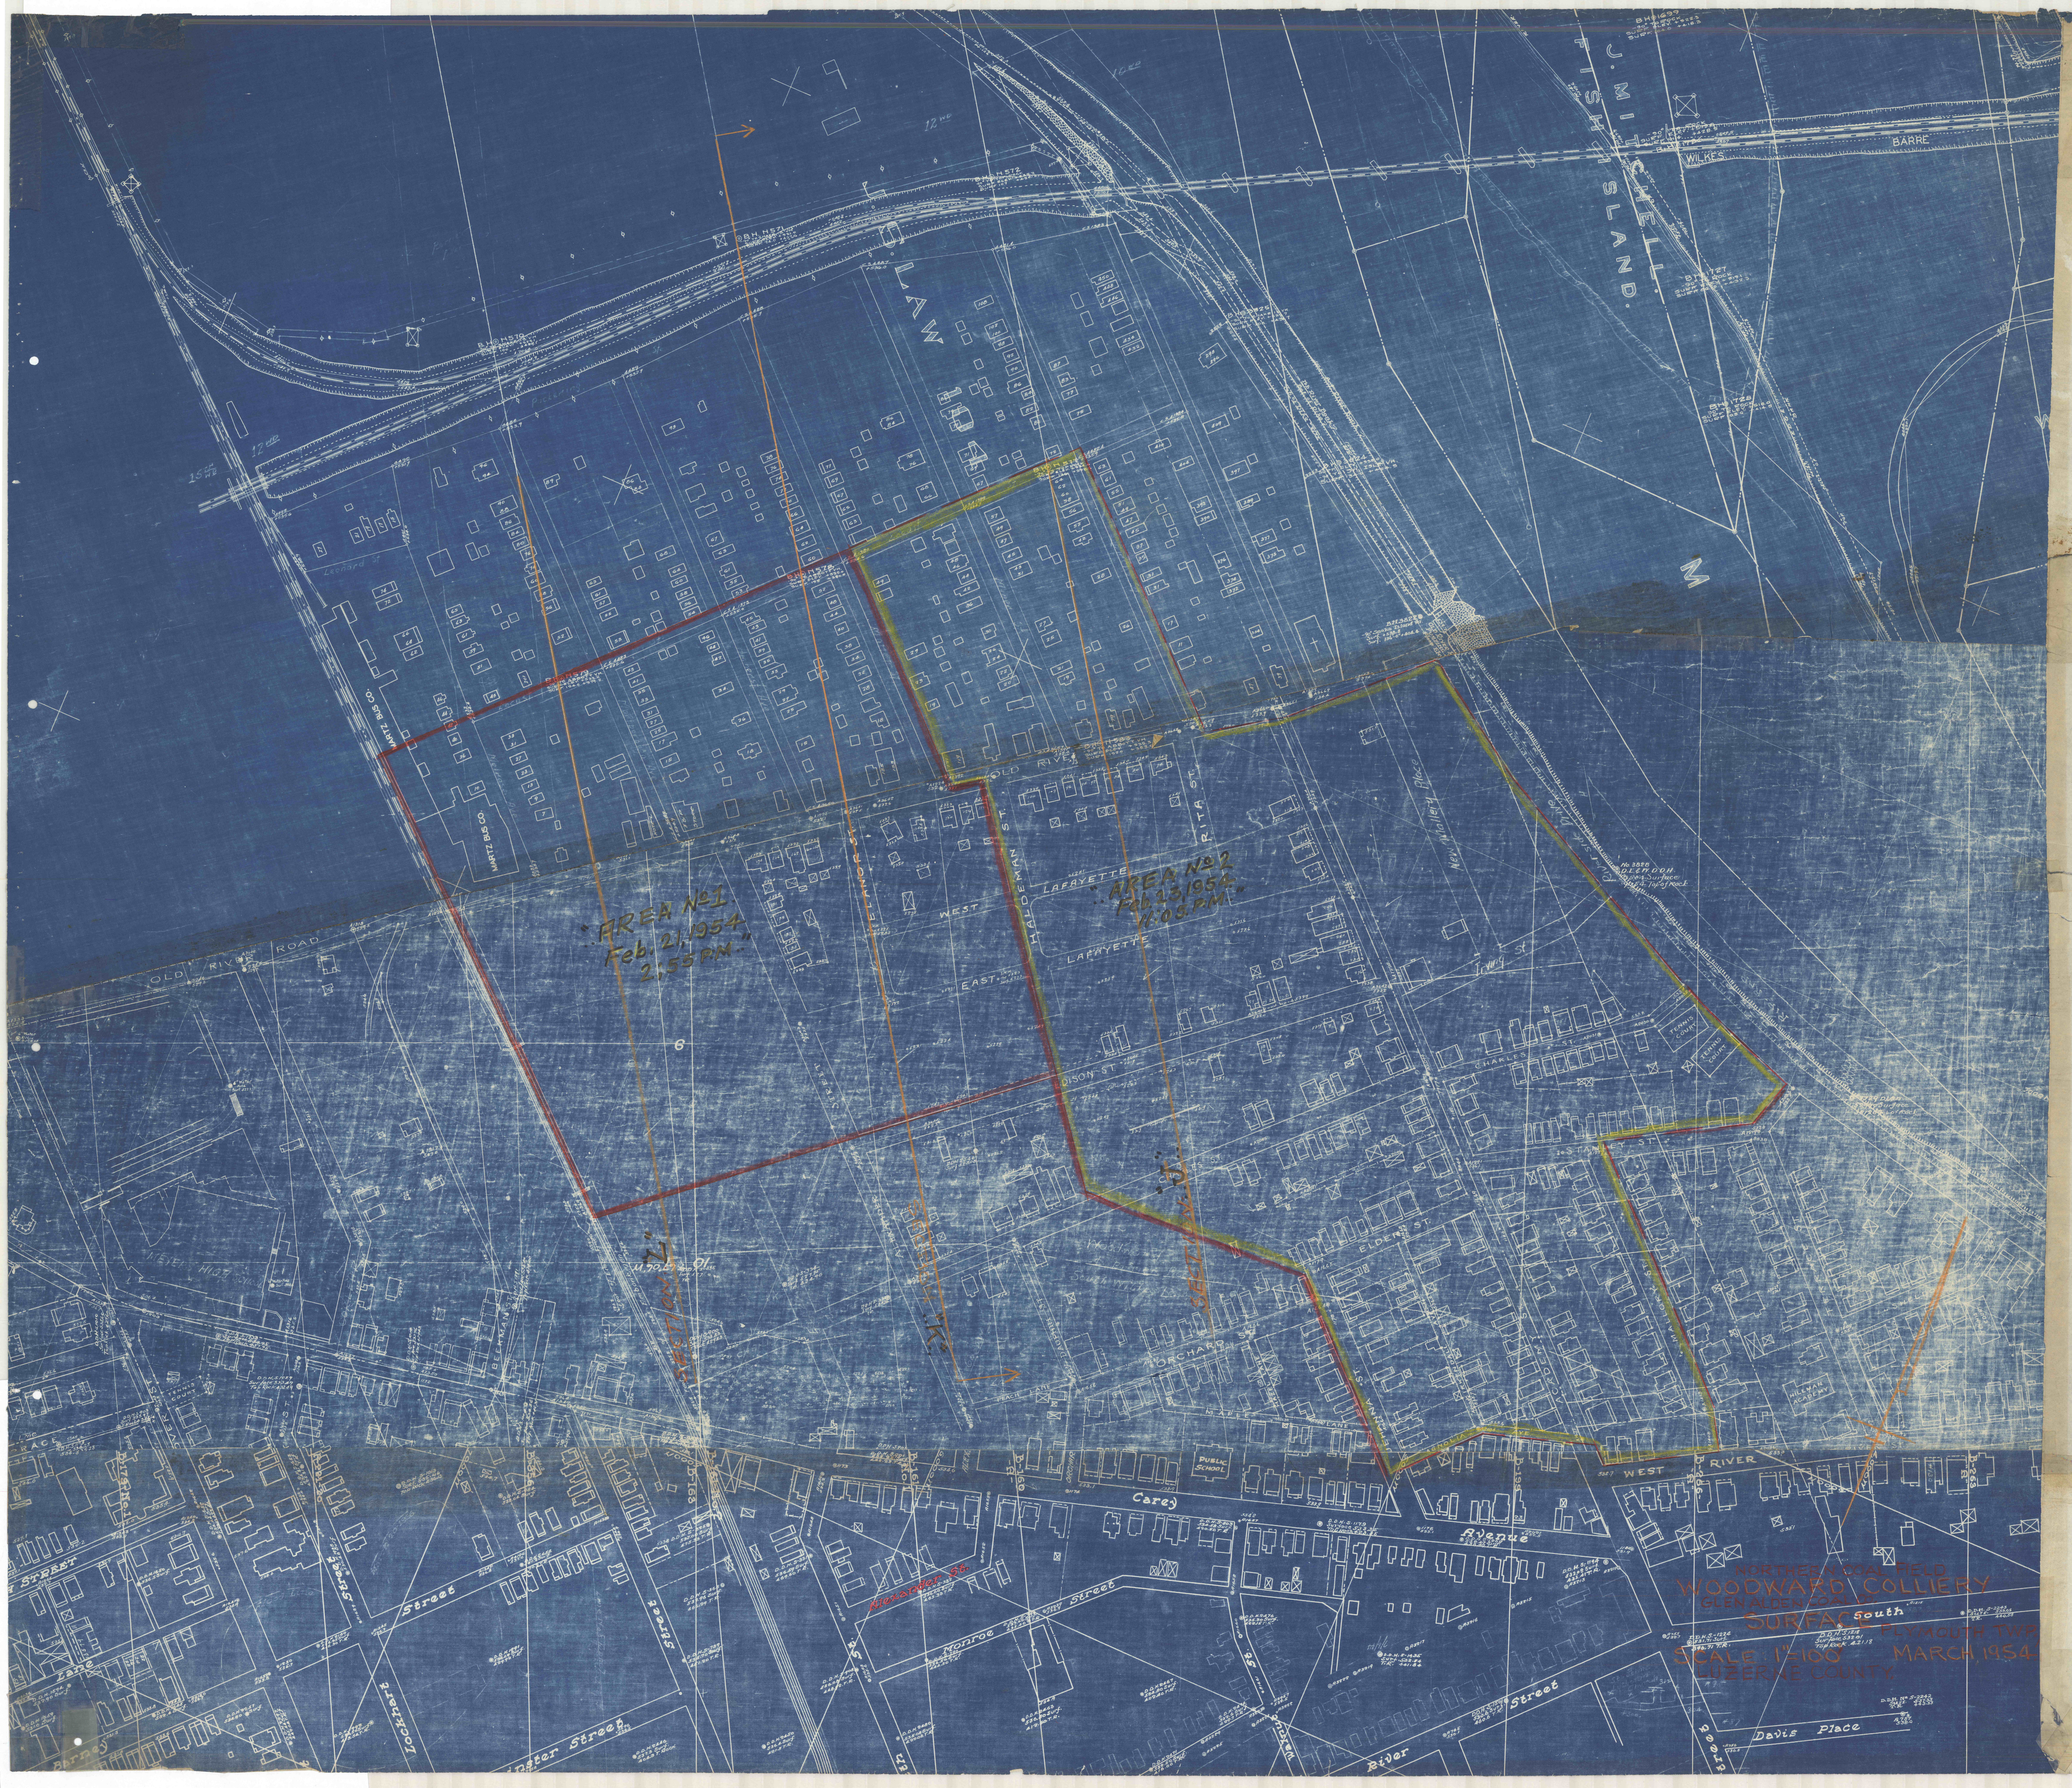

"AREA No 1
Feb. 21, 1954
2:55 P.M."
"AREA No 2
Feb. 23, 1954
11:05 P.M."
SECTION "L"
SECTION "K"
SECTION "J"
J. MITCHELL
FISH ISLAND
LAW 104
M
WILKES
BARRE
MARTZ BUS CO.
Leonard St
Pickering St
OLD RIVER ROAD
WEST LAFAYETTE
EAST LAFAYETTE
ELEANOR ST.
HALDEMAN ST.
RITA ST.
EDISON ST.
CHARLES ST.
STANLEY ST.
ELDER ST.
ORCHARD ST.
PEACH LANE
MAPLE LANE
MAGNOLIA AVE.
ACADEMY ST.
DAUPHIN ST.
New Mallery Place
River Side Drive
Irving St
TENNIS COURT
HILLMAN ACADEMY
PUBLIC SCHOOL
MEYERS HIGH SCHOOL
BEEKMAN ST.
Carey Avenue
WEST RIVER
Alexander St.
Monroe Street
Lockhart Street
Street
Lane
Barney
Davis Place
River
B.H. 1699
B.H. 1727
B.H. 1728
B.H. 3822
B.H. 3824
B.H. 3825
B.H. H571
B.H. H572
B.H. H576
B.H. H579
No. 3828 D.L.&W. D.D.H.
Surface
Top of Rock
6
12 WD
15 WD

NORTHERN COAL FIELD
WOODWARD COLLIERY
GLEN ALDEN COAL CO.
SURFACE
PLYMOUTH TWP.
SCALE 1"=100'
MARCH 1954
LUZERNE COUNTY