


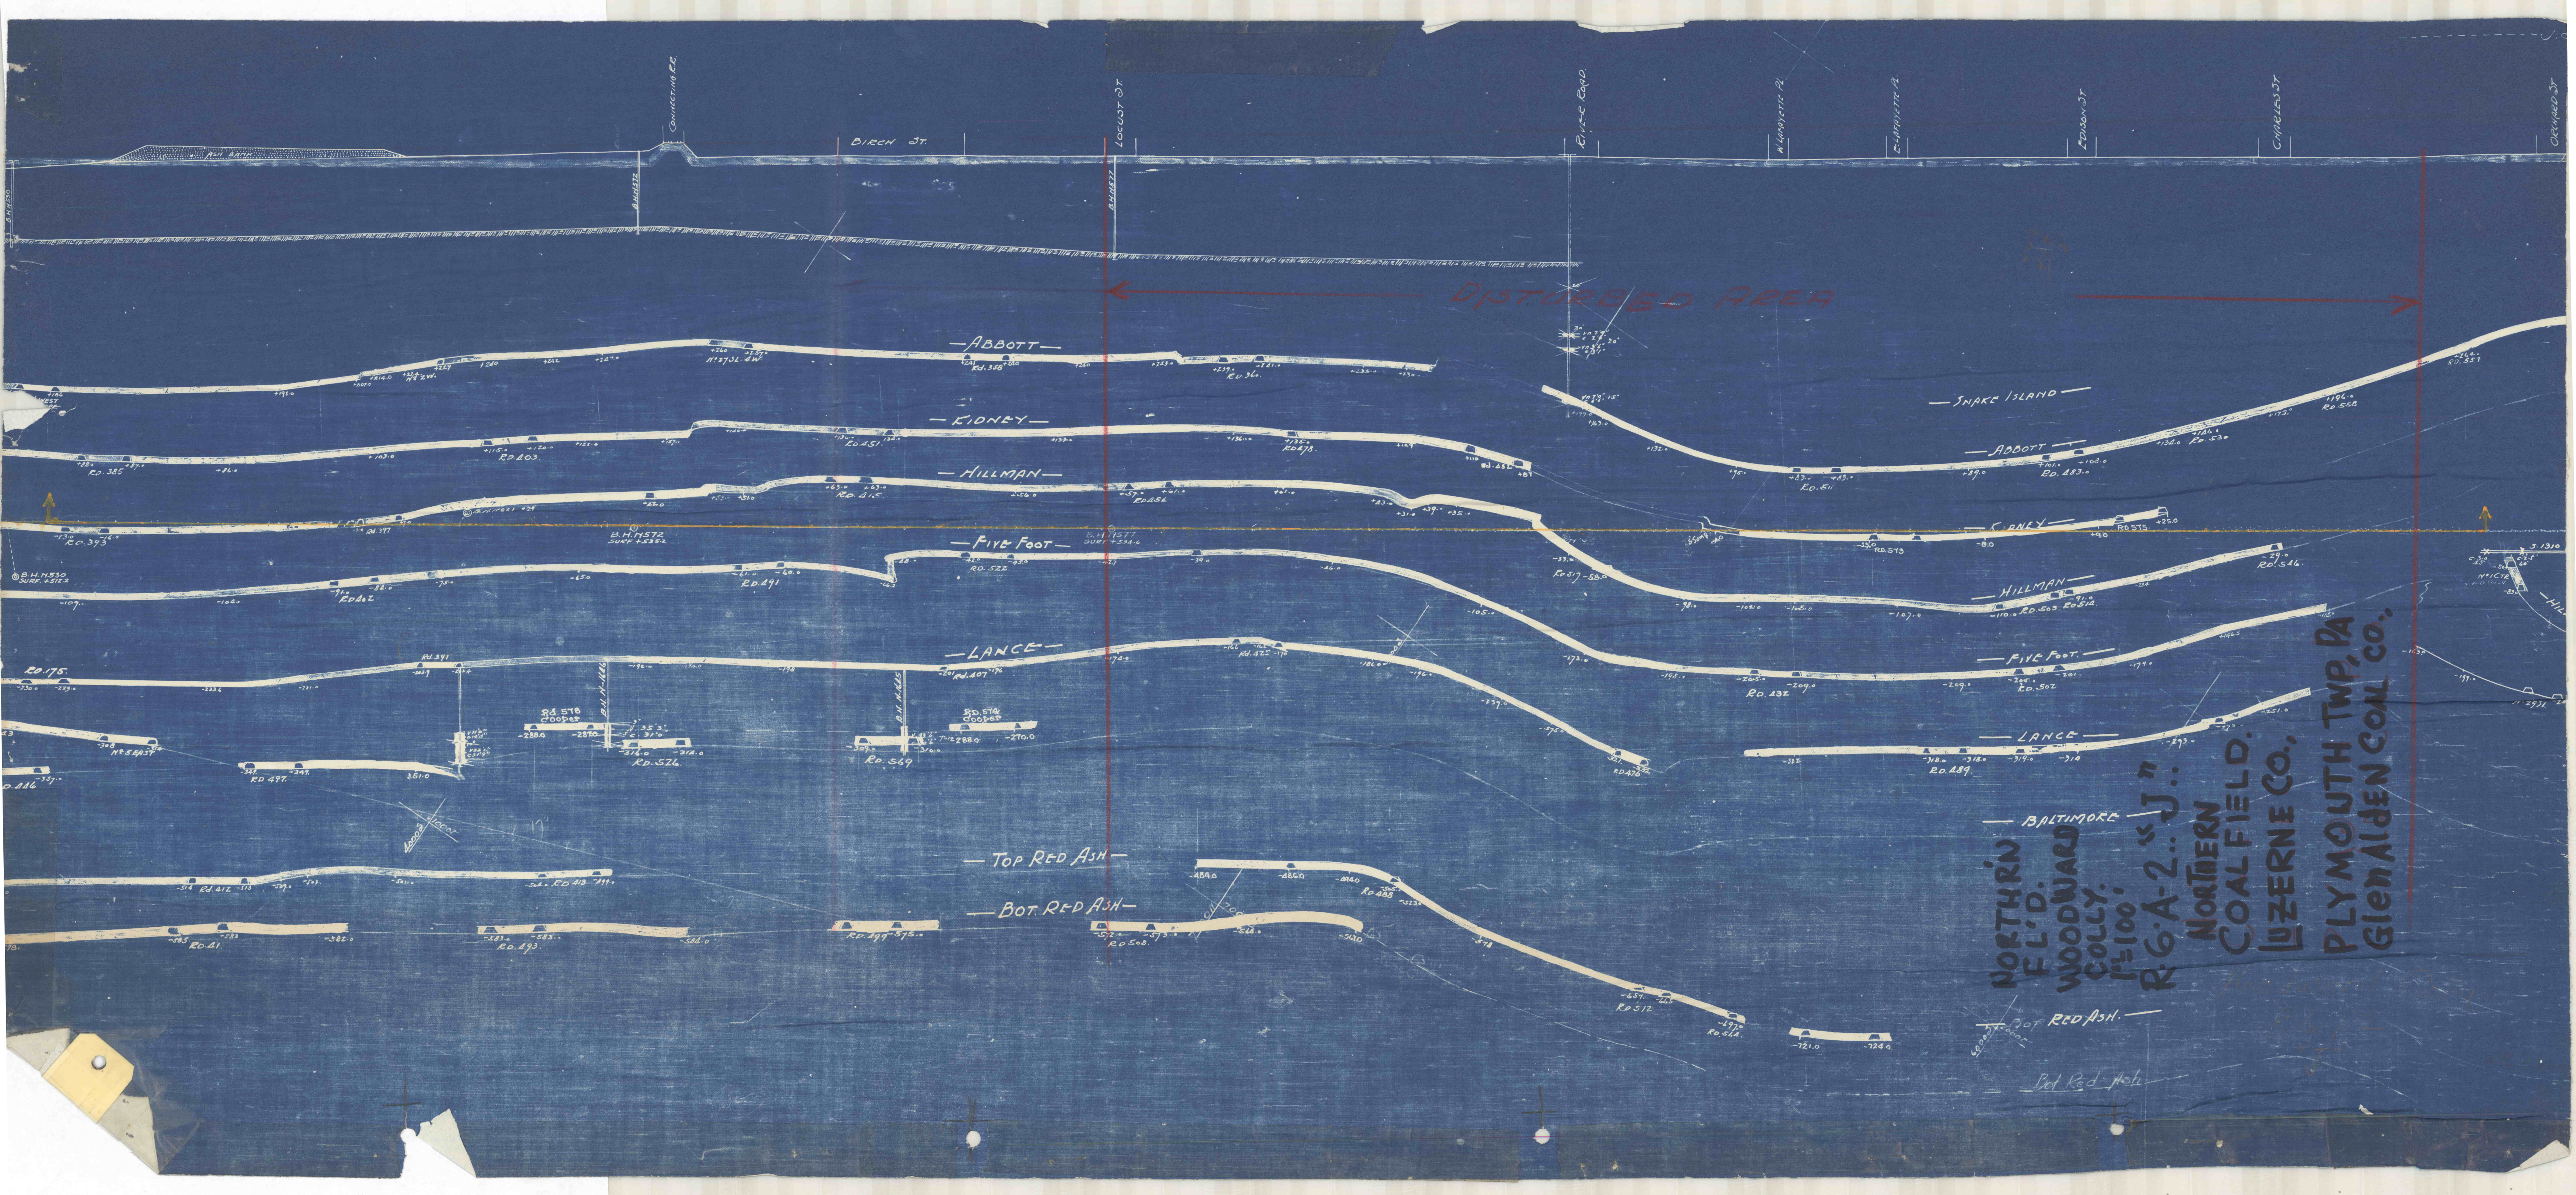

DISTURBED AREA

ABBOTT

KIDNEY

HILLMAN

FIVE FOOT

LANCE

TOP RED ASH

BOT. RED ASH

SNAKE ISLAND

ABBOTT

KIDNEY

HILLMAN

FIVE FOOT

LANCE

BALTIMORE

W.D. WOODWARD

COLLY.

R. 100.

R. 6-A-2 "J"

NORTHERN

COAL FIELD.

LUZERNE CO.

PLYMOUTH TWP, PA

GLEN ALDEN COAL CO.