


LANCE

COLLIERY

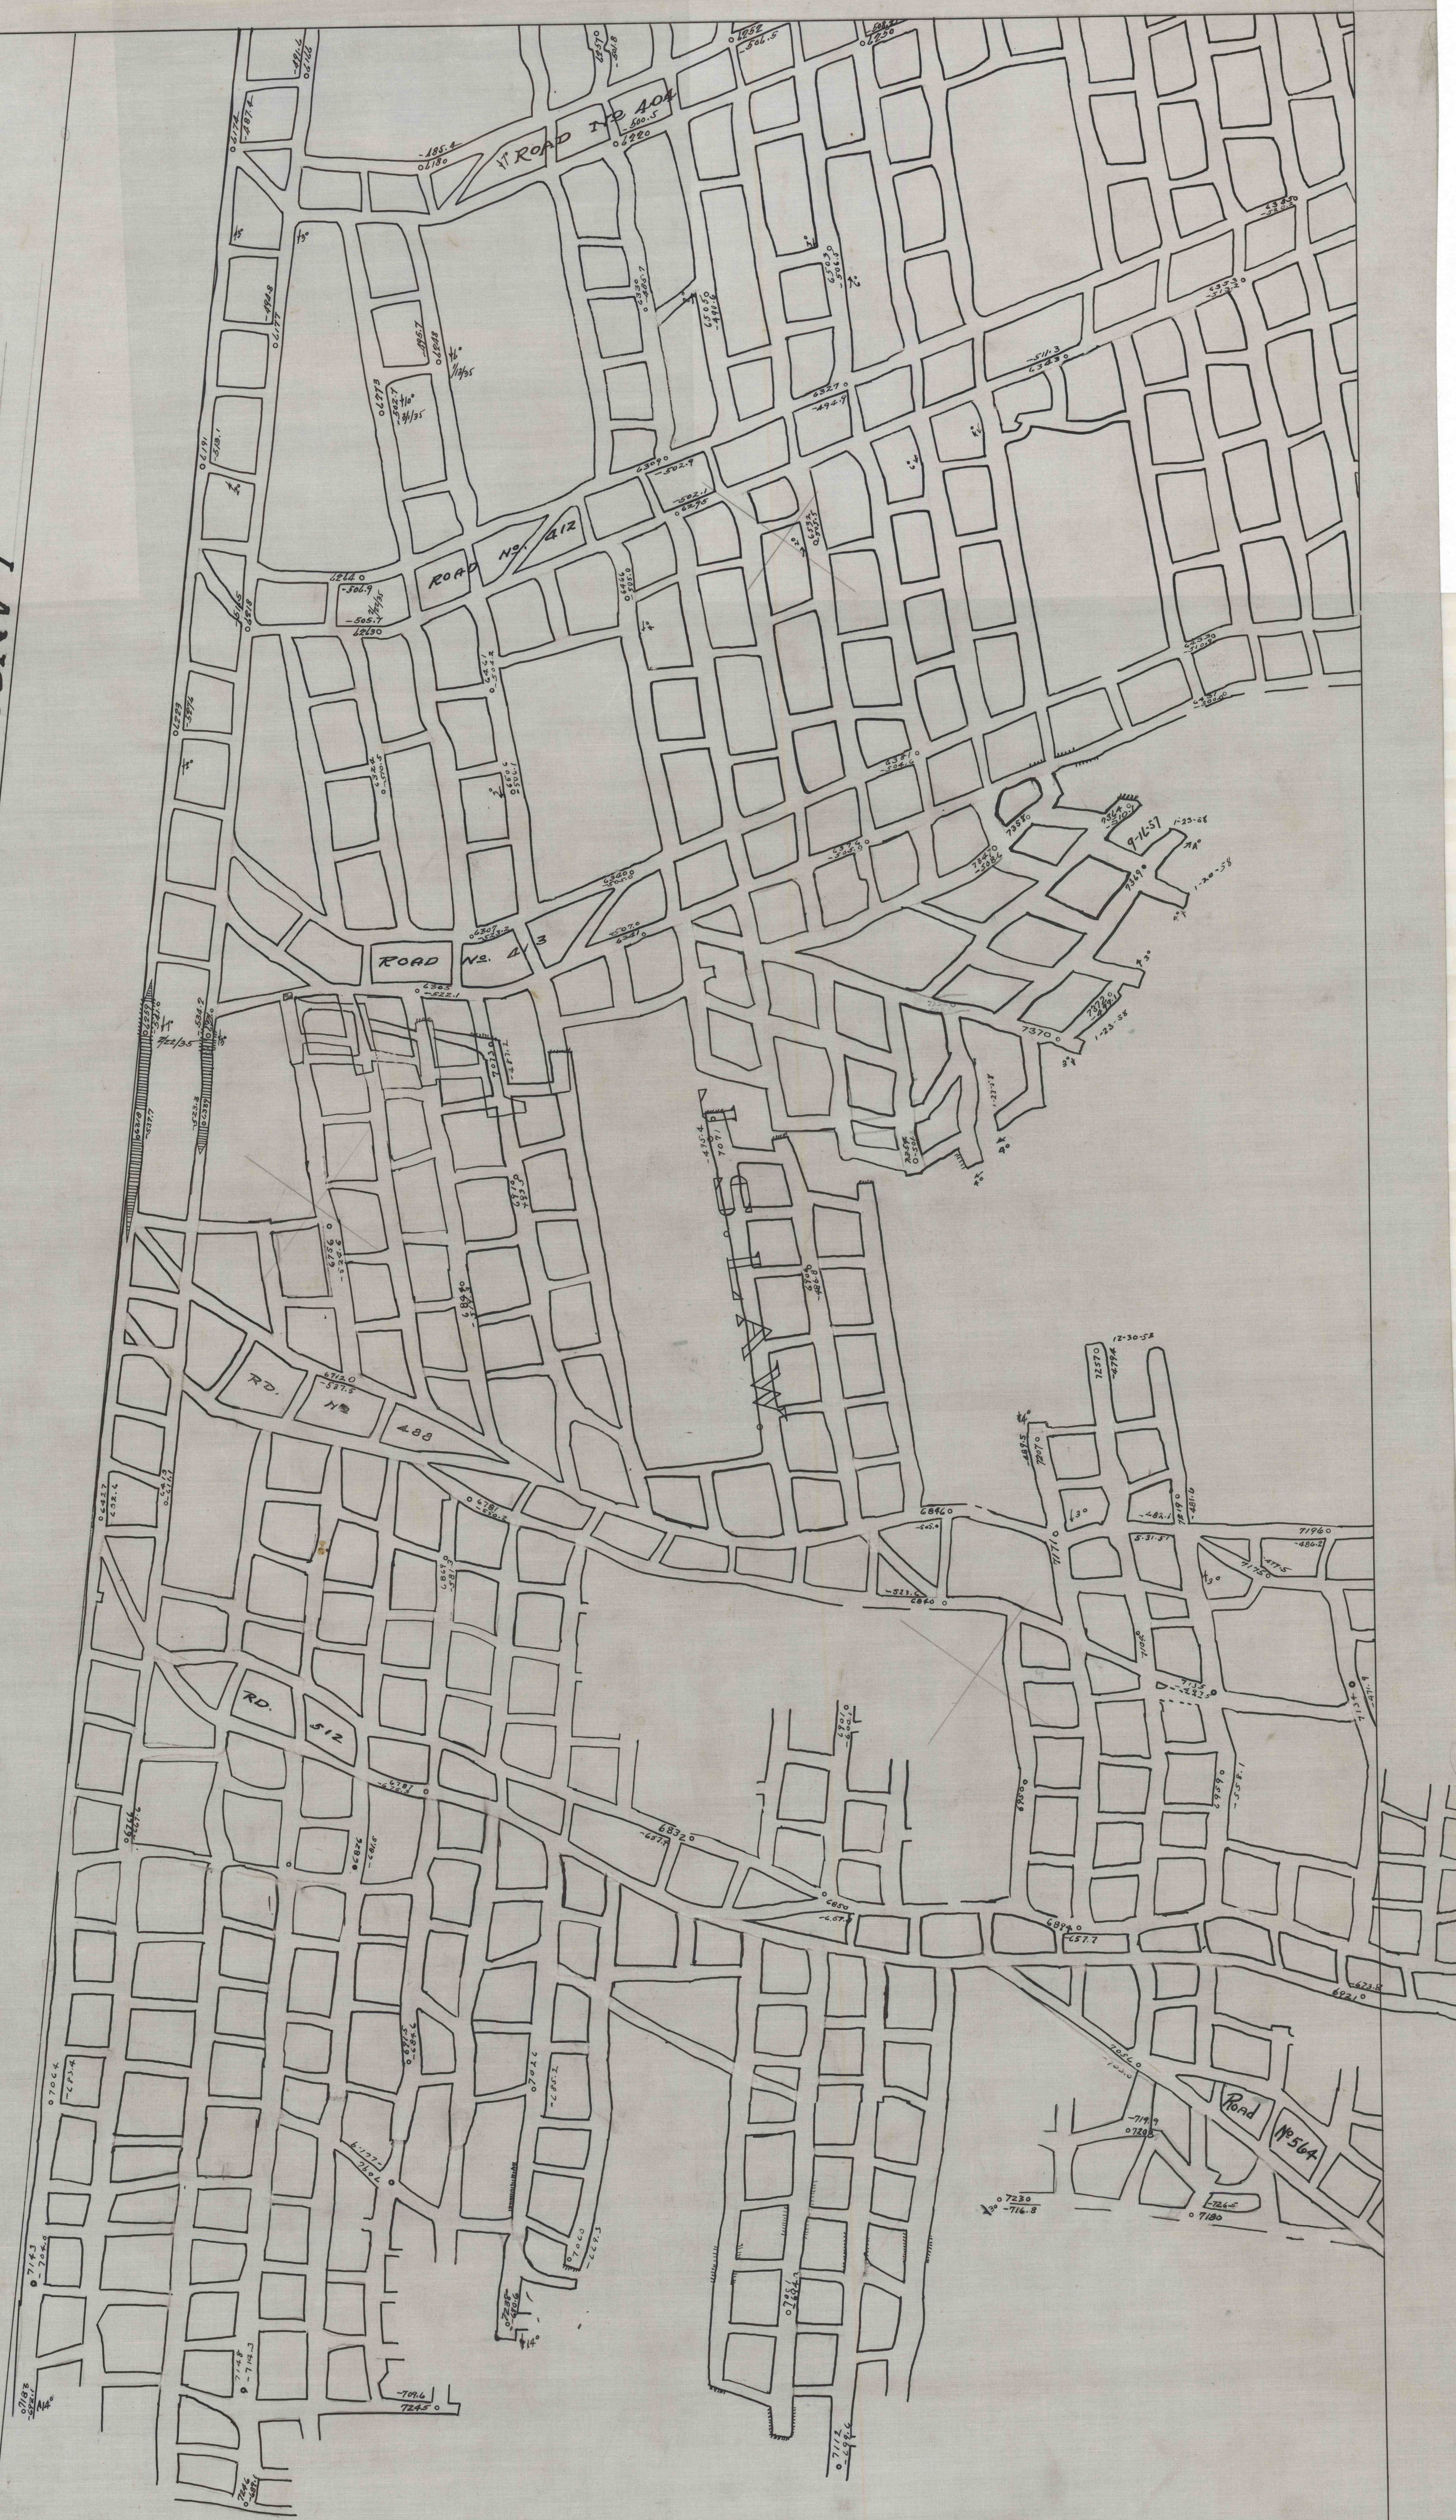

INSPECTORS MAP
NORTHERN COAL FIELD...
WOODWARD MINE
LUZERNE COUNTY, PLYMOUTH TWP., PA.
TOP RED ASH VEIN

SCALE 1" = 100' 30P 3.

- | | |
|----------------------|-------------------------|
| Posted April 6, 1935 | POSTED - APRIL 12, 1941 |
| " June 10, 1936 | " - FEB 16, 1950 |
| " Feb 20, 1938 | " " 14, 1951 |
| " April 10, 1938 | " Feb 1, 1952 |
| " April 10, 1941 | " MAR. 10, 1953 |
| " Dec 11, 1941 | " Jan. 15, 1954 |
| " Sept 11, 1942 | " Feb. 15, 1957 |
| " July 15, 1943 | " May 1, 1959 |
| " Jan 10, 1944 | " MAY 10, 1960 |
| " Oct 9, 1944 | " OCT. 21, 1960 |
| " MAR. 1, 1945 | " FEB. 6, 1961 |
| " Jan 18, 1946 | " APR. 12, 1961 |
| " Oct. 8, 1946 | |
| " AUG. 1, 1947 | |
| " JULY 26, 1947 | |