


POSTED	
APR 18 401	38
MAY 8 403	1
MAY 1 405	1
MAY 8 406	1
MAY 24 407	1
MAY 3 408	1
MAY 10 409	1
MAY 17 410	1
MAY 24 411	1
MAY 31 412	1
MAY 31 413	1
MAR 10 1972

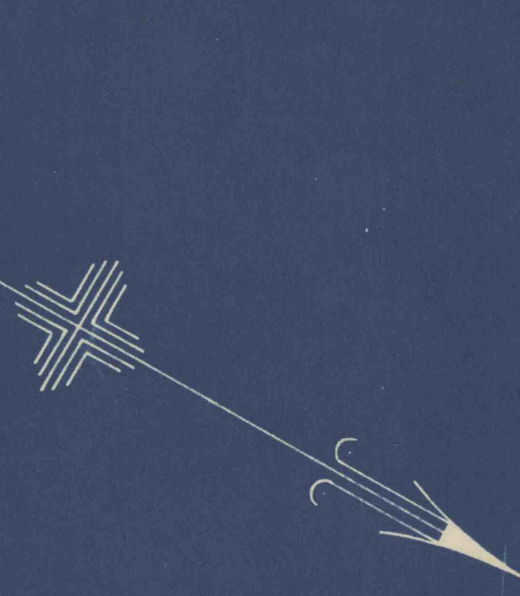

SOUTH WILKES-BARRE COLLIERY

INDIVIDUALS

RIVER COMMON

BRIDGE

LEHIGH VALLEY COAL CO.

LANCE COLLIERY

HUDSON COAL CO.

HUDSON COAL CO.

KINGSTON COAL CO.

KINGSTON COAL CO.

CO.

WATERBURY COAL FIELD
WOODWARD COLLIERY
BOTTOM RED ASH VEIN, LUSHERNE COUNTY,
SCALE, 1 INCH=400 FEET. PLYMOUTH TWP. PA.