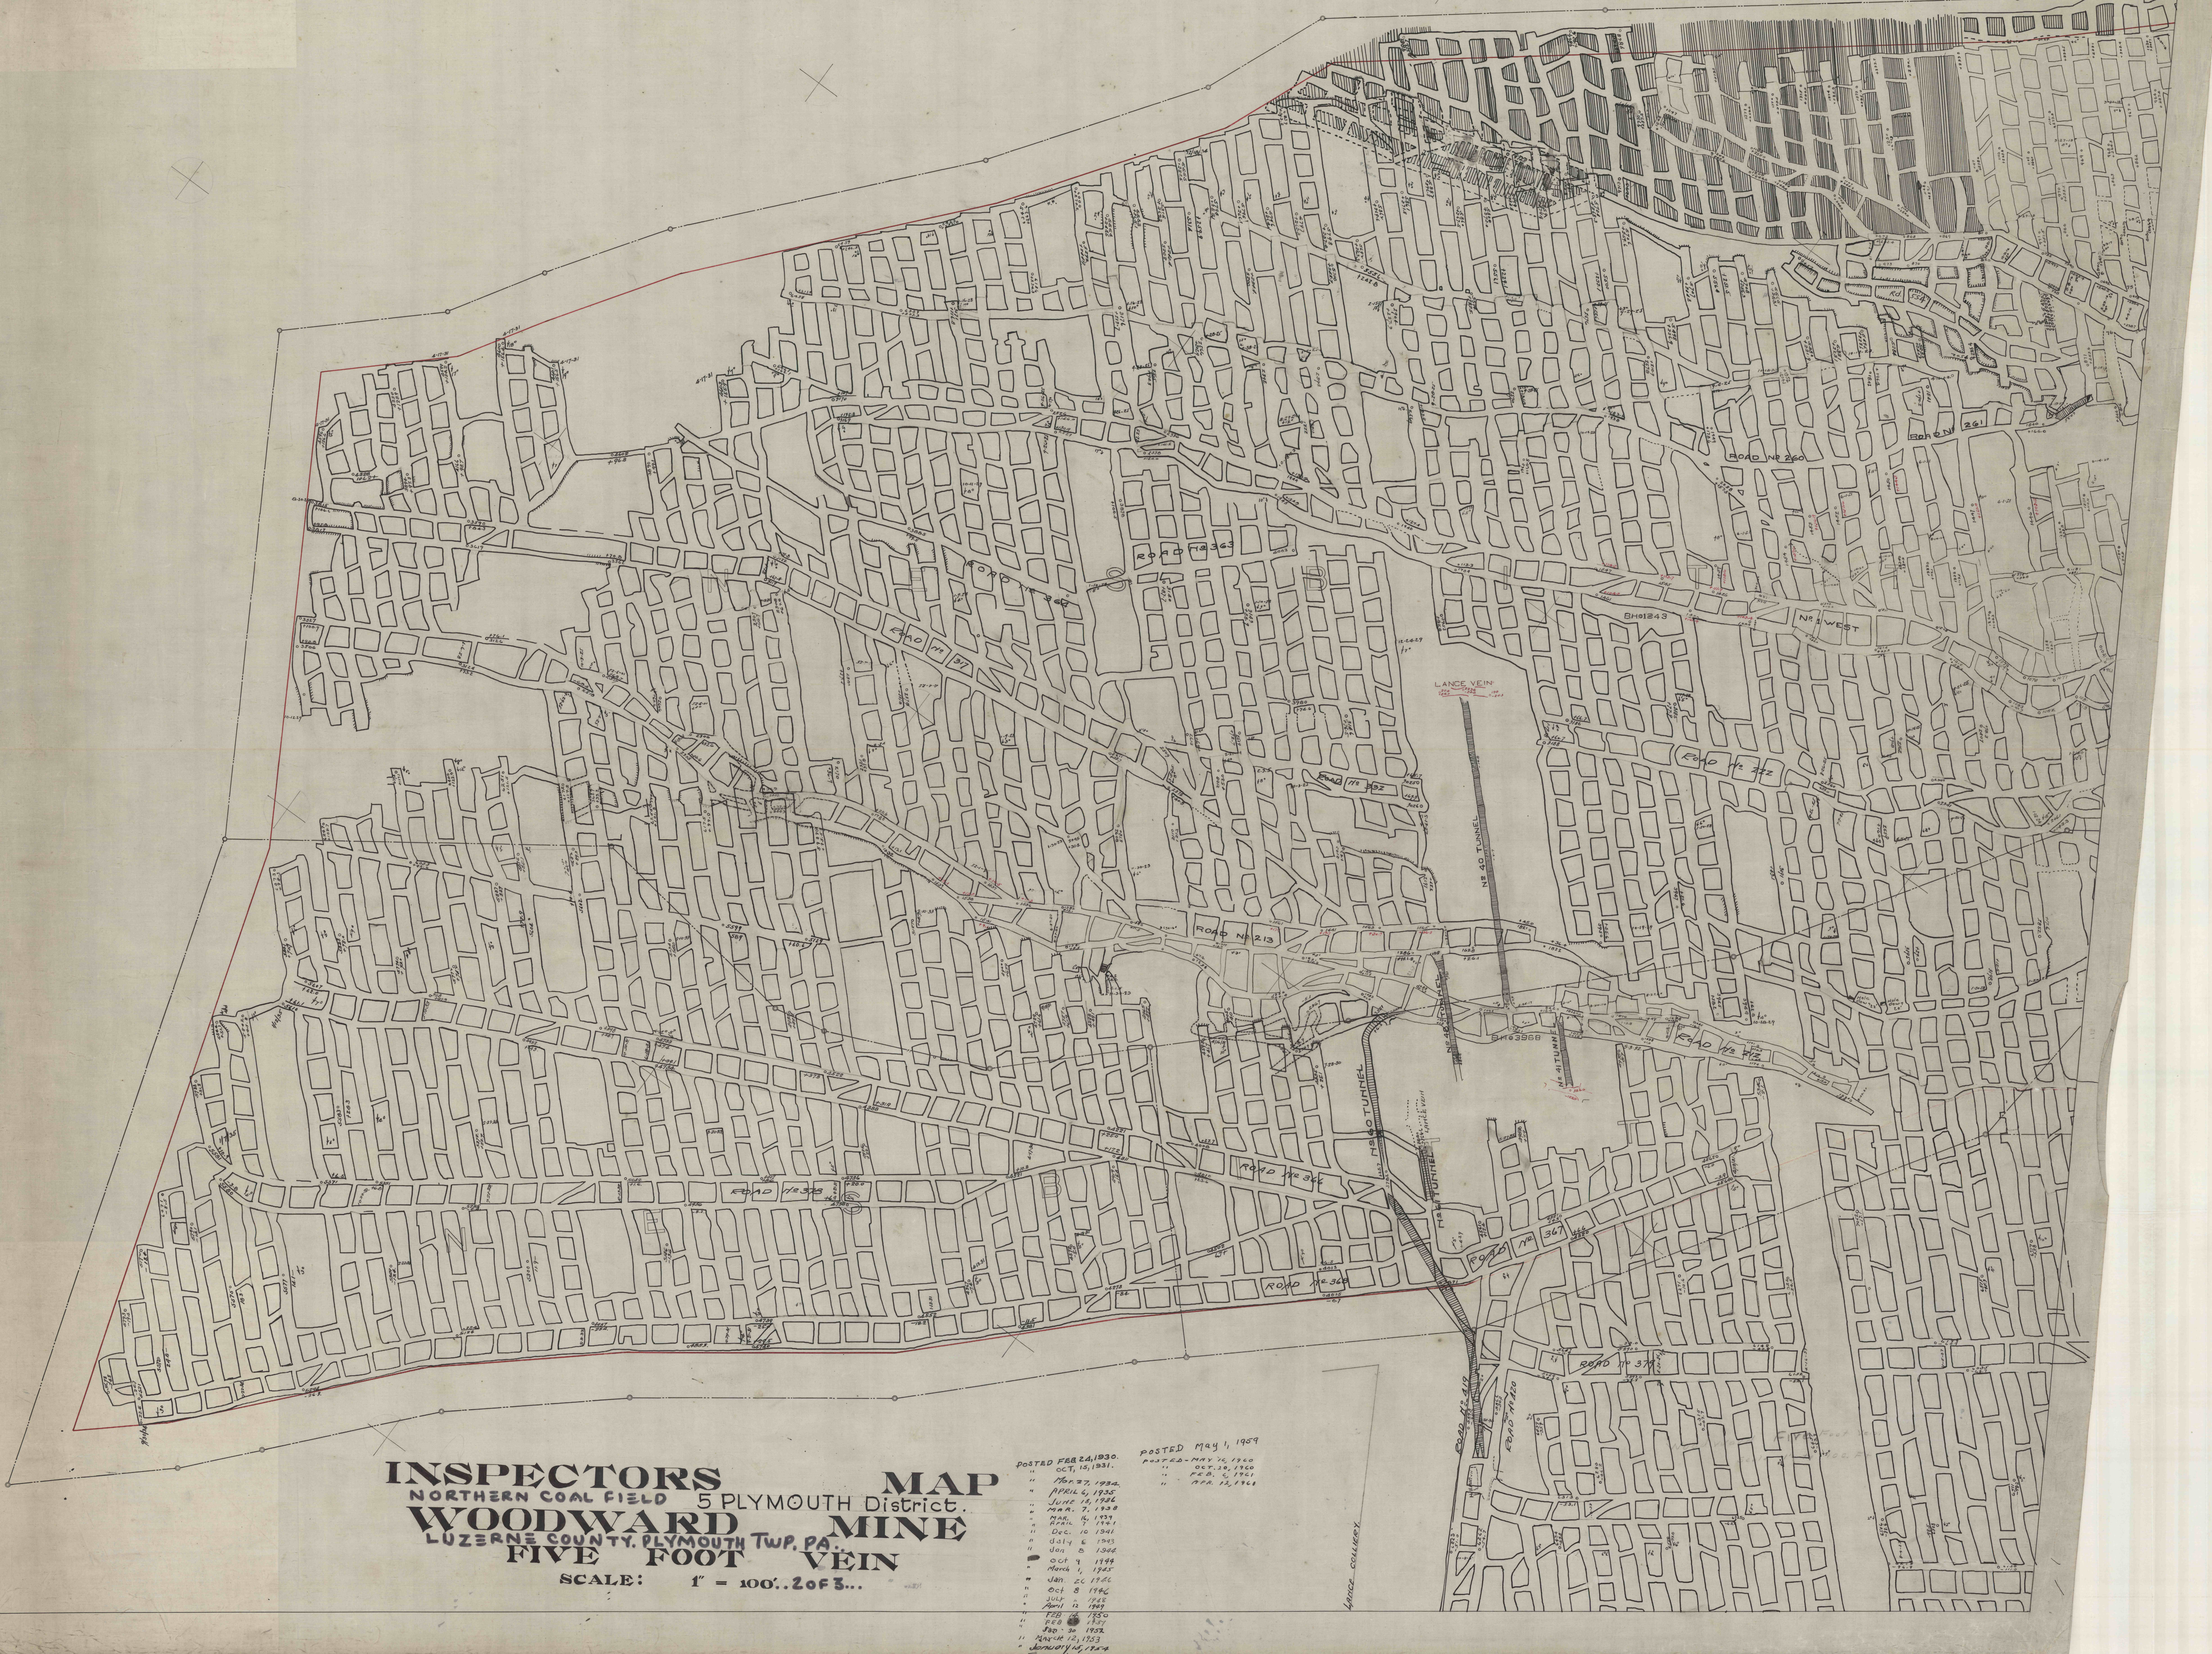

INSPECTORS MAP

NORTHERN COAL FIELD 5 PLYMOUTH District.

WOODWARD MINE

LUZERNE COUNTY. PLYMOUTH TWP. PA..

FIVE FOOT VEIN

SCALE: 1" = 100'.. 2 OF 3...

POSTED FEB 24, 1930.
" OCT, 15, 1931.
" Mar. 27, 1934.
" APRIL 6, 1935
" JUNE 18, 1936
" MAR. 7, 1938
" MAR. 16, 1939
" APRIL 7 1941
" Dec. 10 1941
" July 6 1943
" Jan 8 1944
Oct 9 1944
" March 1, 1945
" Jan. 26 1946
" Oct 8 1946
" JULY " 1948
" April 12 1949
" FEB 14 1950
" FEB 28 1951
" Jan 30 1952
" MARCH 12, 1953
" January 15, 1954

POSTED May 1, 1959
POSTED - MAY 16, 1960
" OCT. 20, 1960
" FEB. 6, 1961
" APR. 12, 1961